


s.s. "Aldborough":
Greenock Rept. No. 9540

Proposed arrangement of Pauting Beams

— J.S. 187. —

Scale $\frac{1}{4}$ inch = one foot

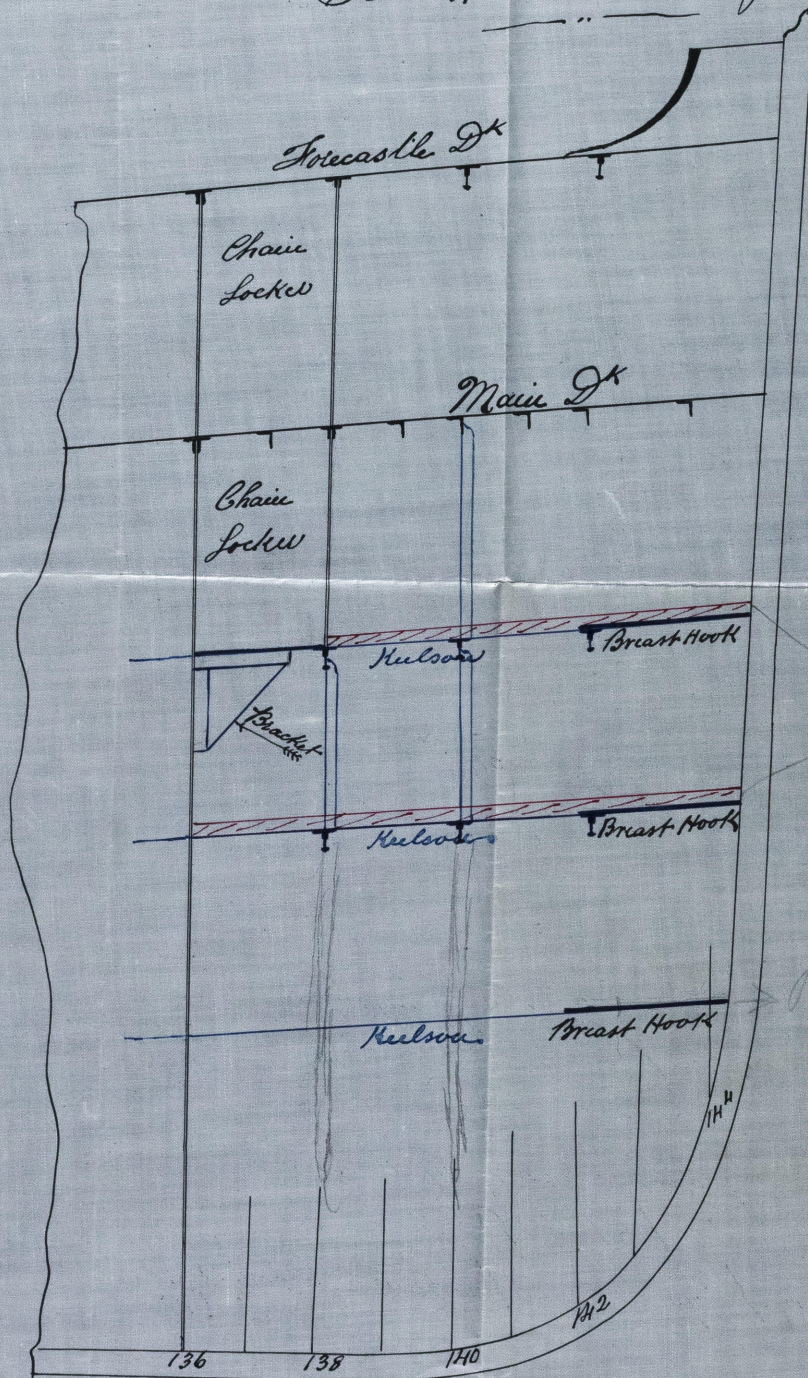

Stringer plates
increased to 24 lbs
in breadst

Minor Keelson
light forward



© 2021

Lloyd's Register
Foundation

GRK308-088