

Lloyd's Register of British and Foreign Shipping.

(Report on Vessel No. 9560 Port Greenock)

No. 1509.

SHIP FORGINGS OR CASTINGS.

I have to report that the undermentioned Iron or Steel Forgings or Castings, manufactured by The Portland Forge Co. of Kilmarnock. for the Vessel No. 149, being built by Messrs Russell & Co. of Port Glasgow. have been inspected by me as set forth below, and found to be, so far as can be seen, sound and efficient.

The words FORGINGS or CASTINGS, IRON or STEEL, should be struck out as may be required.

Mark on Forgings.


Lloyd's
No. 1509
G.N.

George Newcomb.
Glasgow.

1/6/88.

	STERN FRAME.	RUDDER FRAME.	STEM.
Material* - - - -	/	Scrap iron.	/
How made - - - -		Forged.	
Dimensions - - - -		6 3/4 & 3 1/2.	
Progress on Inspection -		Forging & smithing	
Dates when Inspected		21.28/10/87. 3.10/11/87. 13/4/88. 23/5/88.	

SKETCHES OF FRAMES SHEWING POSITION AND DESCRIPTION OF WELDS OF FORGINGS, OR PARTICULARS OF TESTS APPLIED TO CASTINGS.

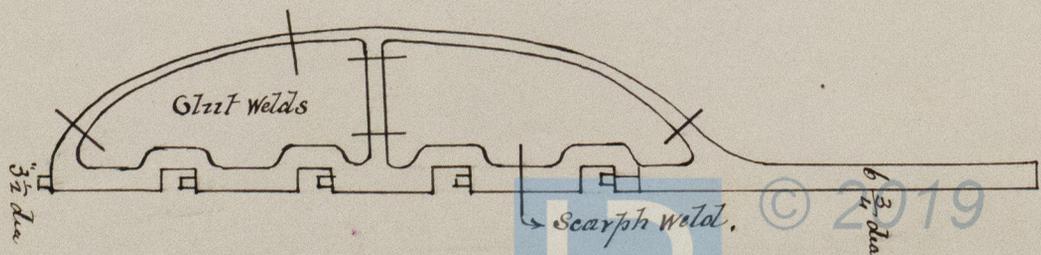

* If of Iron, state whether scrap or puddled iron.

