



8/10/87
20.10.87

MAIN DECK PLAN


SCALE 1/4 INCH=ONE FOOT.

 

LOWER DECK PLAN No 179

 


Ship "Tinto Hill"
Greenock Report. No 9560

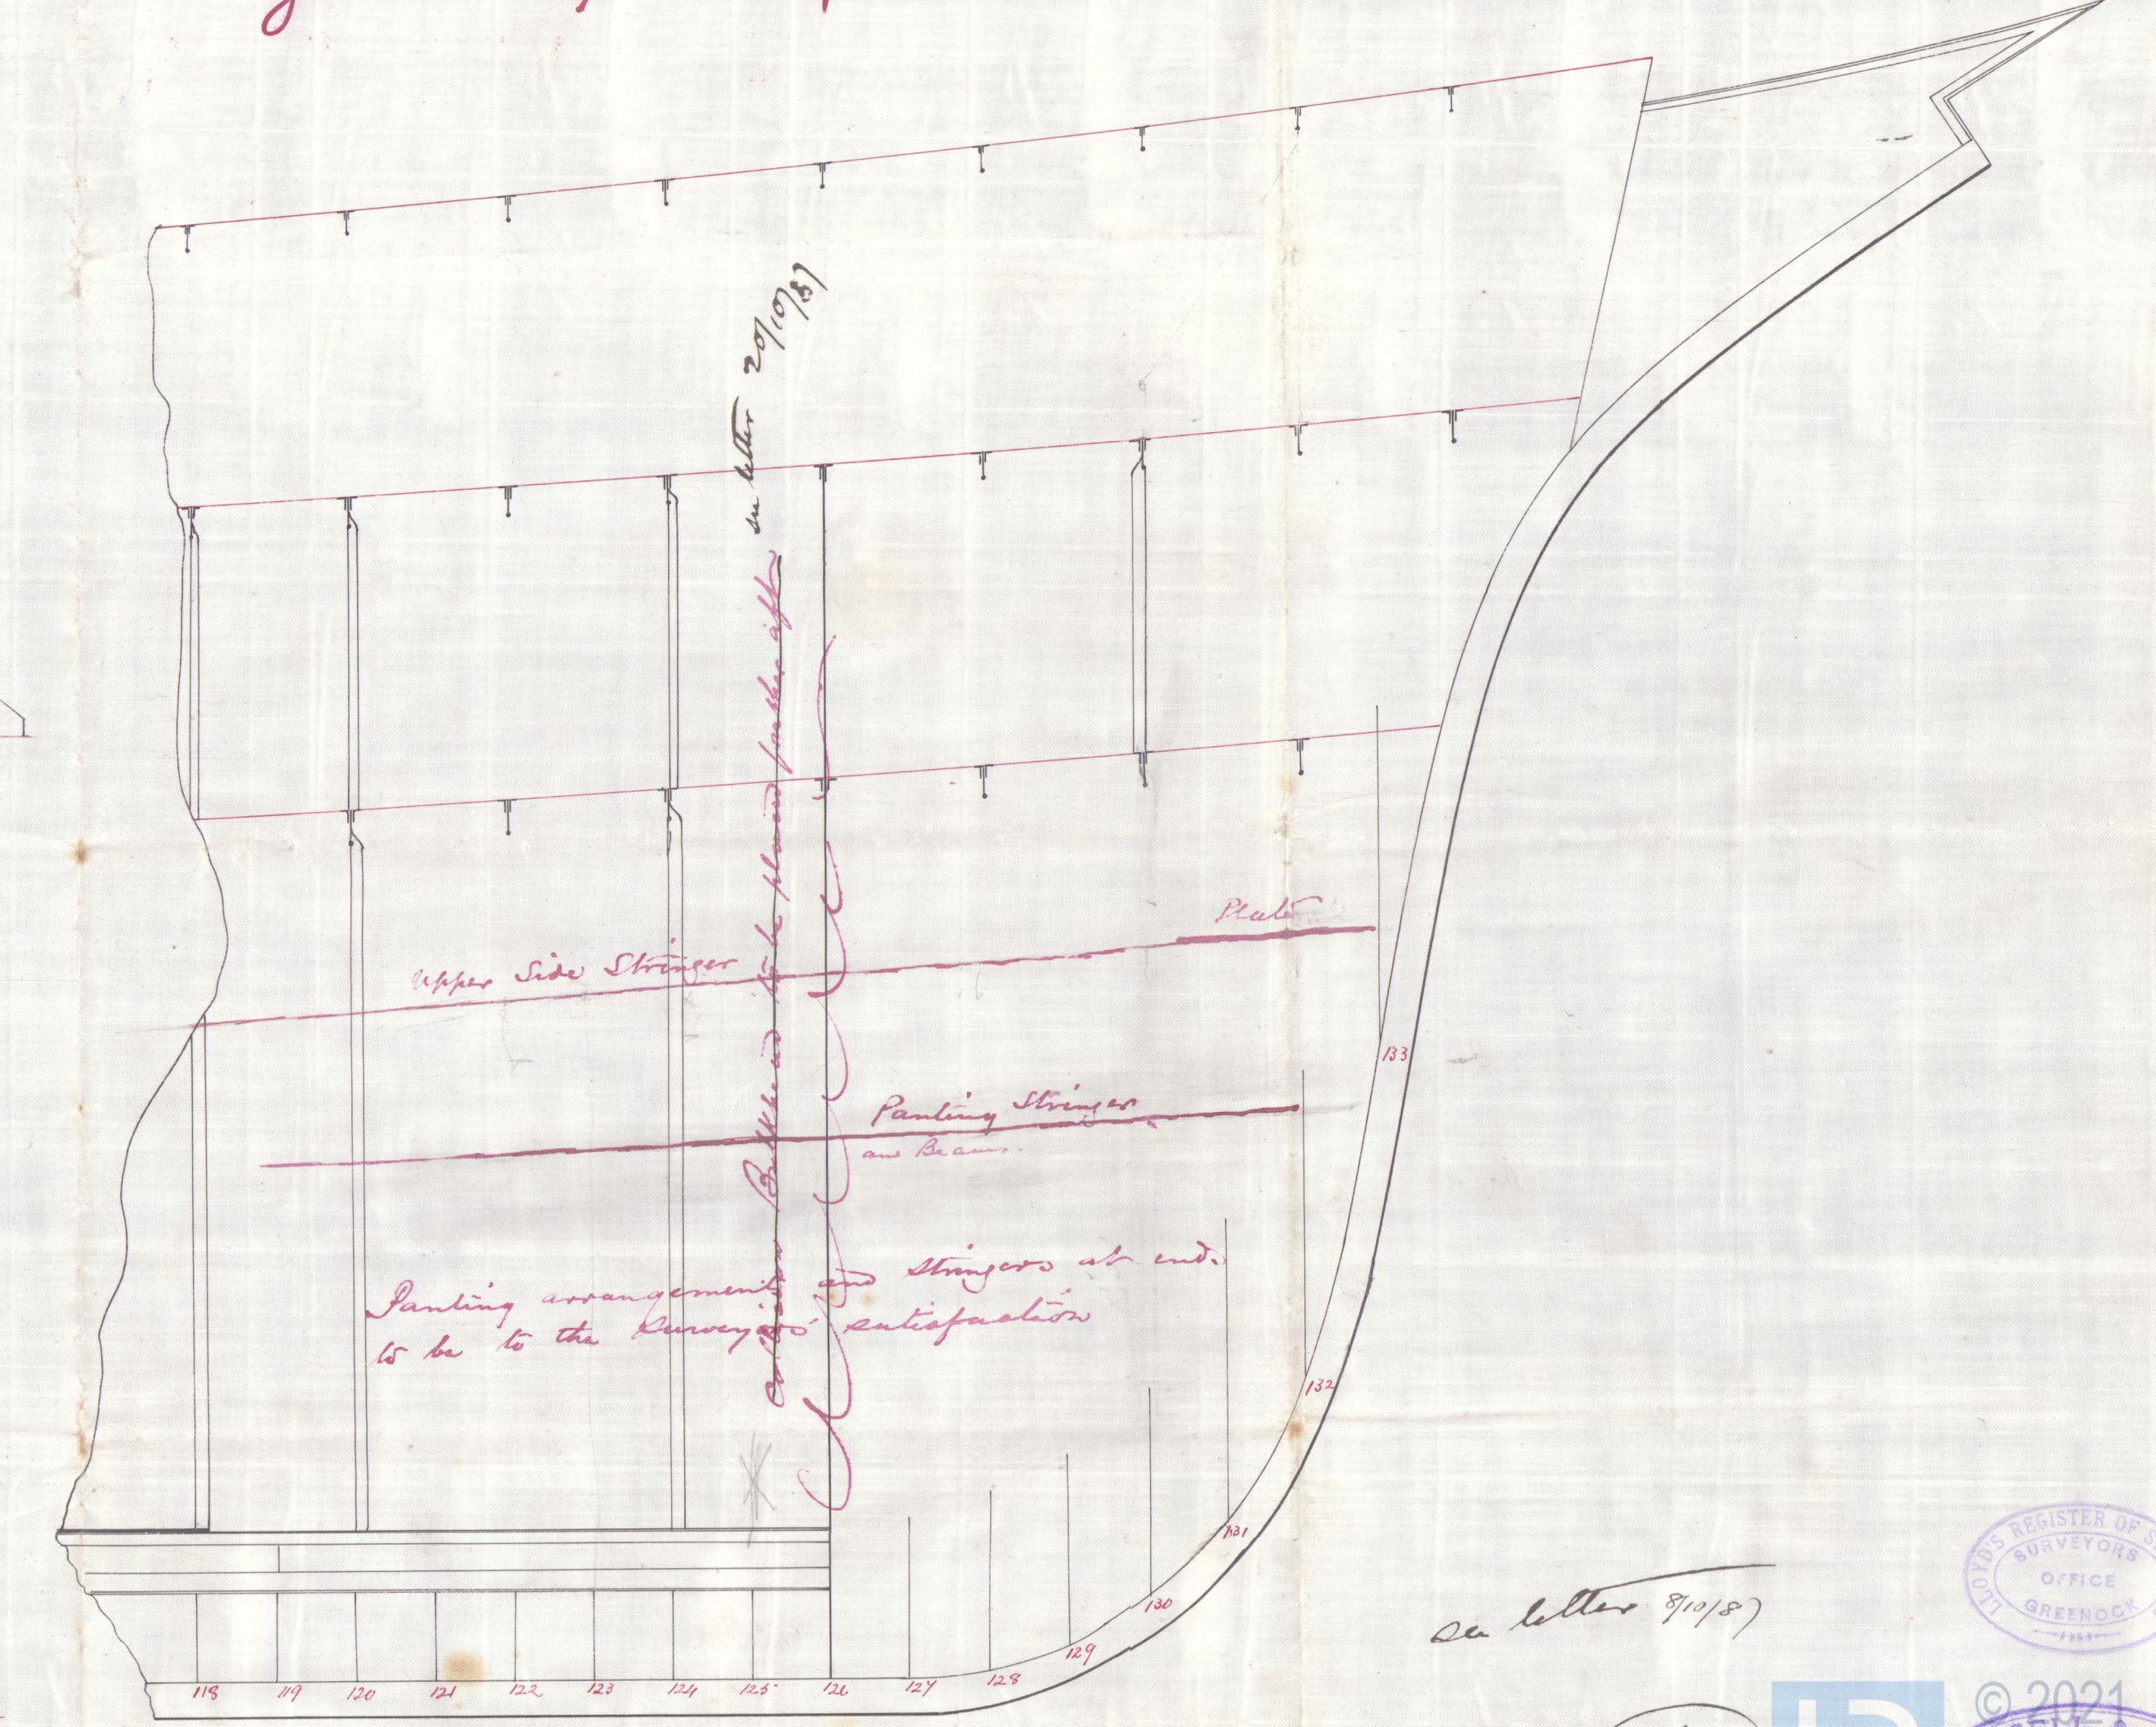


See letter 9/1/87


7/10/87

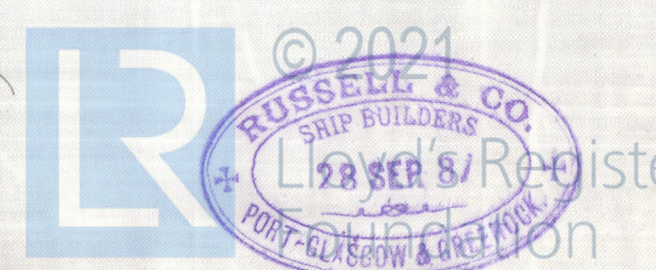

CRH309-0007

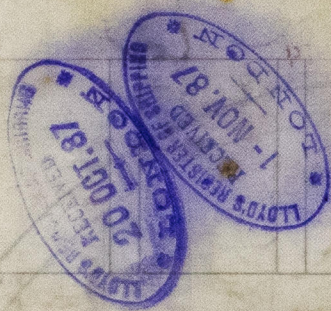

2000-309-0007

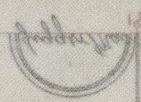

1860/1862

Greenwich depart. 4. 9. 560

117 1/2 27 1/2



© 2021

Lloyd's Register Foundation