

s. "Tinto Hill": Greenock Report No. 9560

8/10/87
20.10.87.


MIDSHIP SECTION No179

SCALE $\frac{1}{2}$ INCH-ONE FOOT.


Iron Ship - to class 100A.1.

Reg'd Dimensions 283'5" x 40'4" x 24'63" Hold.

Proportions.
9.92 Depths } In Length.
6.66 Breadths }

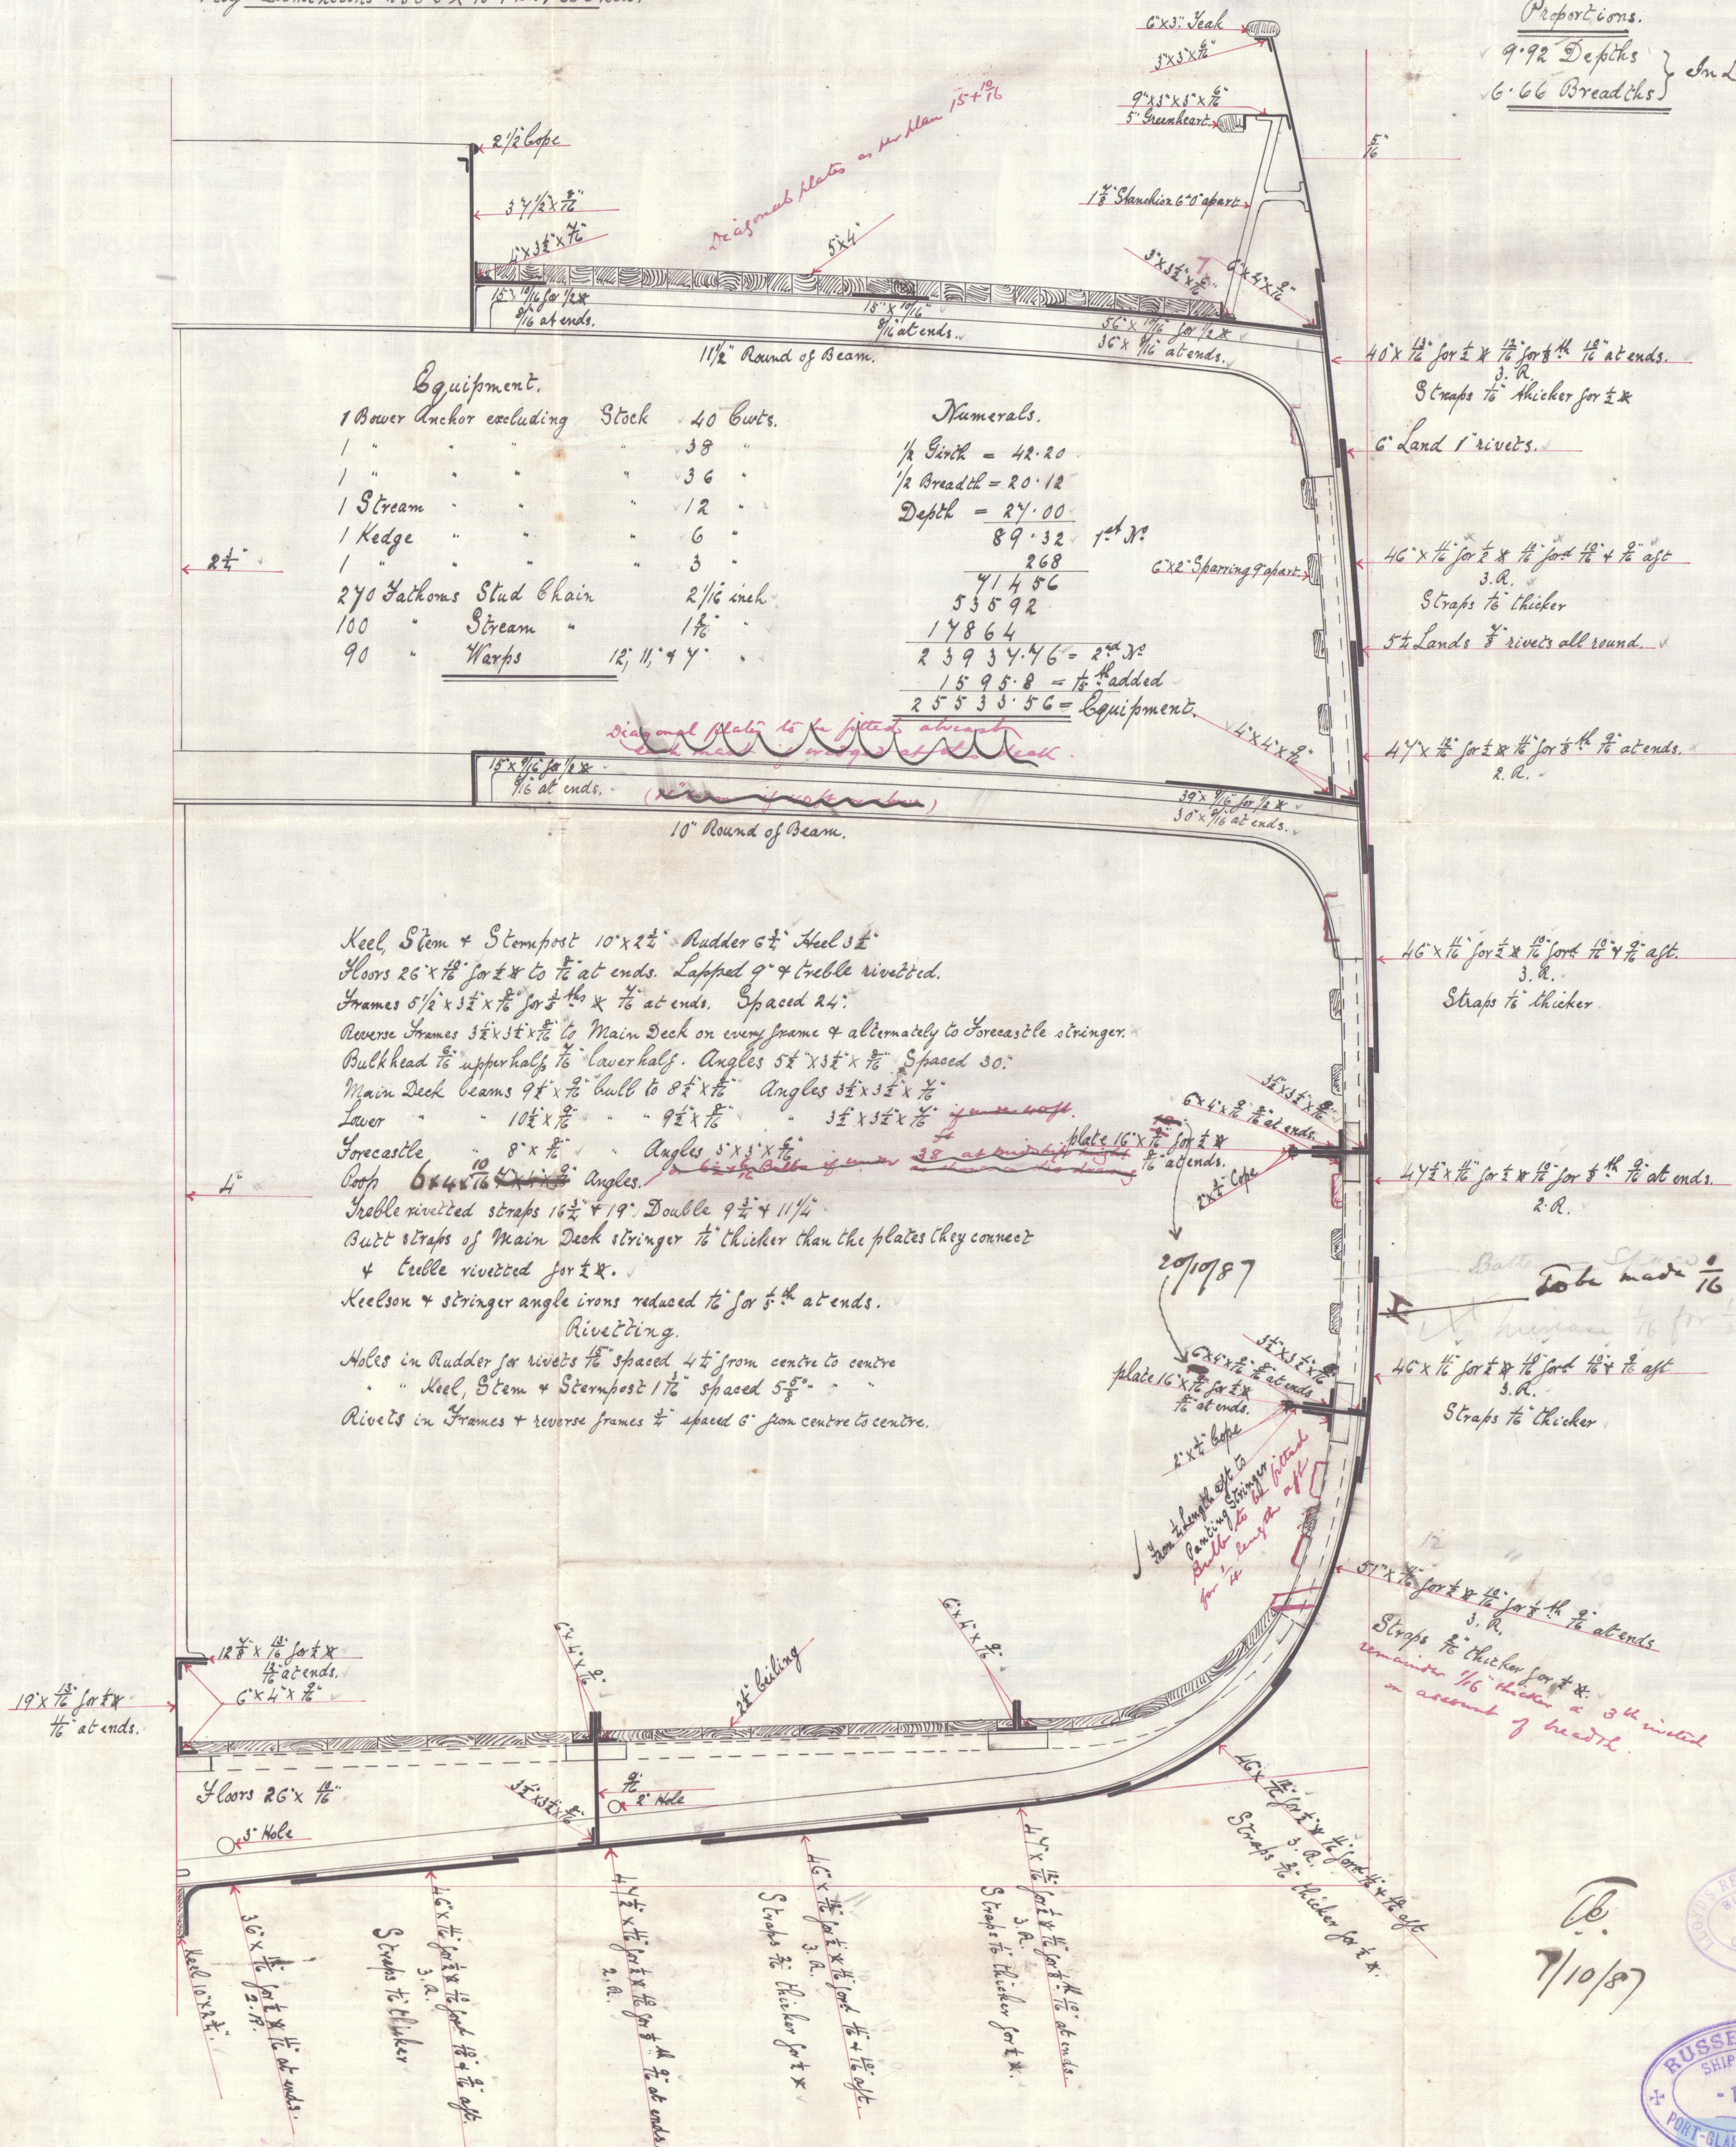

7/10/87

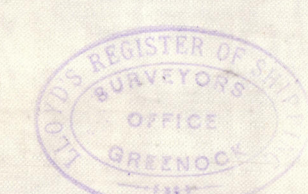

MIDSHIP SECTION

И 7109

SCALE 1/8 INCH=ONE FOOT.


© 2021

© 2021

Lloyd's Register Foundation