

Sec to
Mr. J. Pollock.
31.5.88

No. 197 + 198.

Longitudinal Section & Deck Plans
T.S.S. 200 x 36 ft x 31 at L.W.L. x 9-6 Hold 10-1 moulded
For the Amazon Steam Navigation Company
To Class A1 for River Purposes
Scale $\frac{1}{2}$ inch = 1 Foot

Steamers

"Rio Branco" and "João Alfredo"
Greenock Report Nos. 9614 + 9615

Longitudinal Section

Main Deck Plan



Spar Deck Plan



J.H.
30/5/88



ARH310-0182

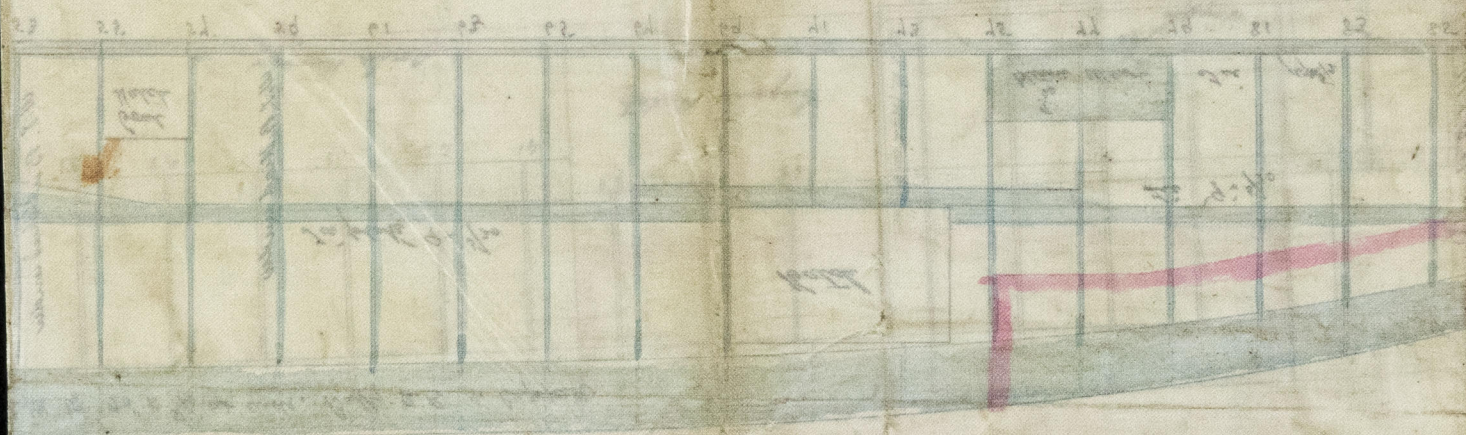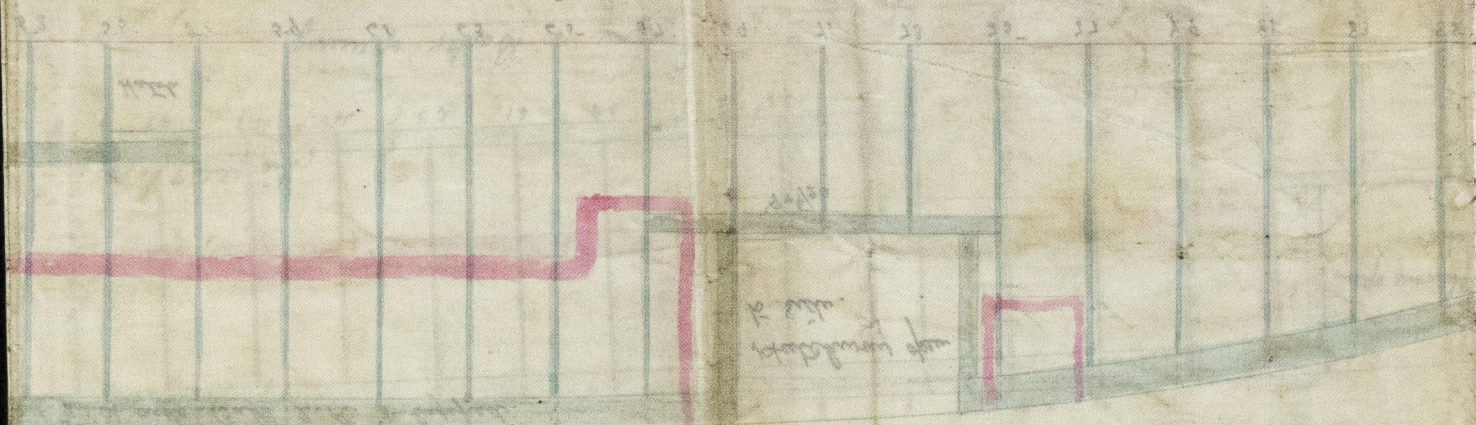

© 2020

Lloyd's Register
Foundation