


bergit aoo. "amurci out"
 210pt + 100pt
 Secr. to
 Grk. 10/6/88.

Main Deck Plan of Twin Screw Steamers Nos. 197 + 198.
For The Amazon Steam Navigation Company
To Class A1 for River Purposes
Scale 1/8 Inch = 1 Foot

Steamers
 "Rio Branco" and "João Alfredo";
 Greenock Report Nos. 9614 + 9615

Proposed method for stiffening shade deck beams

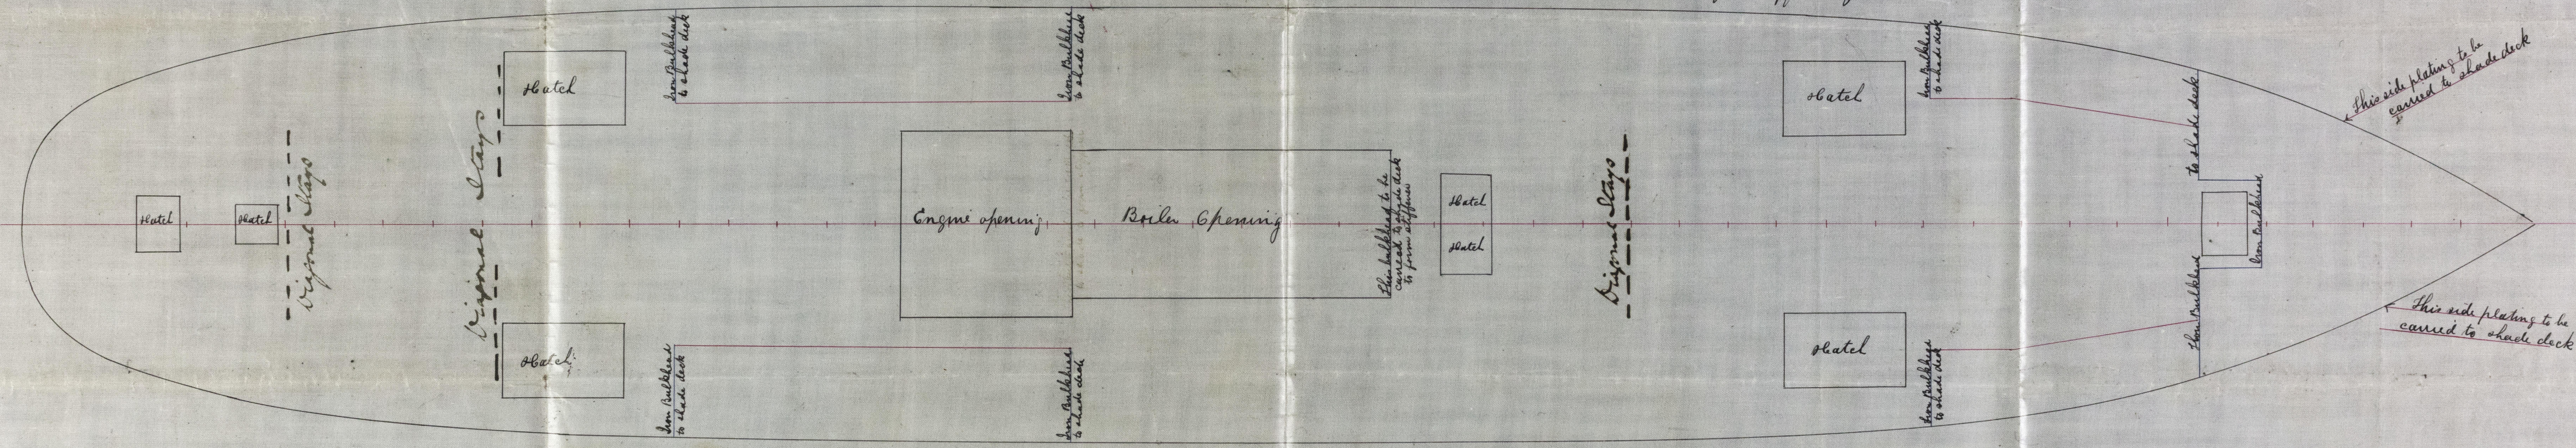

Register
 Foundation



GRUSIO-0184



© 2020

Lloyd's Register
Foundation



Chart

- Rio Branco and João de
Greenock 1843-1844 1845

22
1/2
1/2
1/2

