

Grk. Rept. Nos.

Nos: 197 & 198.


Midship Section.

J.S.S. 200 x 36 & 31 x 9'-6" hold, & 10'-1" moulded.

For The Amazon Steam Navigation Coy Ltd

See list to To class A1 at Lloyds for river purposes
 Mr. J. Sallock, Scale $\frac{1}{2}$ " inch = one foot.
 3/5.88

31.5.88

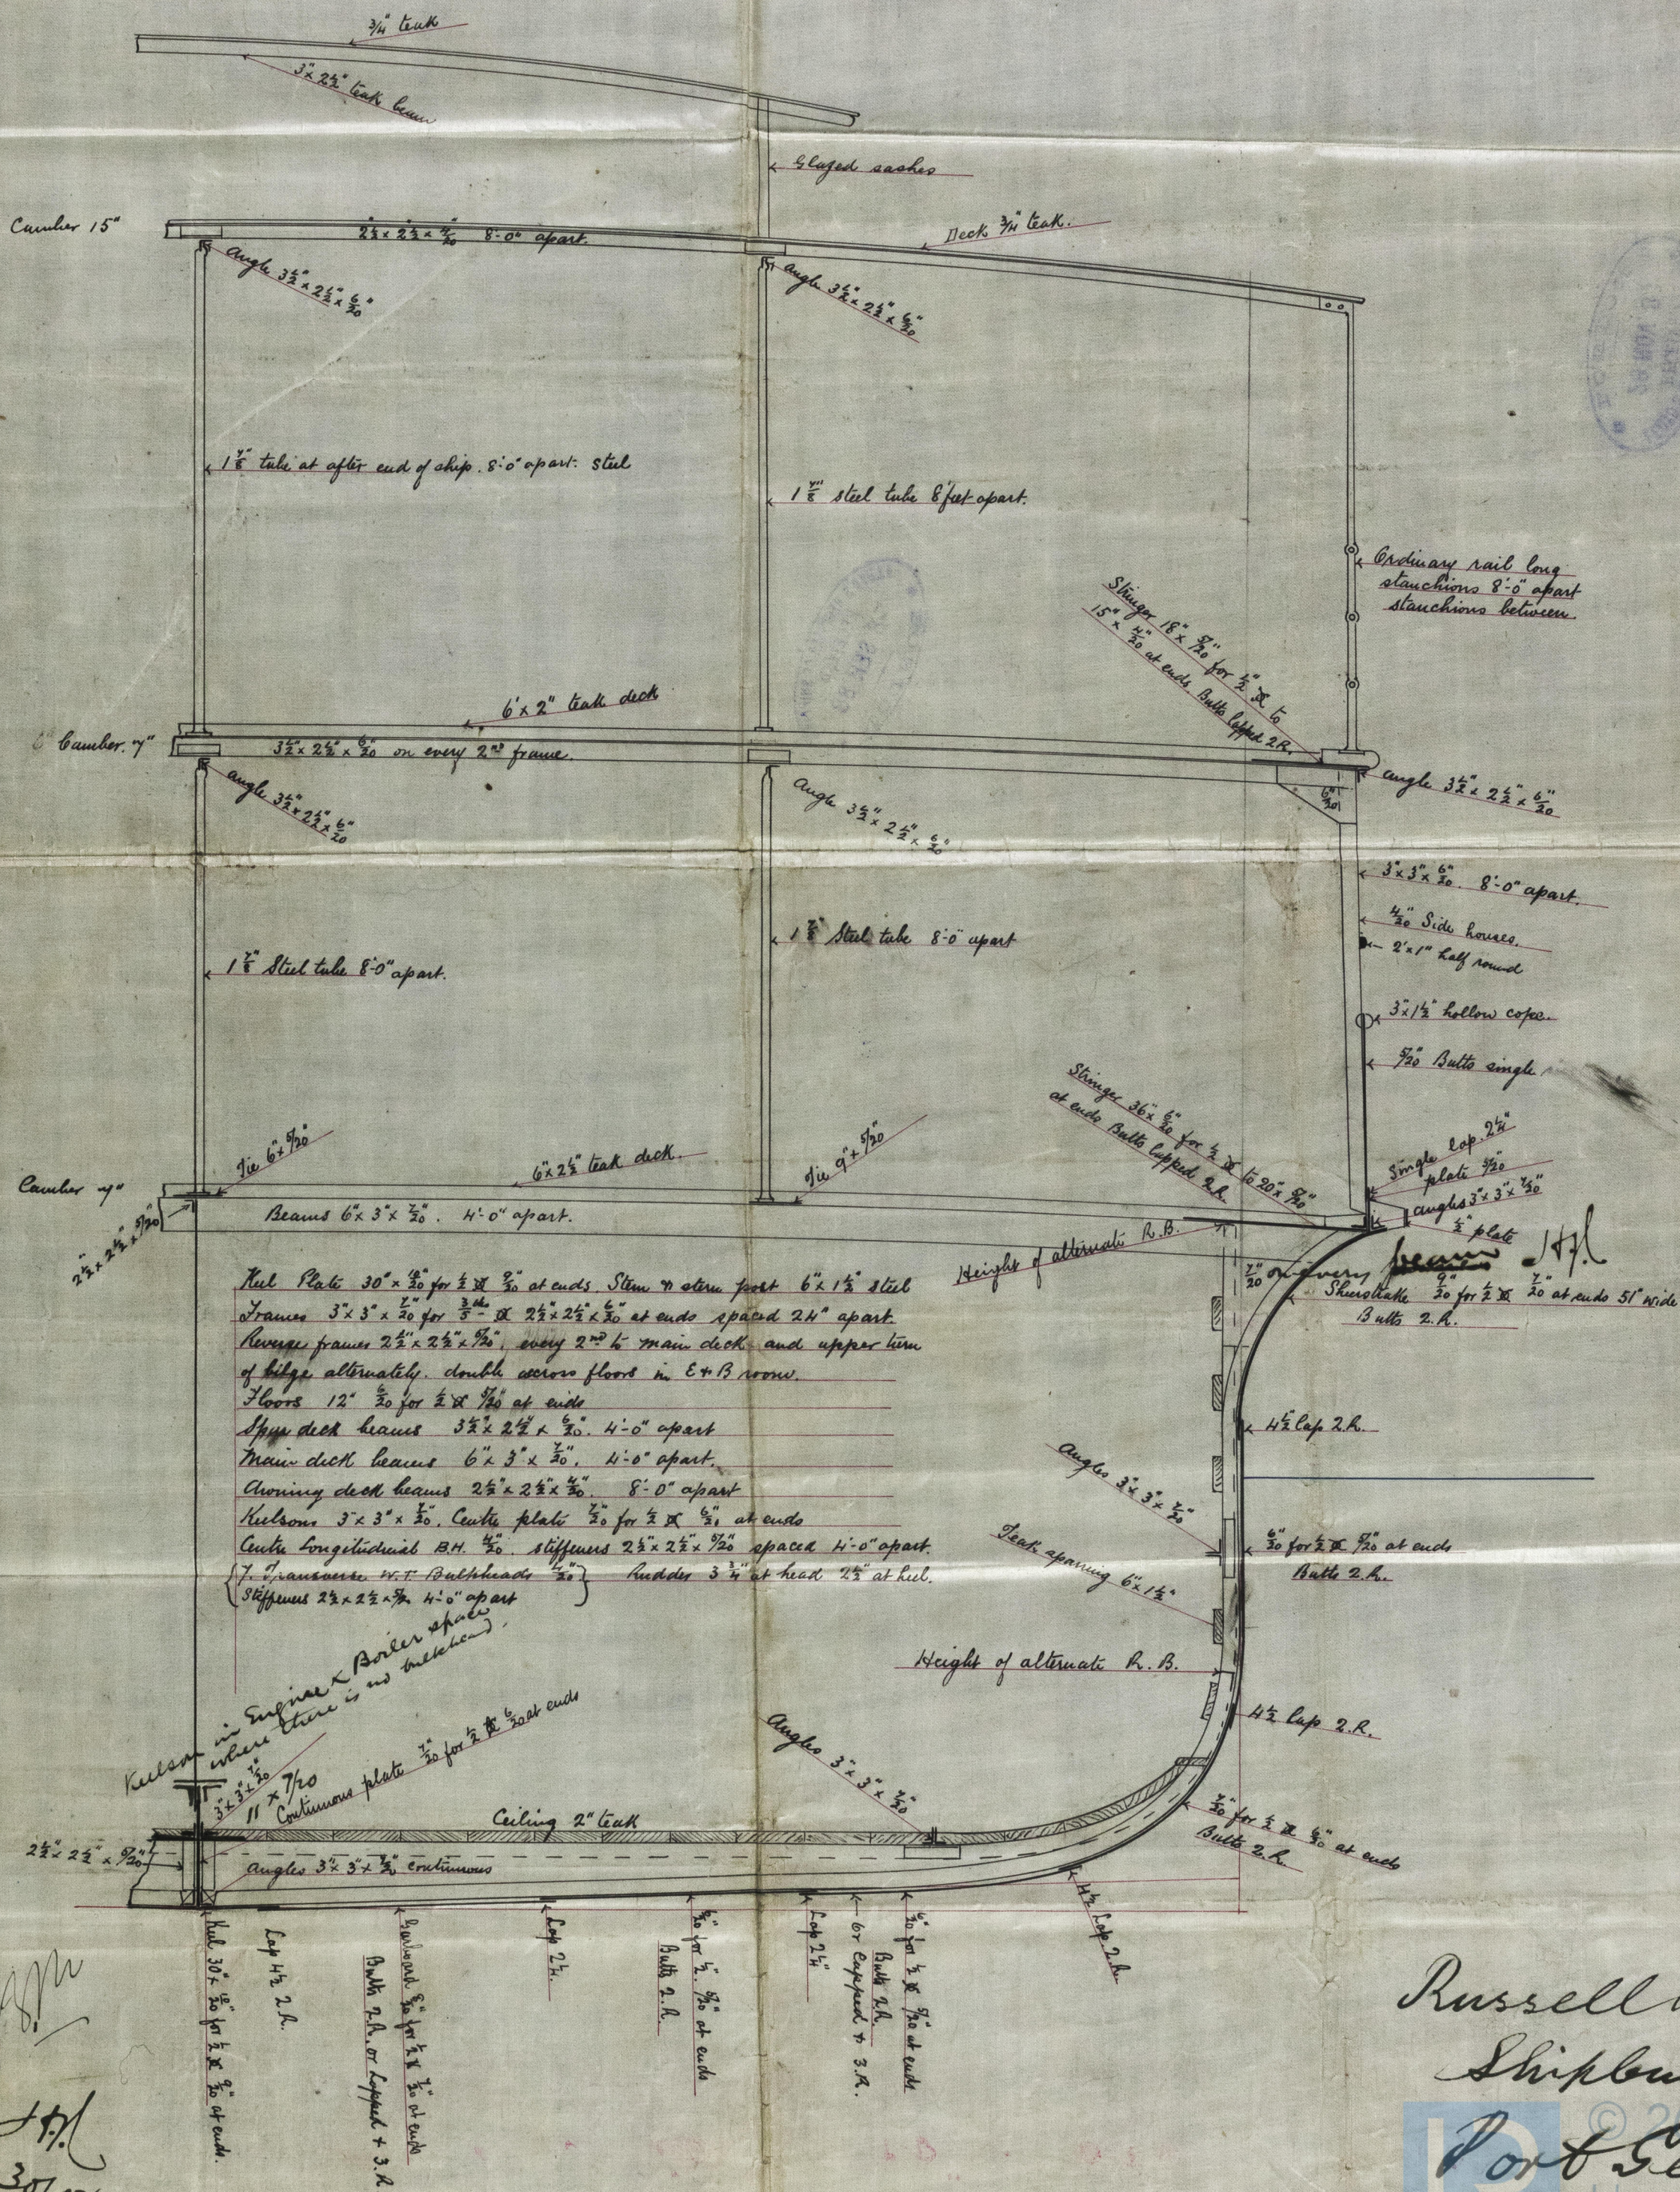

Russell & Co.,
Shipbuilders,

Port Glasgow
Lloyd's Register
Foundation

Handwritten notes in the top left corner, possibly a list or inventory.

Handwritten note: "141"

LLOYD'S REGISTER OF SHIPPING
RECEIVED
28 NOV. 83
LONDON

GRN 310-0155

LLOYD'S REGISTER OF SHIPPING
RECEIVED
18 SEP. 88
LONDON

Vertical handwritten notes on the right edge, possibly a list or inventory.

Handwritten notes in the bottom right corner, possibly a list or inventory.

LLOYD'S REGISTER OF SHIPPING
RECEIVED
20 JUN. 89
LONDON

LLOYD'S REGISTER OF SHIPPING
RECEIVED
15 JUN. 88
LONDON

