

GRB10-099




© 2019


Lloyd's Register
Foundation

S. "Liverpool": Grk. Rept. No. 9630

See Gr & Grk

24. 1. 88.

Ship No 182

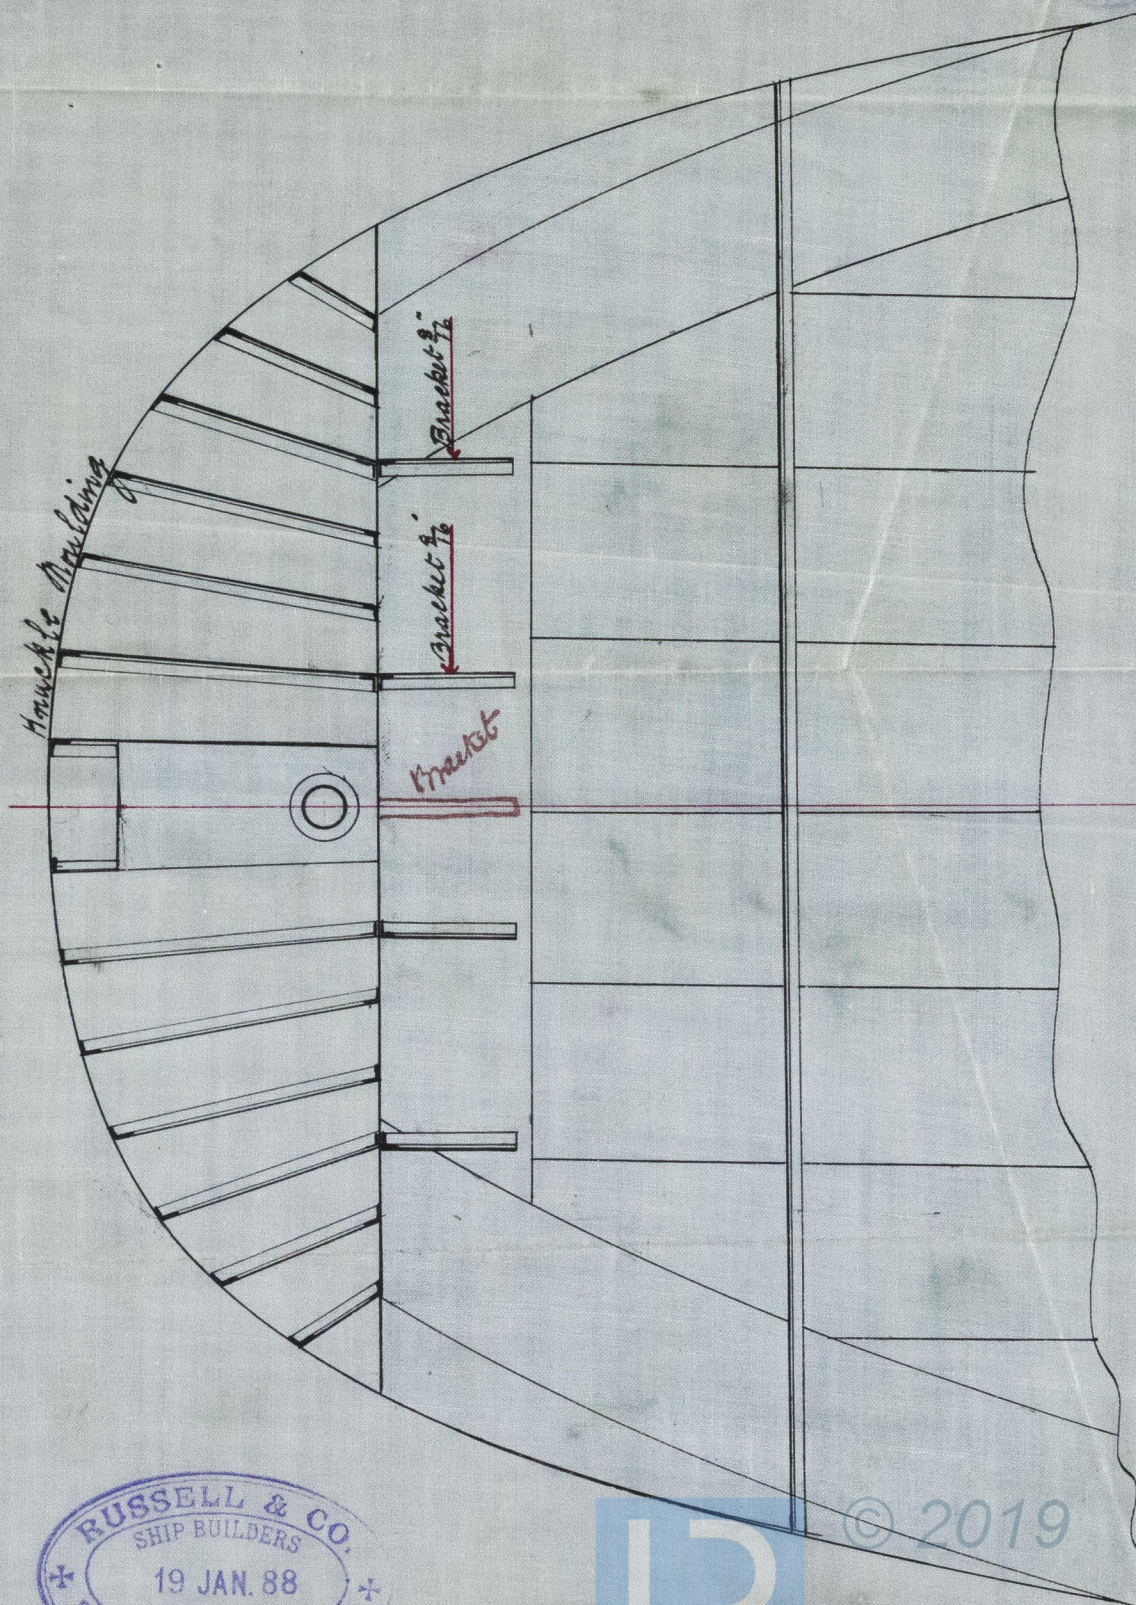

© 2019

Lloyd's Register
Foundation

GRH30-0199

C. 7
19/1/88