


7.1.88.

MIDSHIP SECTION No 182

SCALE 1/2 INCH-ONE FOOT.

C. "Liverpool"
Grk. Rept. No.

Registered Dimensions 333' 0" x 47' 11" x 26' 6 1/2"

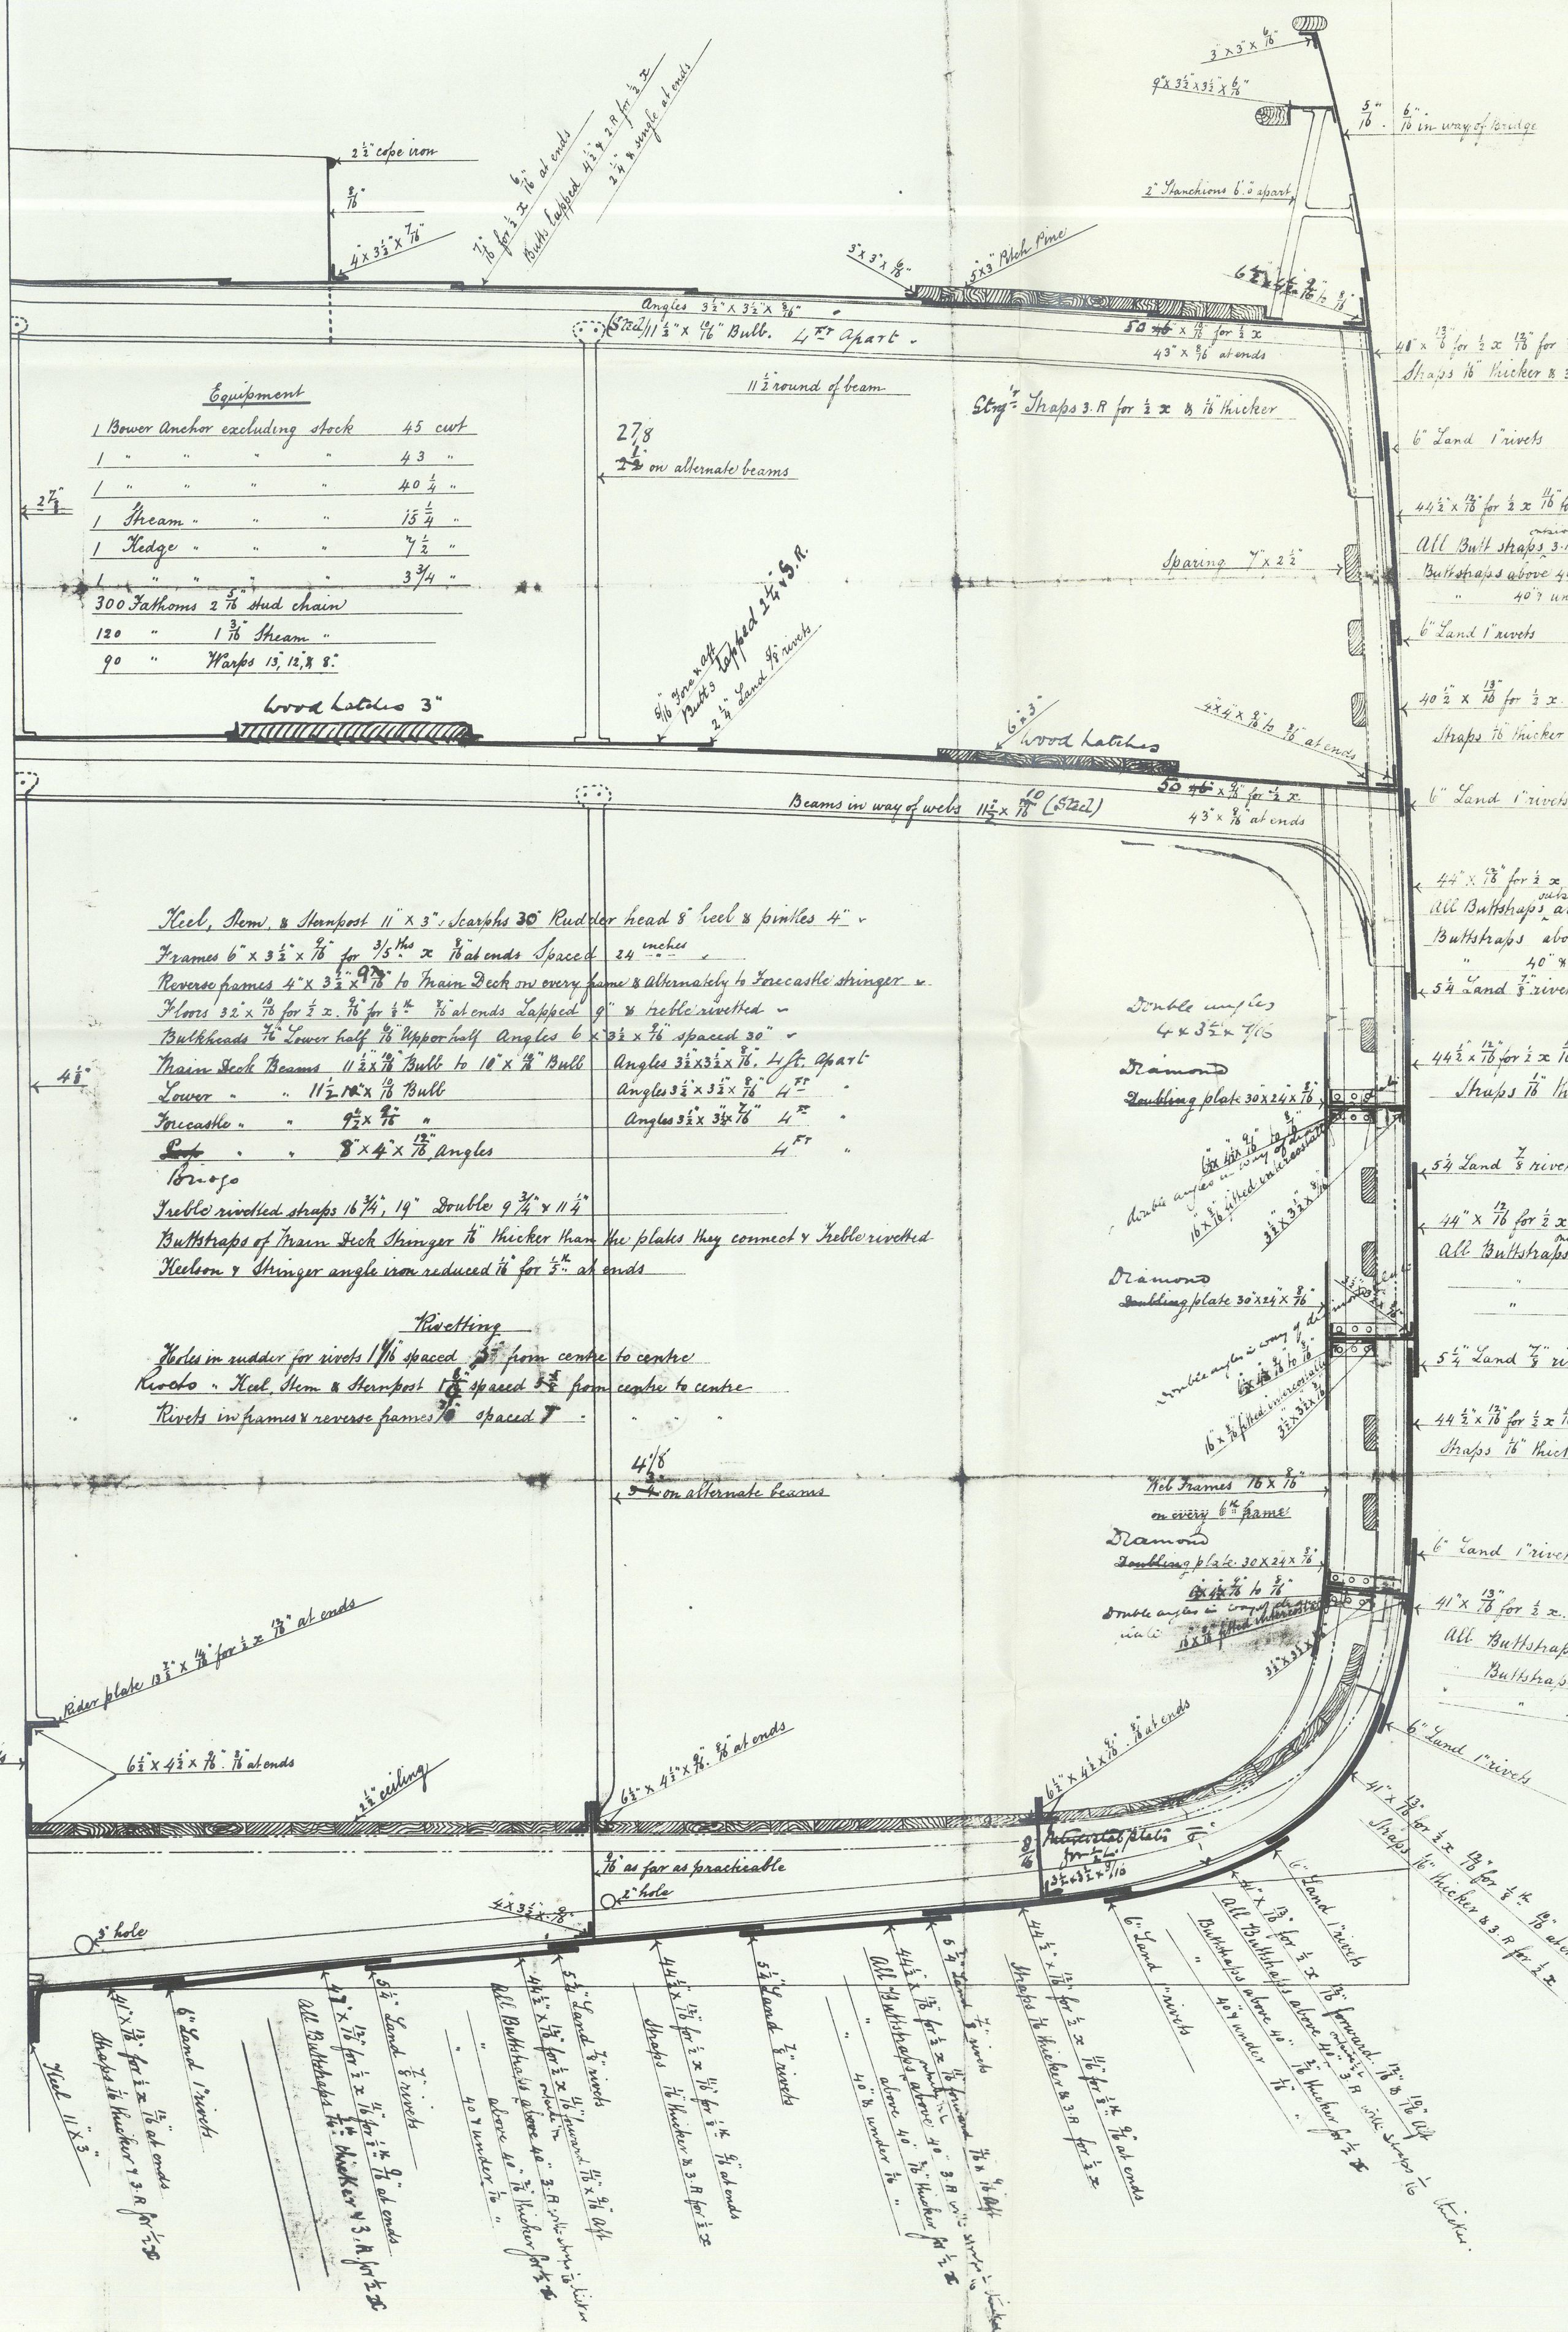

Equipment

1 Bower Anchor excluding stock	45 cwt
1 " " " "	43 "
1 " " " "	40 1/4 "
1 " " " "	15 1/4 "
1 " " " "	7 1/2 "
1 " " " "	3 3/4 "
300 Fathoms 2 5/8" Stud chain	
120 " 1 3/8" " "	
90 " " " "	

Lloyds

1/2 Girth	48.58
1/2 Bdth	23.83
Depth	29.41
101.82 = 1" Nominal	
320.2 Length	
32602.76 2" N:	
2173.51 1/2 added	
34776.27 Equipment &c	

Proportions

10.8	Depths	} In Length
6.7	Bdths	

Keel, Stem & Sternpost 11" x 3" Scarphs 30" Rudder head 8" keel & pintles 4" -
Frames 6" x 3 1/2" x 7/8" for 3/8" x 1/2" at ends Spaced 24 inches
Reverse frames 4" x 3 1/2" x 7/8" to Main Deck on every frame & alternately to Forecastle stringer &
Floor 3 1/2" x 7/8" for 1/2" x 7/8" at ends Lapped 9" & treble rivetted -
Bulkheads 7/8" Lower half 7/8" Upper half Angles 6" x 3 1/2" x 7/8" spaced 30"
Main Deck Beams 11 1/2" x 7/8" Bull to 10" x 7/8" Bull Angles 3 1/2" x 3 1/2" x 7/8" Left Apart
Lower " " 11 1/2" x 7/8" Bull Angles 3 1/2" x 3 1/2" x 7/8" 4"
Forecastle " " 9 1/2" x 7/8" Angles 3 1/2" x 3 1/2" x 7/8" 4"
Ribs " " 8" x 4" x 7/8" Angles 4"
Bridges
Treble rivetted straps 16 1/4", 19" Double 9 3/4" x 11 1/4"
Bulkheads of Main Deck stringer 7/8" thicker than the plates they connect & treble rivetted
Keelson & stringer angle iron reduced to 3/4" at ends

Rivetting
Ribs in rudder for rivets 1 1/8" spaced 5" from centre to centre
Ribs " Keel, Stem & Sternpost 1 1/8" spaced 5" from centre to centre
Rivets in frames & reverse frames 7/8" spaced 7"

7/1/88

S.V. "LIVERPOOL"

Midship Section

GRH310-0200



© 2020

Lloyd's Register
Foundation