



7.1.88.

s. "Liverpool:"
Grk. Rept. No. 9630


No 182
SCALE 1/4" INCH-ONE FOOT.

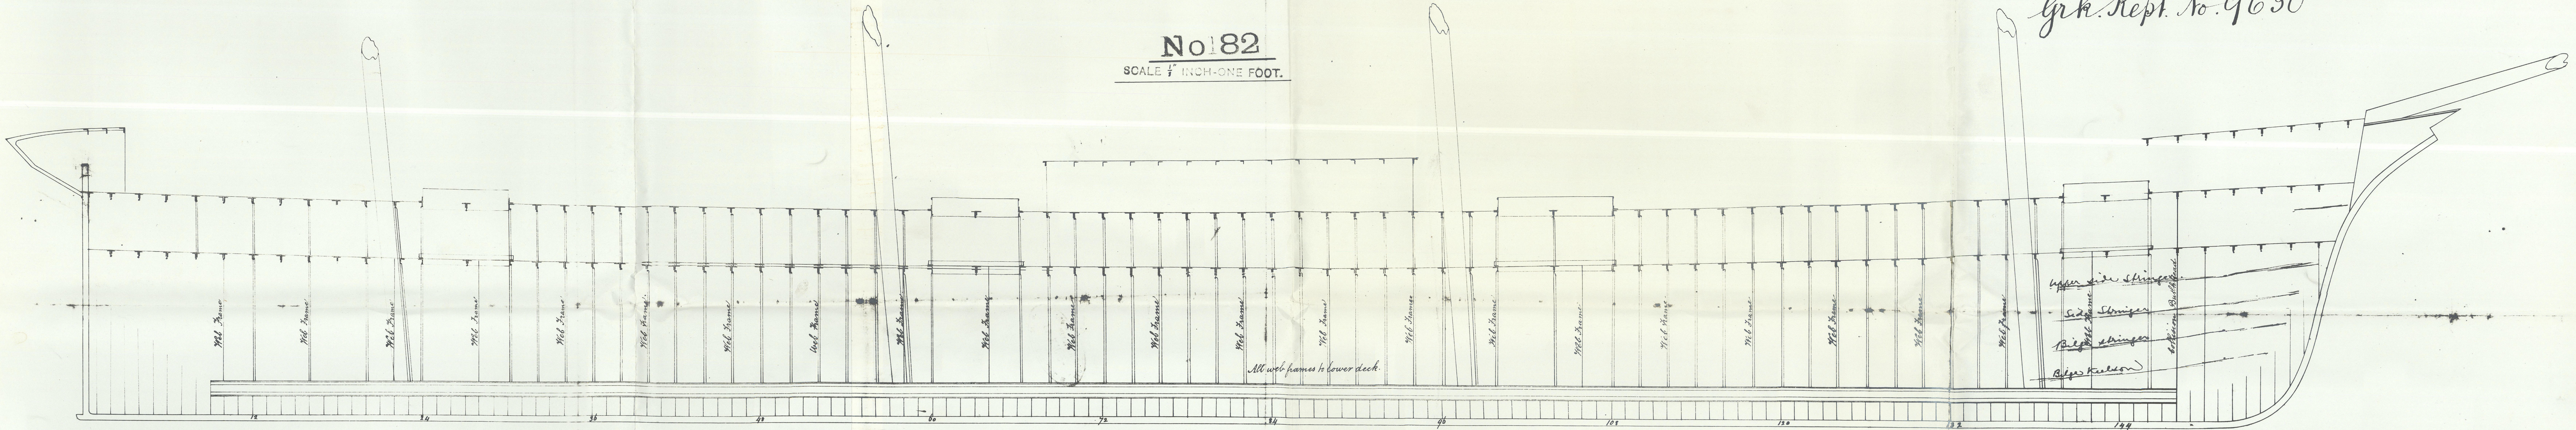

LONGITUDINAL SECTION

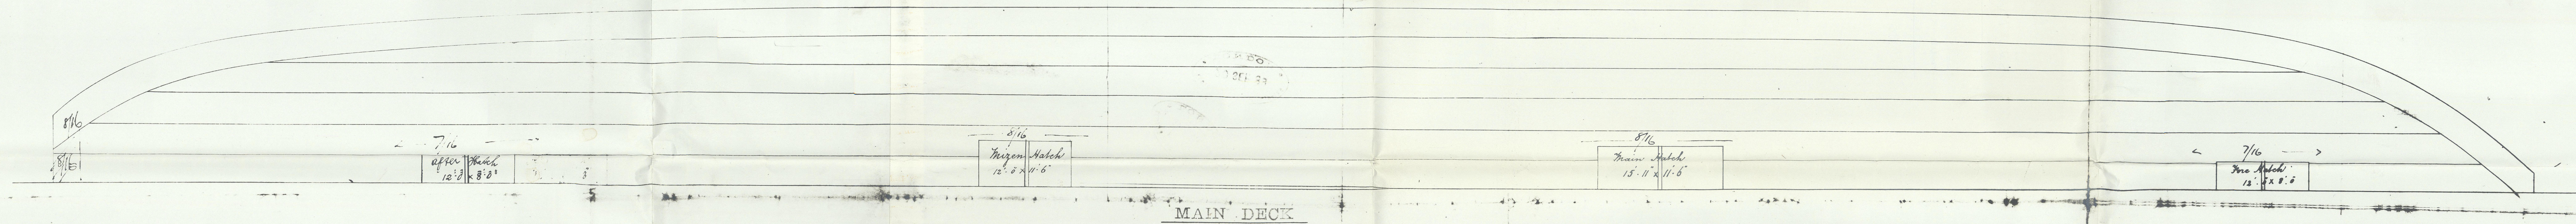

MAIN DECK

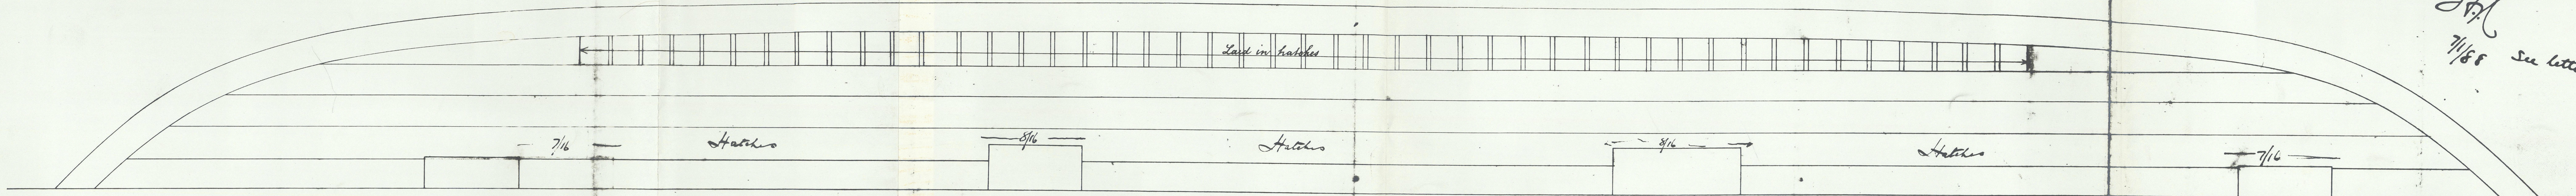

LOWER DECK

Plast plates on each deck
of the thickness required by the
rules.

J.H.
7/88 See letter



Lloyd's Register
Foundation

S.V. "LIVERPOOL"

Profile & Decks

GRH310-0202



© 2020

Lloyd's Register
Foundation