

Lloyd's Register of British and Foreign Shipping.

(Report on Vessel No. 9630 Port Greenock)No. 1630SHIP FORGINGS ~~OR CASTINGS~~.I have to report that the undermentioned Iron ~~or Steel~~ Forgings or Castings, manufactured byThe Portland Forge Co. of Kilmarnock.for the Vessel No. 182, being built by Messrs Russell & Co.of Port Glasgow have been inspected by me as set forth below, and found to be, so far as can be seen, sound and efficient.

Mark on Forgings.

Lloyd's


No. 1630

G. N

George Newcomb.Glasgow16/5/88,Post

| | STERN FRAME. | RUDDER FRAME. | STEM & Keel. |
|--------------------------|-------------------------------|---------------|------------------------------------|
| Material* - - - | <u>Scrap iron</u> | / | <u>Scrap iron</u> |
| How made - - - | <u>Forged.</u> | | <u>Forged.</u> |
| Dimensions - - - | <u>11 x 3"</u> | | <u>11 x 3"</u> |
| Progress on Inspection - | <u>Forging & smithing</u> | | <u>Forging.</u> |
| Dates when Inspected { | <u>30/3/88. 5.9.13/4/88.</u> | | <u>30/3/88. 5.9.13.18.24/4/88.</u> |
| | | | <u>14/5/88.</u> |

SKETCHES OF FRAMES SHEWING POSITION AND DESCRIPTION OF WELDS OF FORGINGS, OR PARTICULARS OF TESTS APPLIED TO CASTINGS.

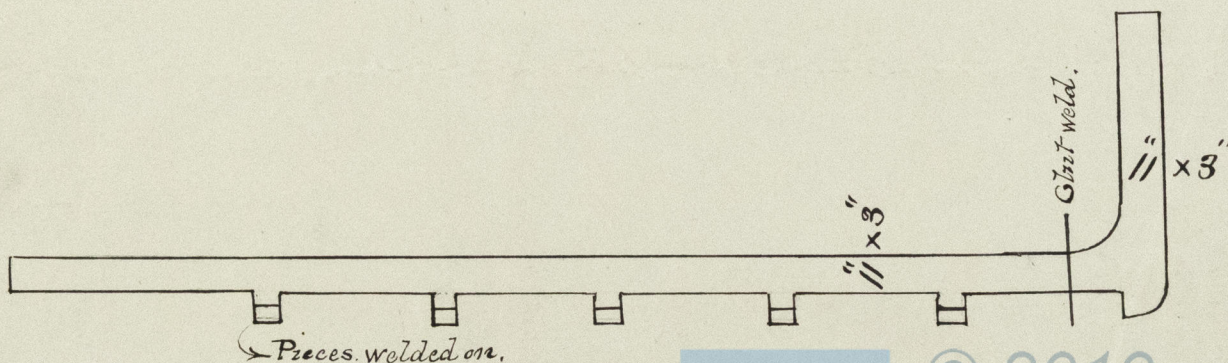

→ Pieces welded on.

Girth weld.

11 x 3"

11 x 3"