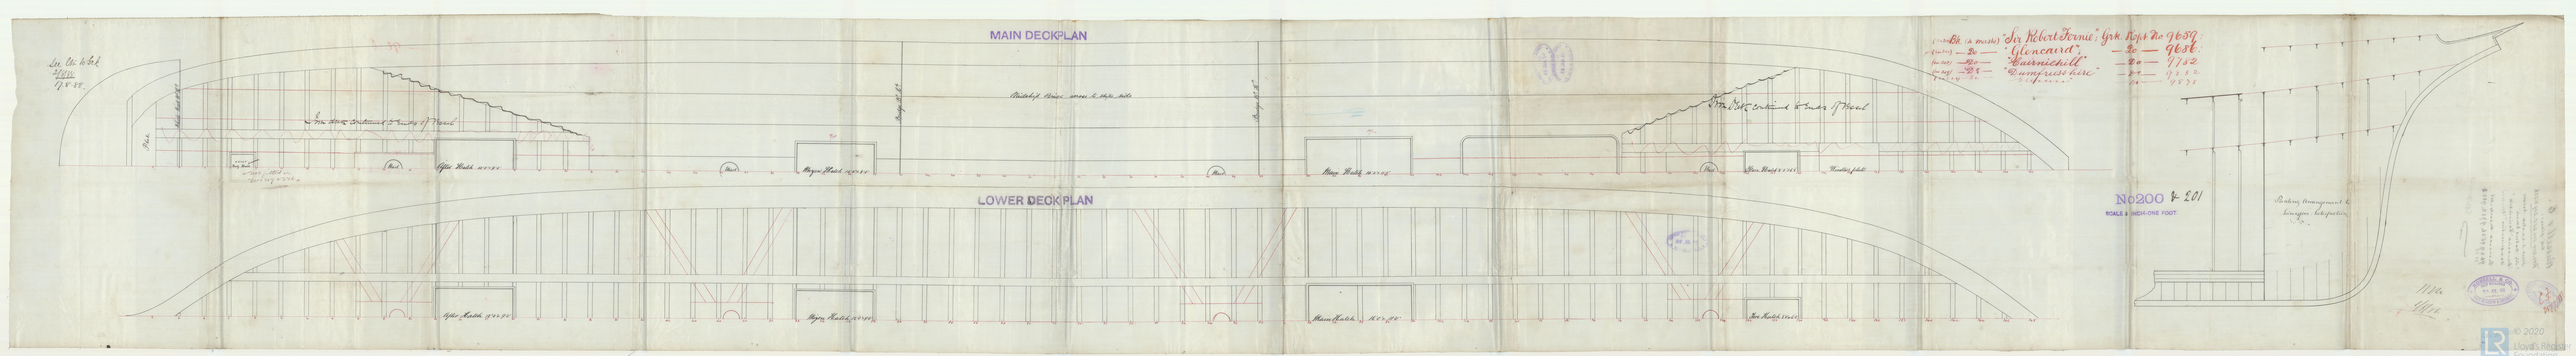

© 2020 Lloyd's Register Foundation

Russell & Co.

DK plans.

Nos. 200. 201. 208. 219 & 226

Steel 4-masted barques
"Sir Robert Fernie"
"Glencaird" "Cairnichill"
"Dumfriesshire" "Glencona"

Greenock Reports Nos.
9659, 9686, 9782, 9852
9875

GRh310-0247

LLOYD'S REGISTER OF SHIPPING SURVEYORS OFFICE GREENOCK

LLOYD'S REGISTER OF SHIPPING SURVEYORS OFFICE GREENOCK


© 2020 Lloyd's Register Foundation