





Fine Main + Main Mast.	
Chain Plate	
Lower Chronos 2 1/2	
Cop + Upper Mast & Keelson 2 1/2	
Up gall <sup>st</sup>	1 1/2
Royal	1 1/2
Hecail	1 1/2
Fluggin Mast	
Lower Chronos 1 1/2	
Let-mast & Backstop 1 1/2	
Topgall <sup>st</sup>	1 1/2

Sommege Under Deck 2460

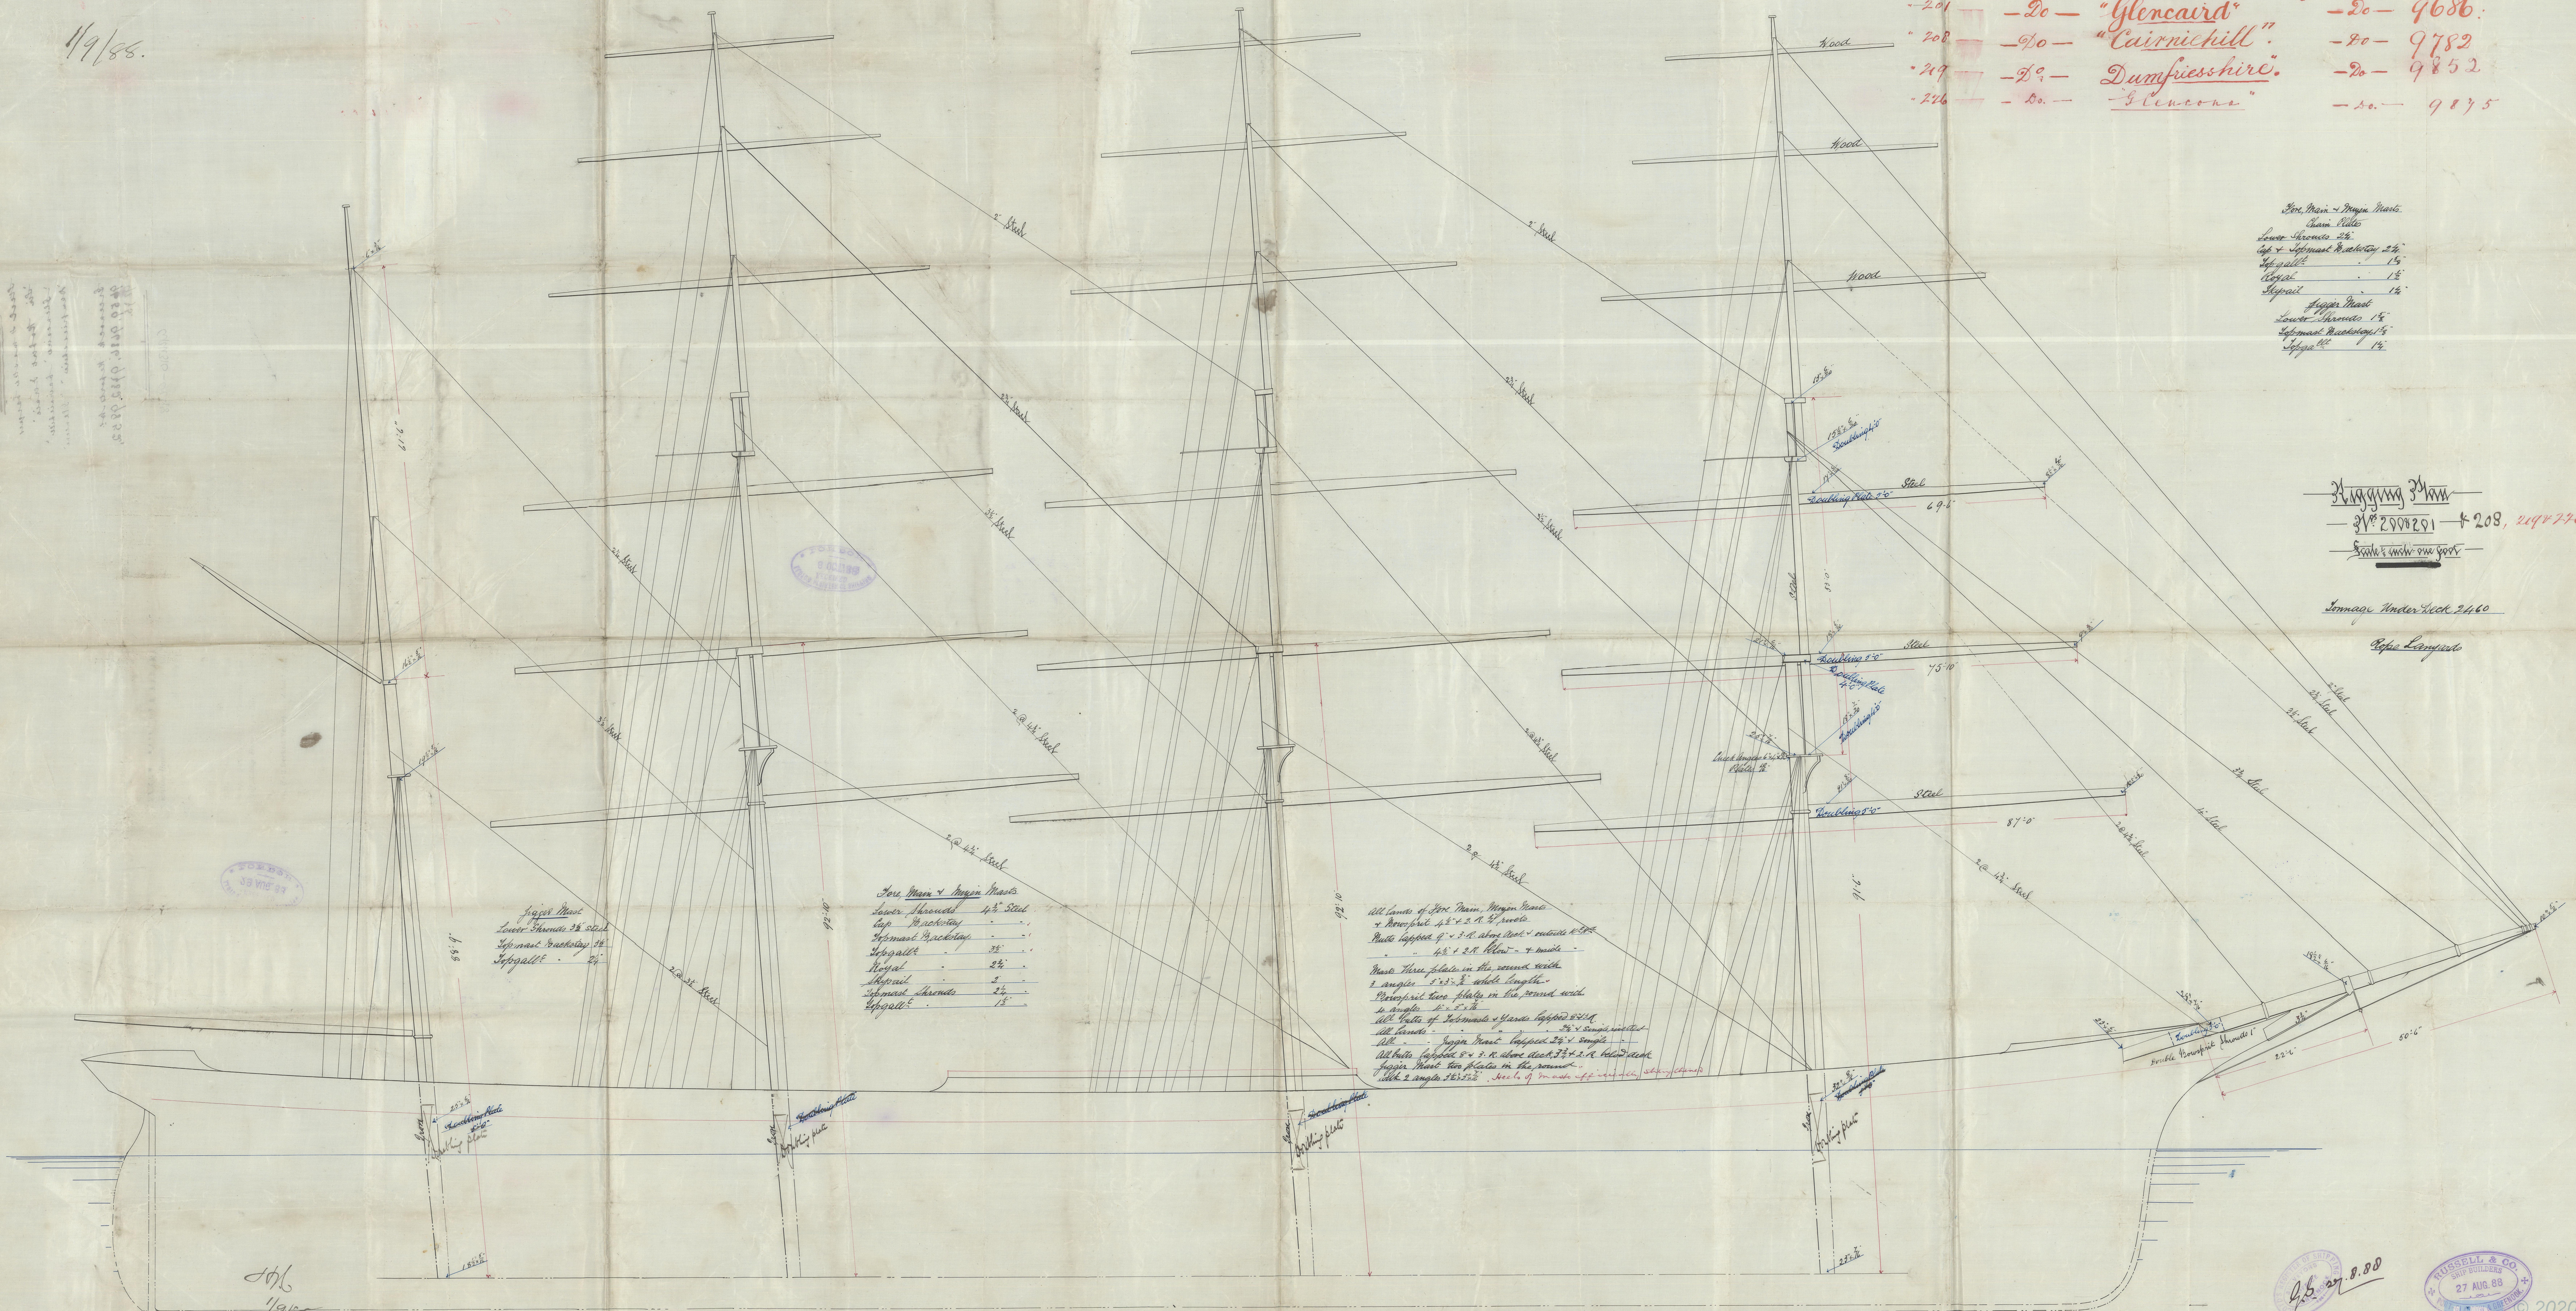

10/6  






Russell & Co.  
Rigging plan.  
Nos 200-201-208-219-226

Steel & master barges  
"Sir Robert Fergus"  

Greenock Reports No:  
9659, 9686, 9782, 9852,  
9875.

CPH310-0248

