

MIDSHIP SECTION

No 200 & 201 & 208.

SCALE 1/2 INCH-ONE FOOT.

Register Dimensions 31' 0" x 42' 0" x 24' 6"

Four-masted steel barque "SIR ROBERT FERNIE"

"Do" "CLENCAIRD"

"Do" "Cairnuchill"

"Do" "Dunfermline"

"Do" "Greenock"

Greenock Report No 9659,

9686

9782

9852

17.8.88.

SAT 9 APR 89

In memo 5/9/88 C.F.

& 219



1/2 Girth 42.6

1/2 Breadth 20.9

Depth 27.86

90.96 = 1.17

296

26924.16 = 2.17

1794.94 = 1.17 added


28719.10 = Equipment

Proportions

10.74 Depth

7.08 Breadth

In Length

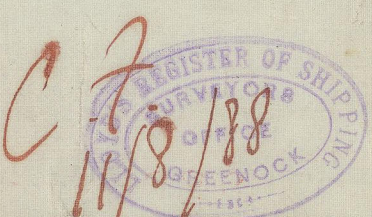

Register Foundation


Russell & Co Nos
200-201-208.

Obs. - Sir Robert Davis
"Glencairn" Cairn Hill
"Dumfriesshire"
"Glencairn"

Greenock Reports Nos.

9659, 9686, 9782

GRU310-0250

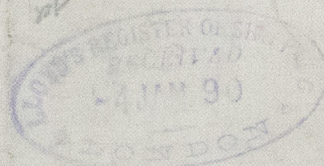

© 2020

Lloyd's Register
Foundation