

Det 24/11/88
r 15/1/89

s.s. "Larnaca"; Grk Report No. 9676.


Spring plan SS Larnaca. Yr 1997 ~~220~~

Seale $\frac{1}{2}$ the m. foot

Chius valves disposed with
per. Committee's letter 15/1/89.

P. C. W. 2/23/1888

RECEIVED
24 NOV 33
LLOYD'S REGISTER OF SHIPING

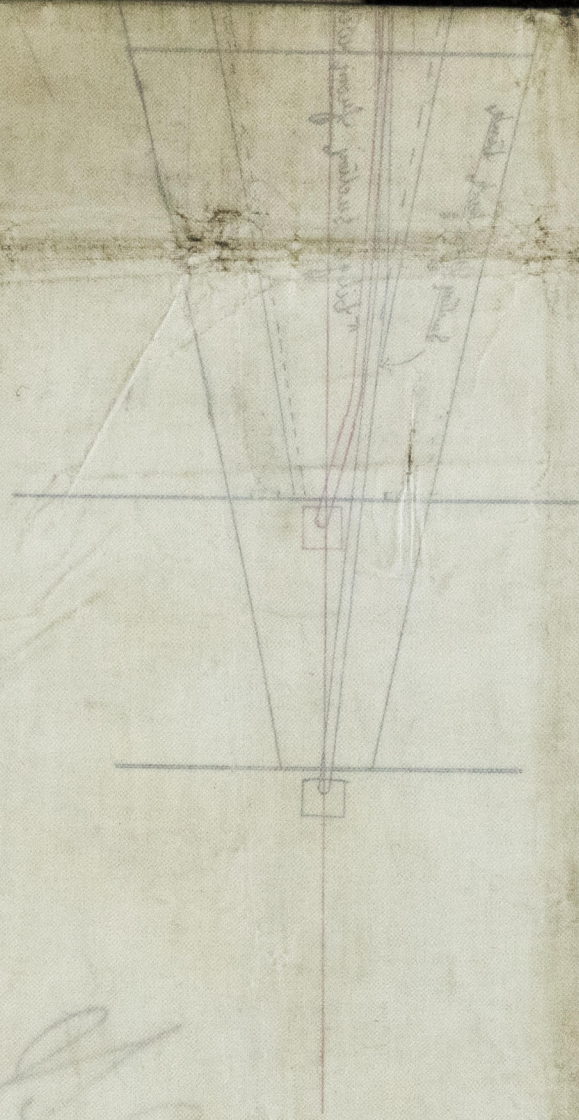

S. S. "Larnaca"
Greenock Report
No. 9686

ARH310-0294

St. Elia 23/1/33

*Spang, John SS Larnaca No. 19
Greenock 23/1/33
Greenock 23/1/33*



© 2020
Lloyd's Register
Foundation