



See br. to Grk
13.7.88

S.S. 'Larnaca' Grk Report No. 9676
S.S. 'Strathesk' — 9915

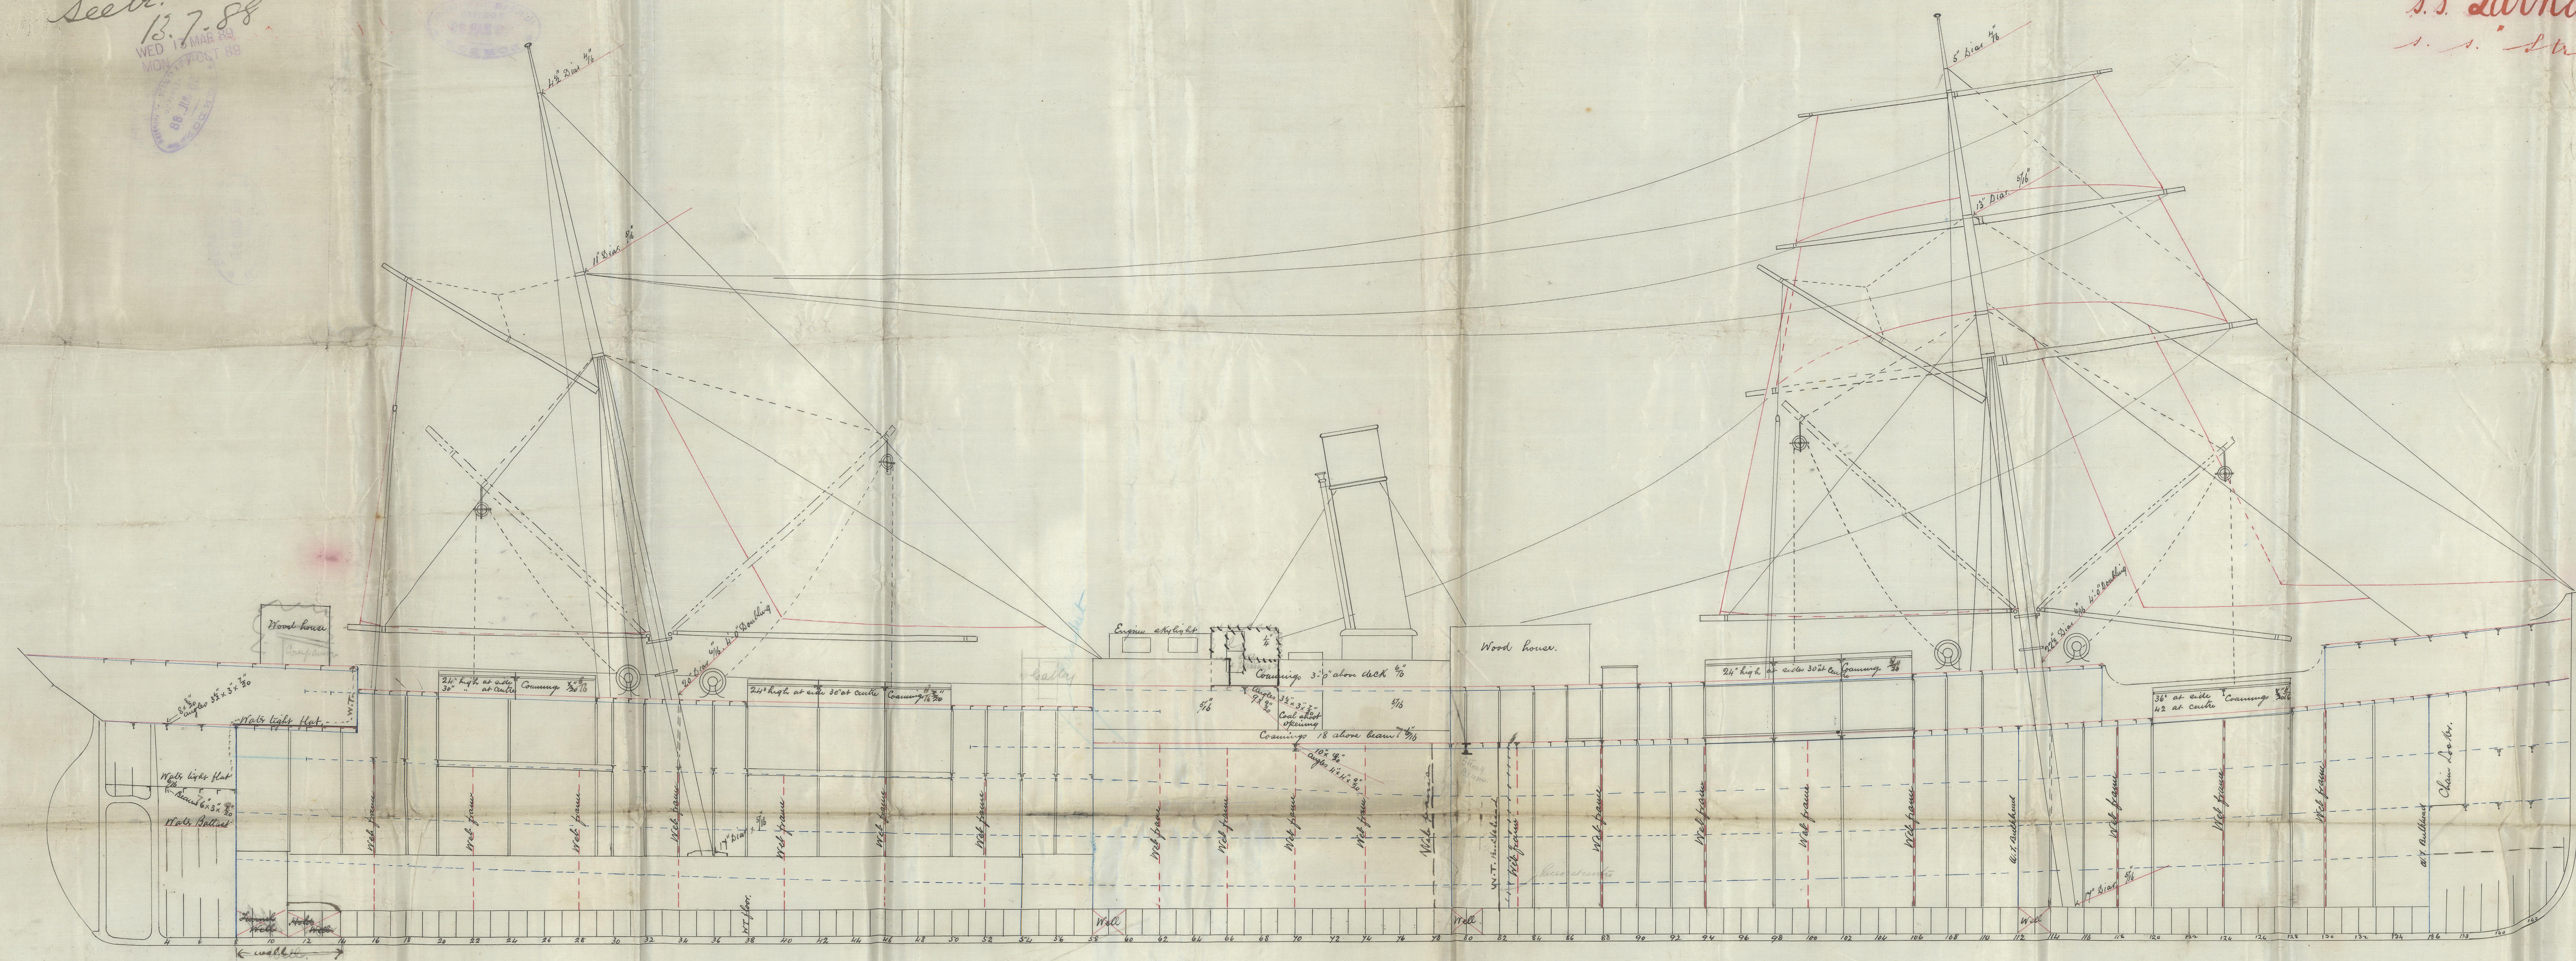

Longitudinal & Deck Plans S.S. 'Larnaca' 72199 & 220
A Class 100 A1 at Lloyds' Reg. 1/10/87
Scale 1" = one foot.

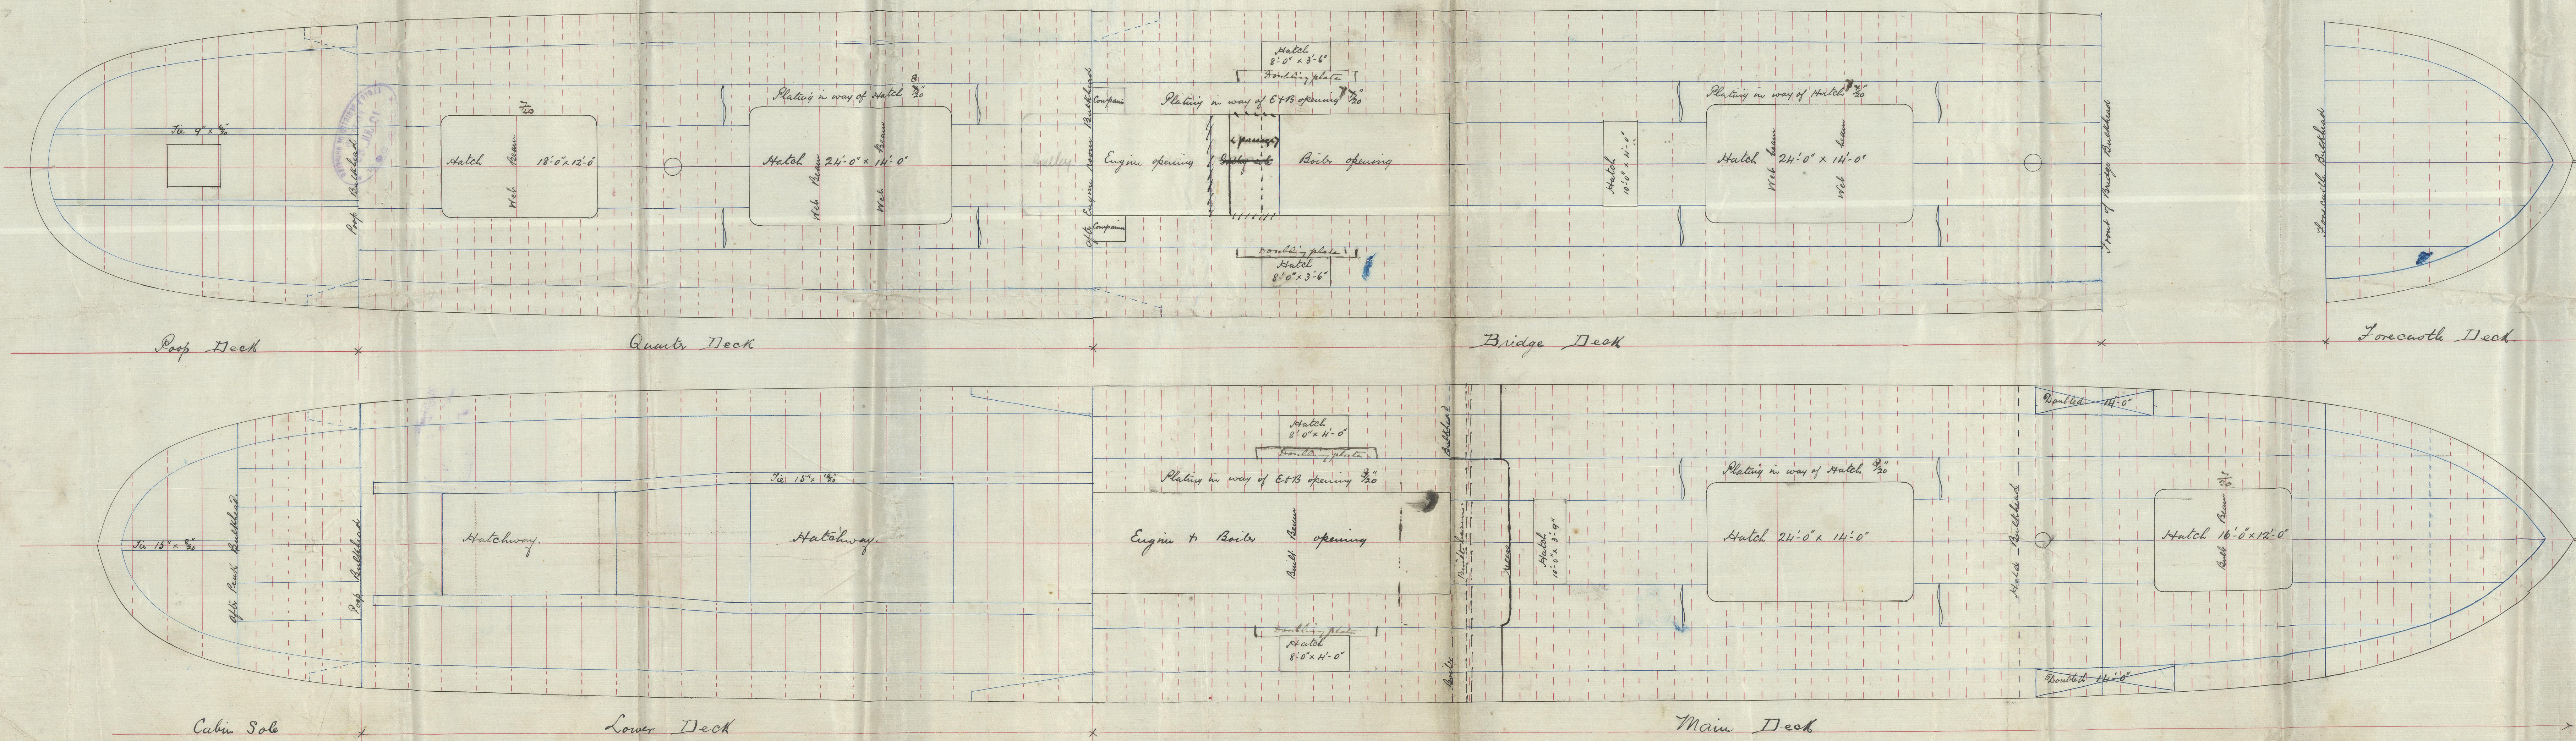

W. & A. R. & CO.
SHIP BUILDERS
6 JUL 88
GLASGOW & LONDON

W. & A. R. & CO.
SHIP BUILDERS
6 JUL 88
GLASGOW & LONDON

GR 310-0296



Lloyd's Register
Foundation