


S.S. "Larnaca" Grk. Report No. 9676

24/4/88.

Rigging Plan  
 No 199 S.S.  
 "Larnaca"  
 Scale 1/8" = one foot.

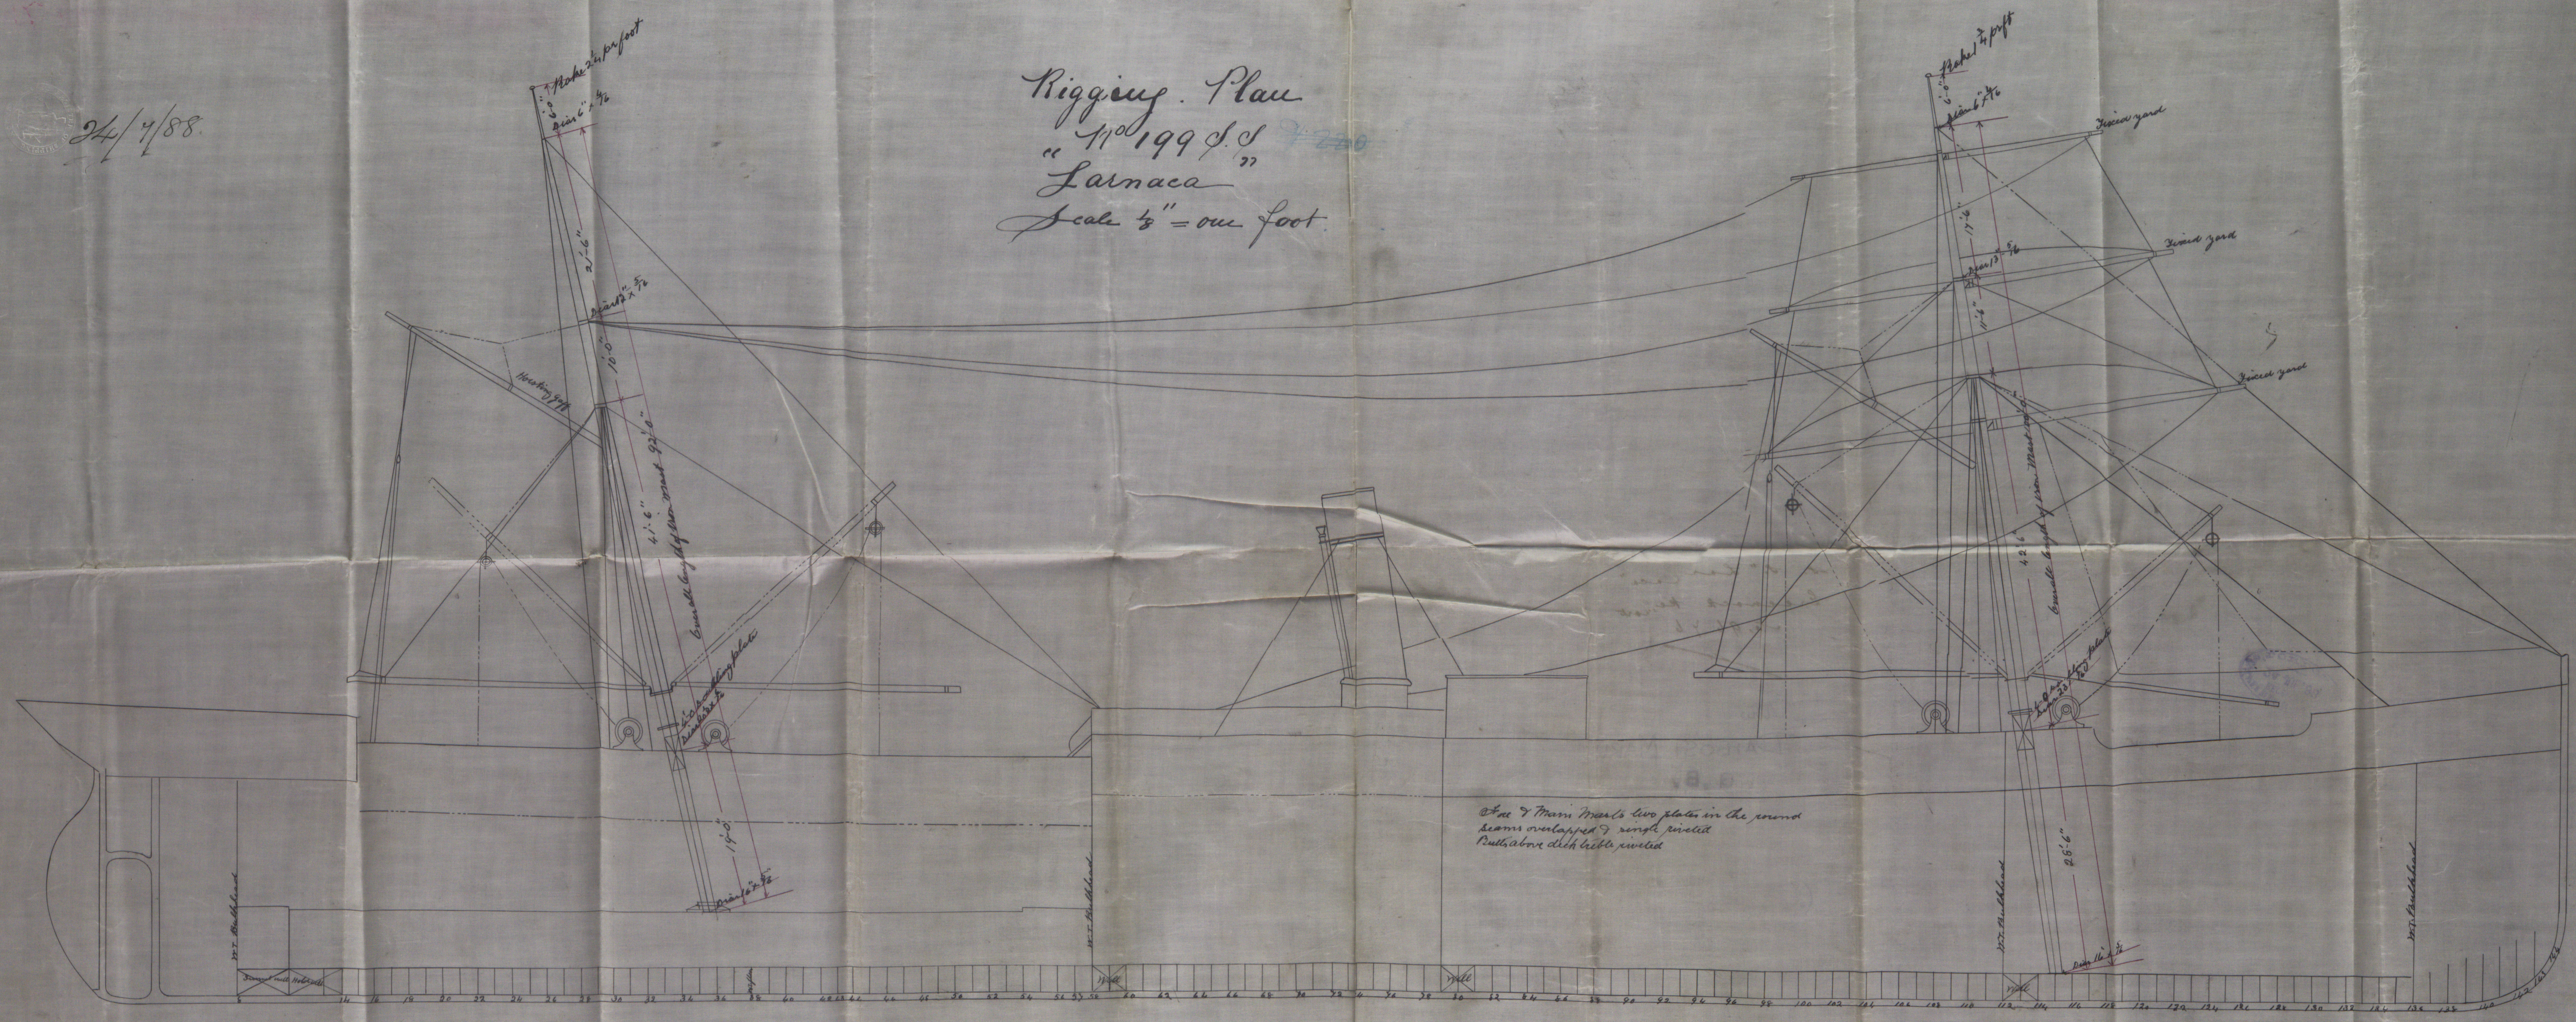


At the Main Mast's two plates in the round beams overlapped & rough riveted. But above deck table riveted.

RUSSELL & CO.  
 SHIP BUILDERS  
 23 JULY 88  
 GLASGOW & GREENOCK

23 July 88  
 J.B.  
 LLOYD'S REGISTER  
 OF SHIPS  
 GREENOCK




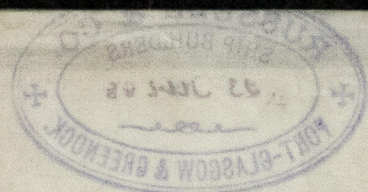


S. S. "Larvaca"  
Greenock report  
No. 96 & 6

How  
"DAIBOSI MARU"

Archd. B. 98


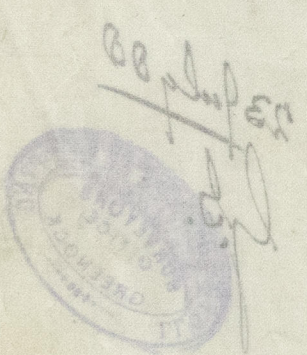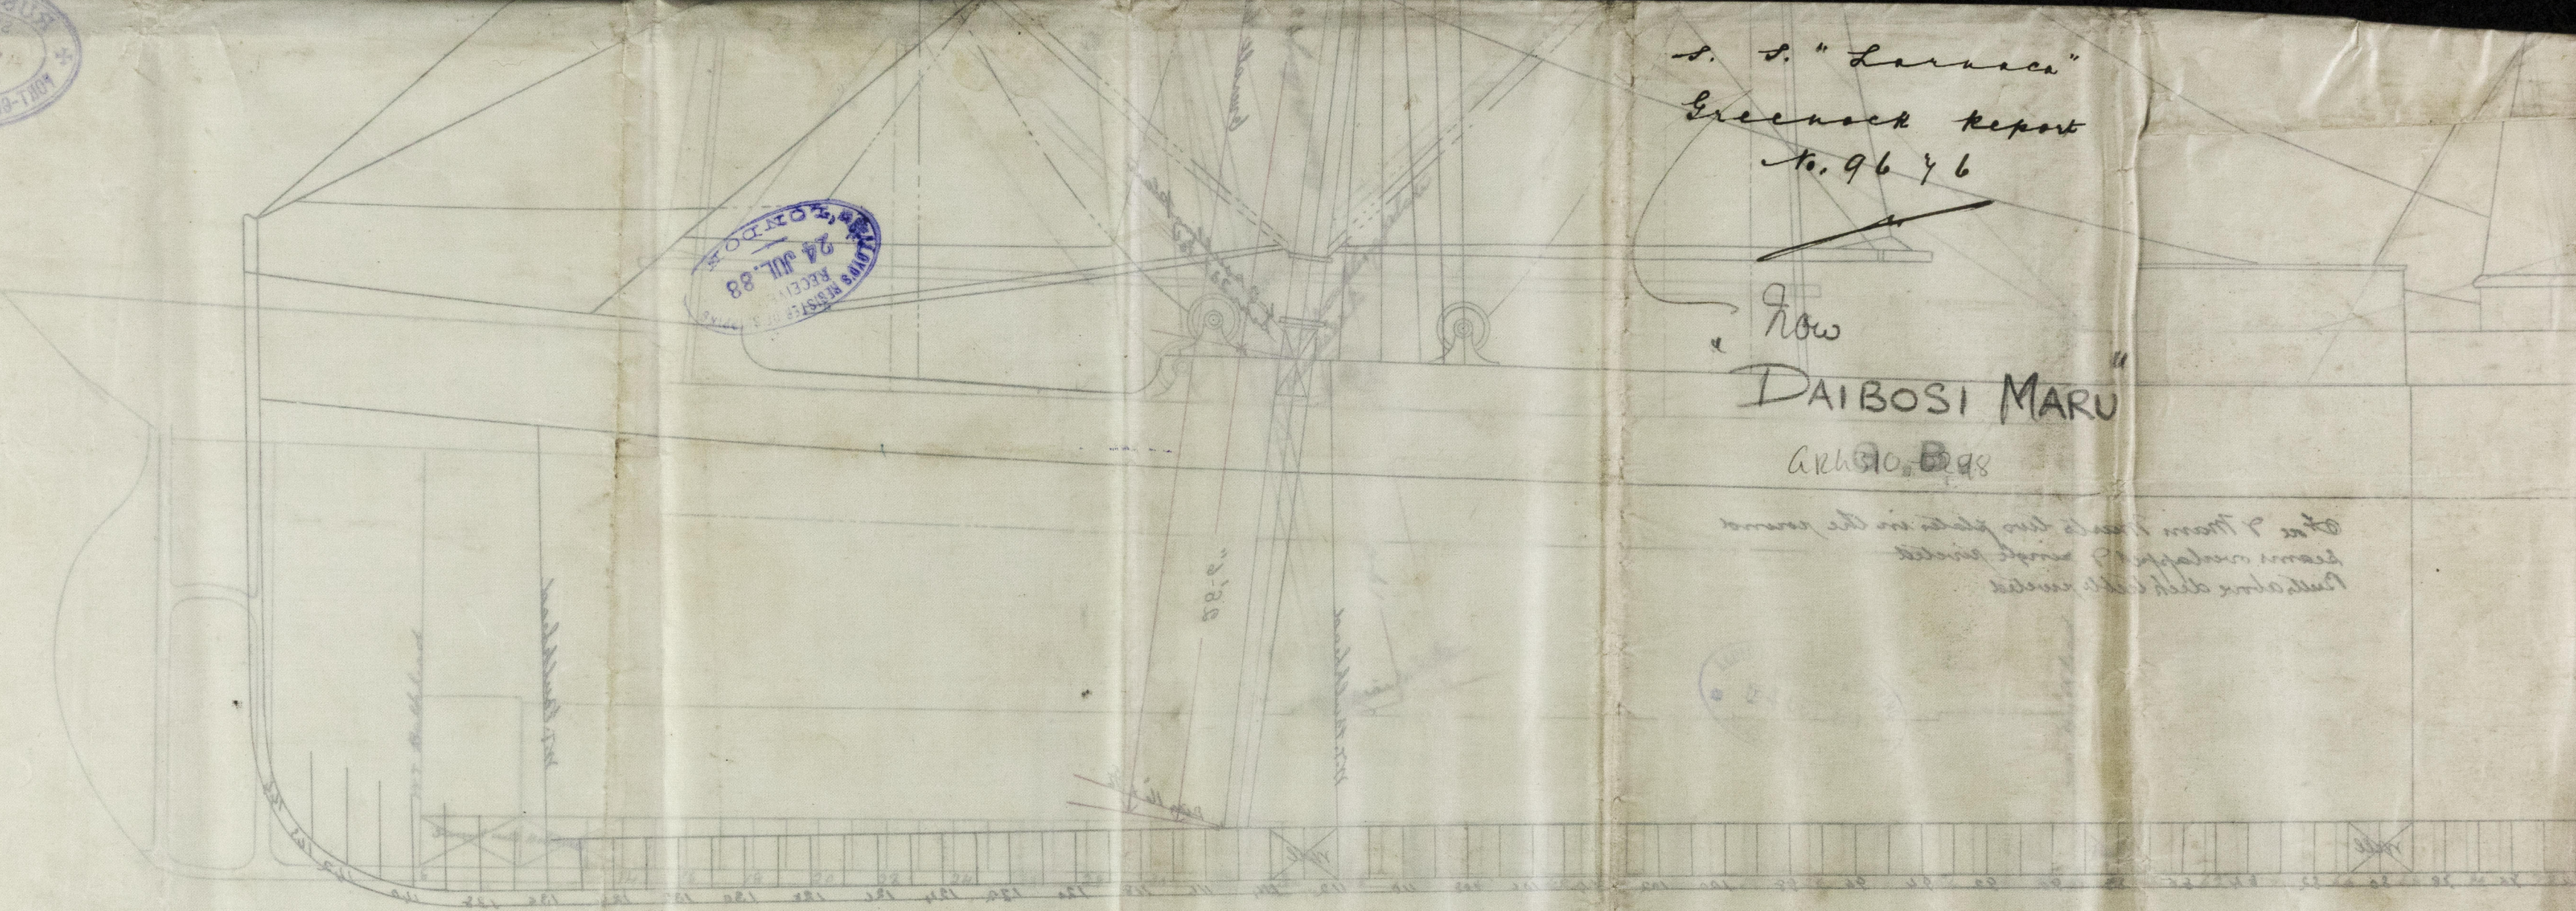

© 2020

Lloyd's Register  
Foundation