

# Lloyd's Register of British and Foreign Shipping.

(Report on Vessel No. 9676 Port Greenock)

No. 1809

## SHIP FORGINGS OR CASTINGS.

The words FORGINGS or CASTINGS, IRON or STEEL, should be struck out as may be required.

I have to report that the undermentioned ~~Iron or Steel Forgings or Castings~~, manufactured by The Dennytown Forge Co. of Dumbarton, for the Vessel No. 199, being built by Messrs Russell & Co. of Port Glasgow, have been inspected by me as set forth below, and found to be, so far as can be seen, sound and efficient.

Mark on Forgings.


Lloyd's  
No. 1809  
G.N.

*George Newcomb*  
*Glasgow*

*21/9/88*

	STERN FRAME.	RUDDER FRAME.	STEM & Keel.
Material*	<i>Scrap iron.</i>	/	<i>Scrap iron.</i>
How made	<i>Forged.</i>		<i>Forged.</i>
Dimensions	<i>10 x 6".</i>		<i>10 x 2 3/4"</i>
Progress on Inspection	<i>Forging &amp; smithing</i>		<i>Forging</i>
Dates when Inspected	<i>2.6.9.14.21.28/8/88. 5.10.17/9/88.</i>		<i>2.6.9.13.14/8/88. 14.19/9/88.</i>

SKETCHES OF FRAMES SHEWING POSITION AND DESCRIPTION OF WELDS OF FORGINGS, OR PARTICULARS OF TESTS APPLIED TO CASTINGS.

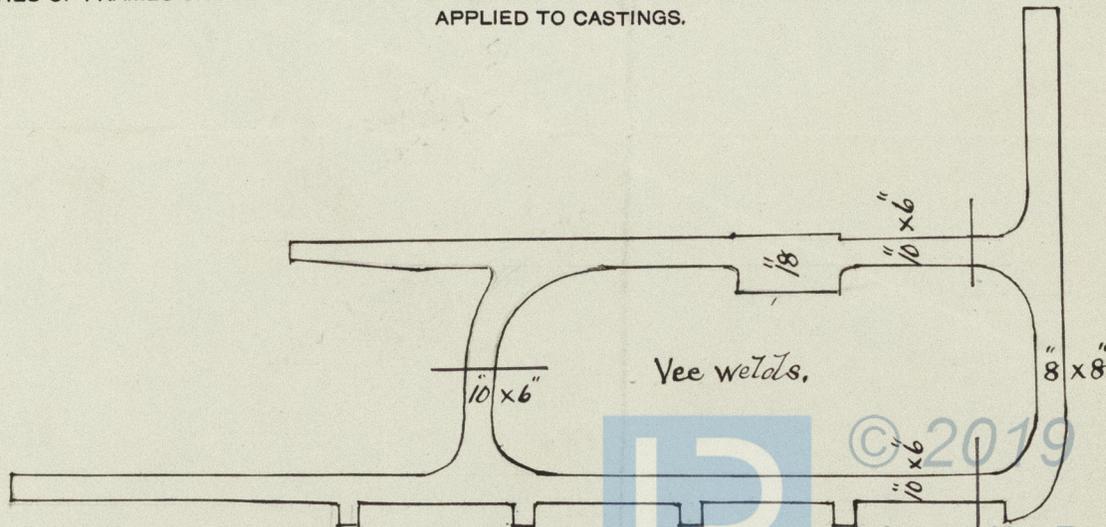

\* If of Iron, state whether scrap or puddled Iron.

