




S.S. "Baron Elbank"
Greenock Report No. 9727.
STEEL MASTS & YARD
S. S. No 101.

MON 22 OCT 98

Steel plates to be efficiently strengthened

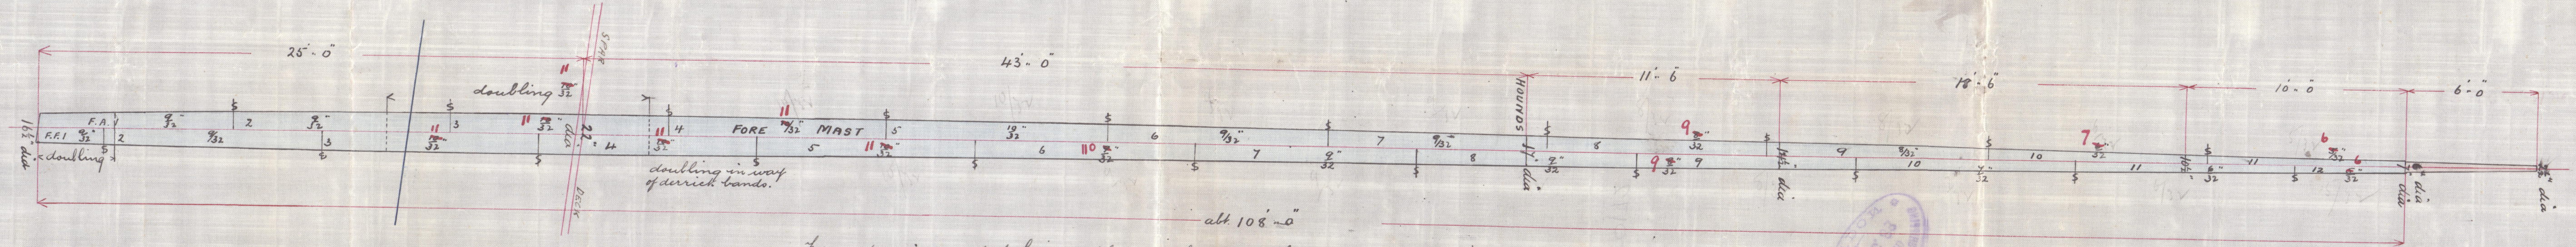

Fore and main masts to have 2 plates in the round, butt straps 1/2" thicker than the plates they connect. Butt straps treble riveted. Landing edges overlapped 3 3/8" and zigzag riveted in lower masts.
Landings above cap to be single riveted (2 1/4" wide)

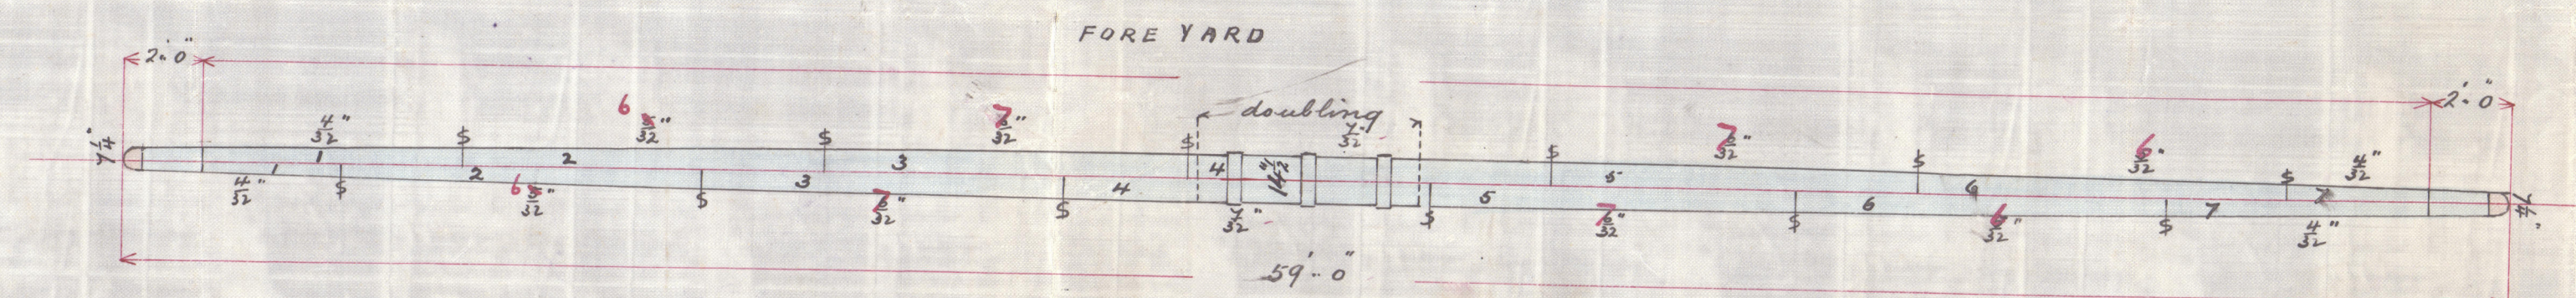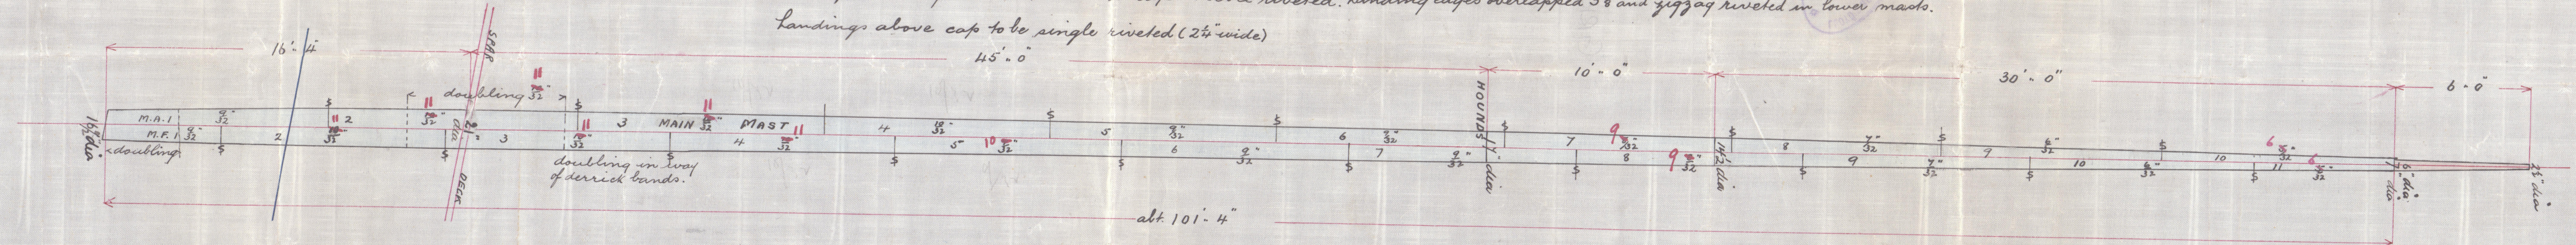

DRAWING No 1133.
SCALE 1/4 INCH TO A FOOT.

St. J. B.
22/10/88



C. F.
19/10/88

