



MON 22 OCT 88

*S.S. "Baron Elcank"  
Greenock Deposits 9727*

NO 130 88 100


RIGGING PLAN  
S.S. N° 101.

GRK311-0112

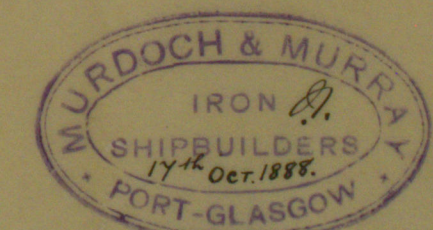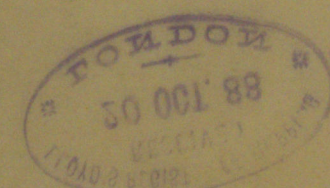

DRAWING N° 1134  
SCALE 1/2 INCH TO A FOOT.


*24/10/88*

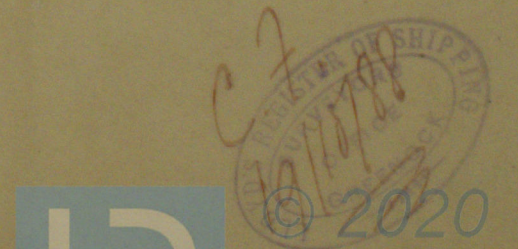



*Handwritten red ink scribbles*

101

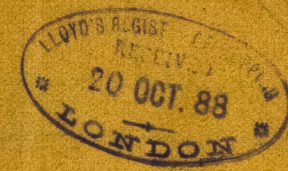

GRK311-0173



© 2020

Lloyd's Register  
Foundation