



*S.S. "Baron Eliban"*  
*Greenock Report No. 9727.*  
 PROFILE OF STEEL SCREW STEAMERS  
 No. 101 - 102


THU 20 SEP 88

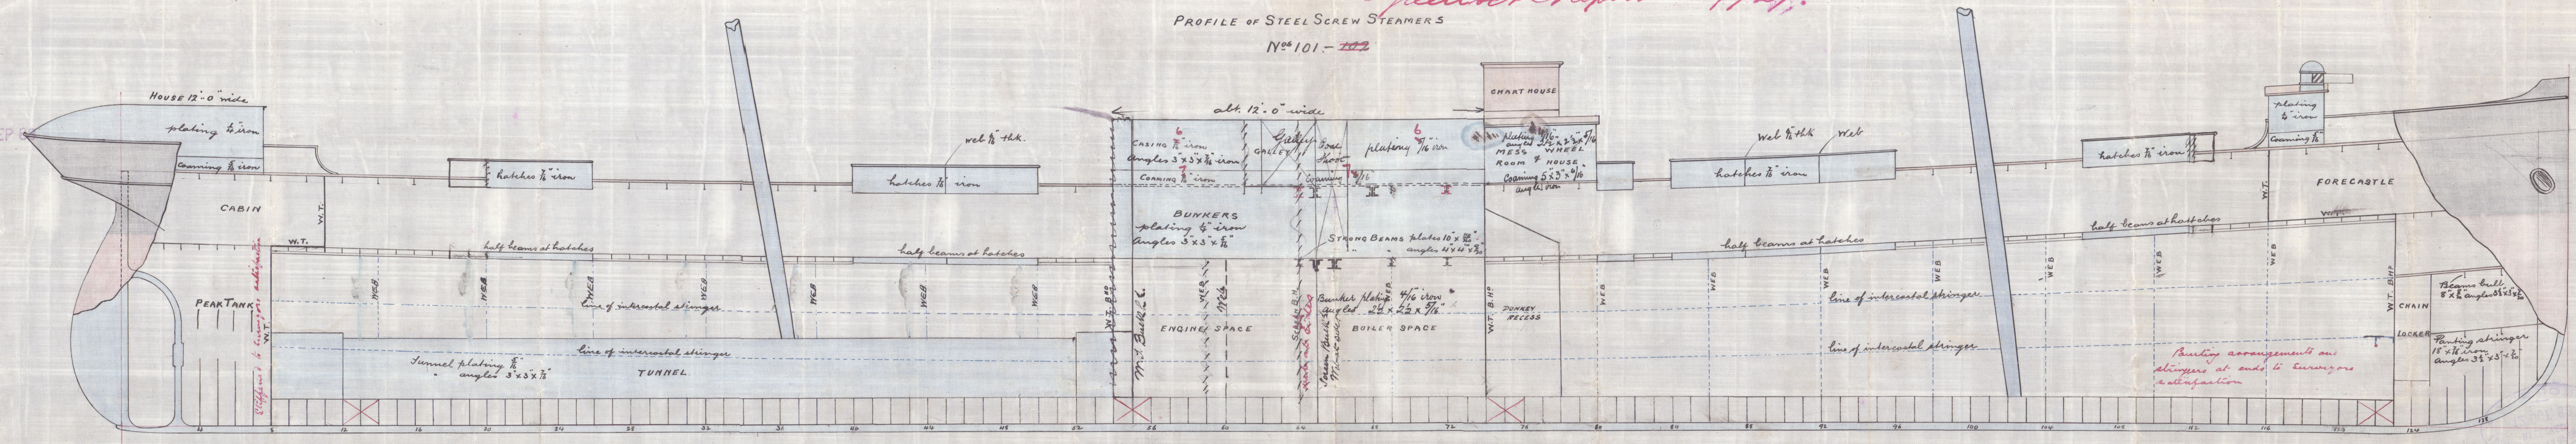

**SPAR DECK.** *all Reverse frames in way of house brought to spar deck.*

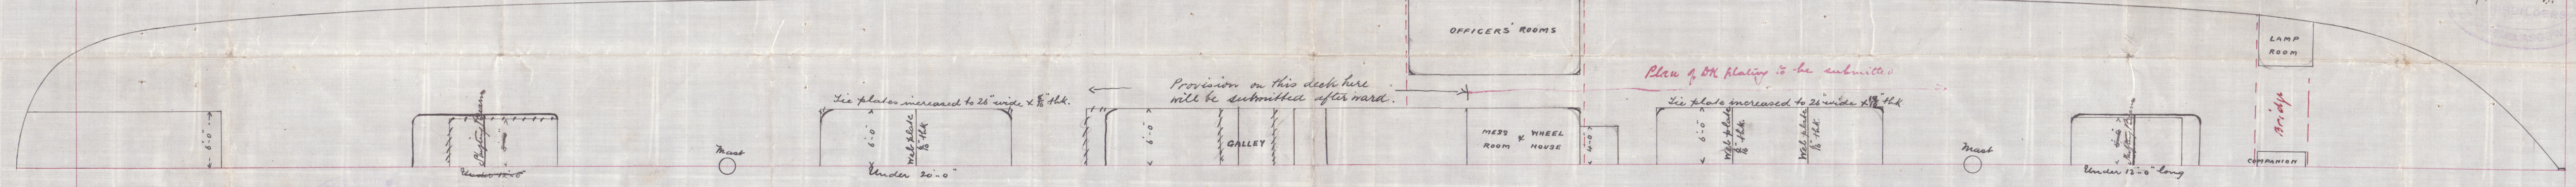

**MAIN DECK**

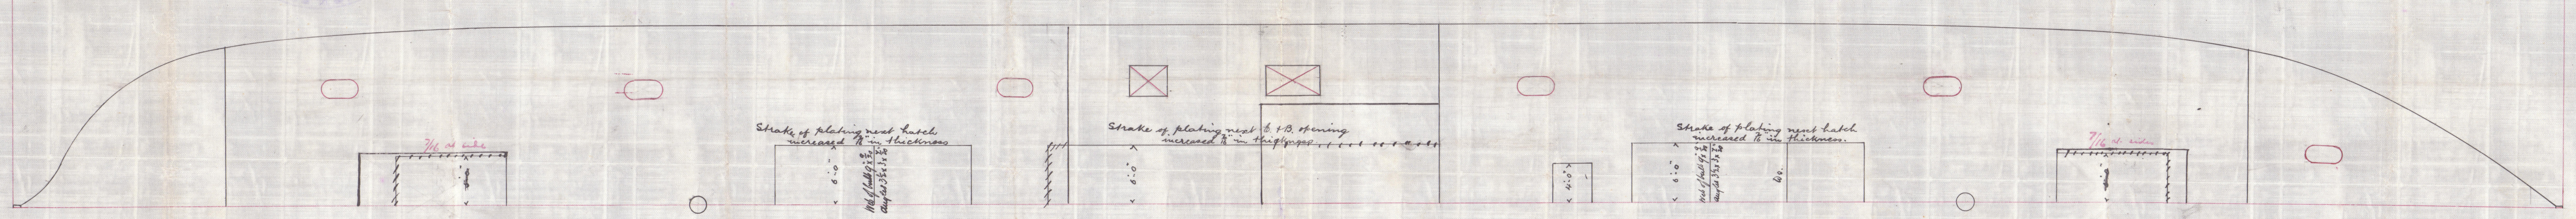

DRAWING No. 1110  
 SCALE 1/8 INCH TO A FOOT.

*JDL*  
 20/9/88

*C.F.*  
 18/9/88

GRK311-017






14/10/88



GAX311-0177

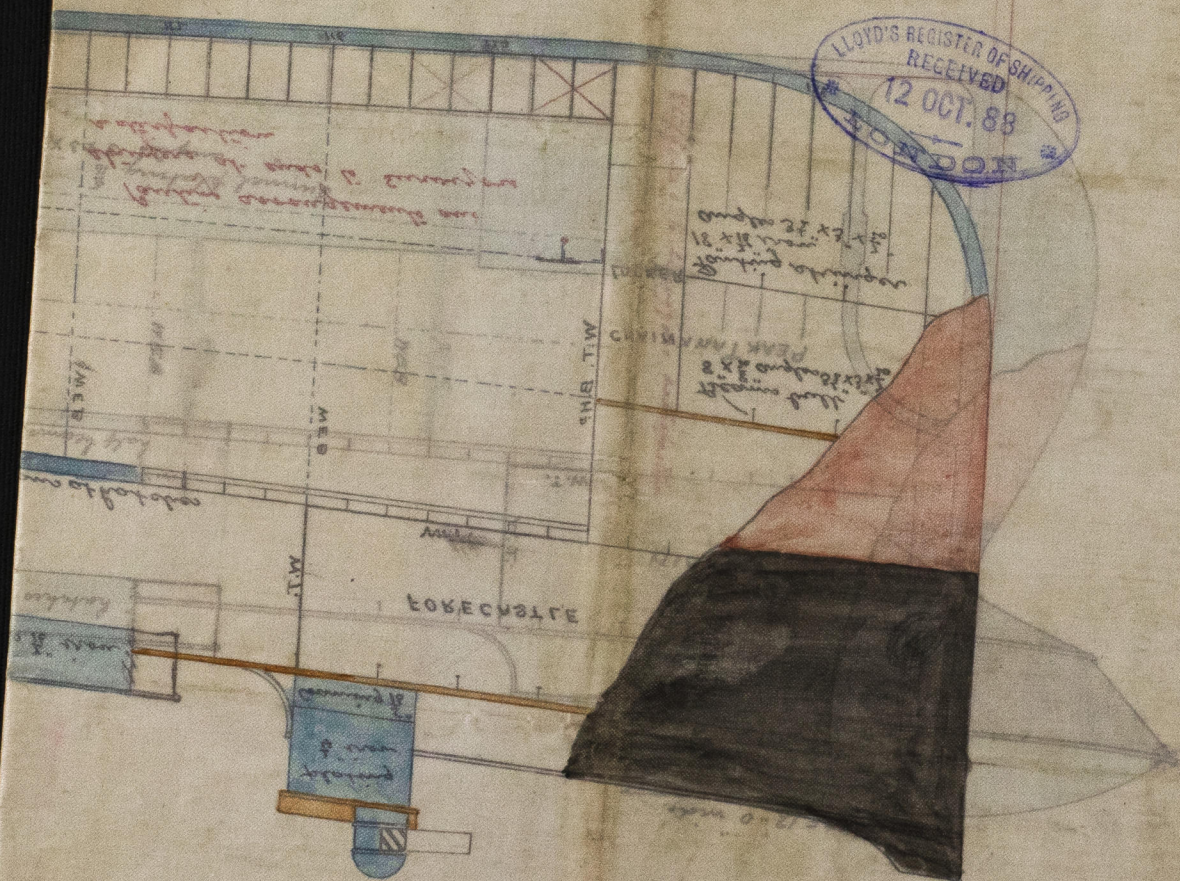

© 2020

Lloyd's Register  
Foundation