

SAT 13 OCT 83

No 202 - steel barque (4 masts) 'Craigend'; G.R. Rept. No. 7693.  
 No 216 " " " 'Stanley'; - - - - - 9830  

**RIGGING PLAN**  
**No 202**


SCALE 1/4" = ONE FOOT

Under Deck Lumber 2120

The main & Bygon



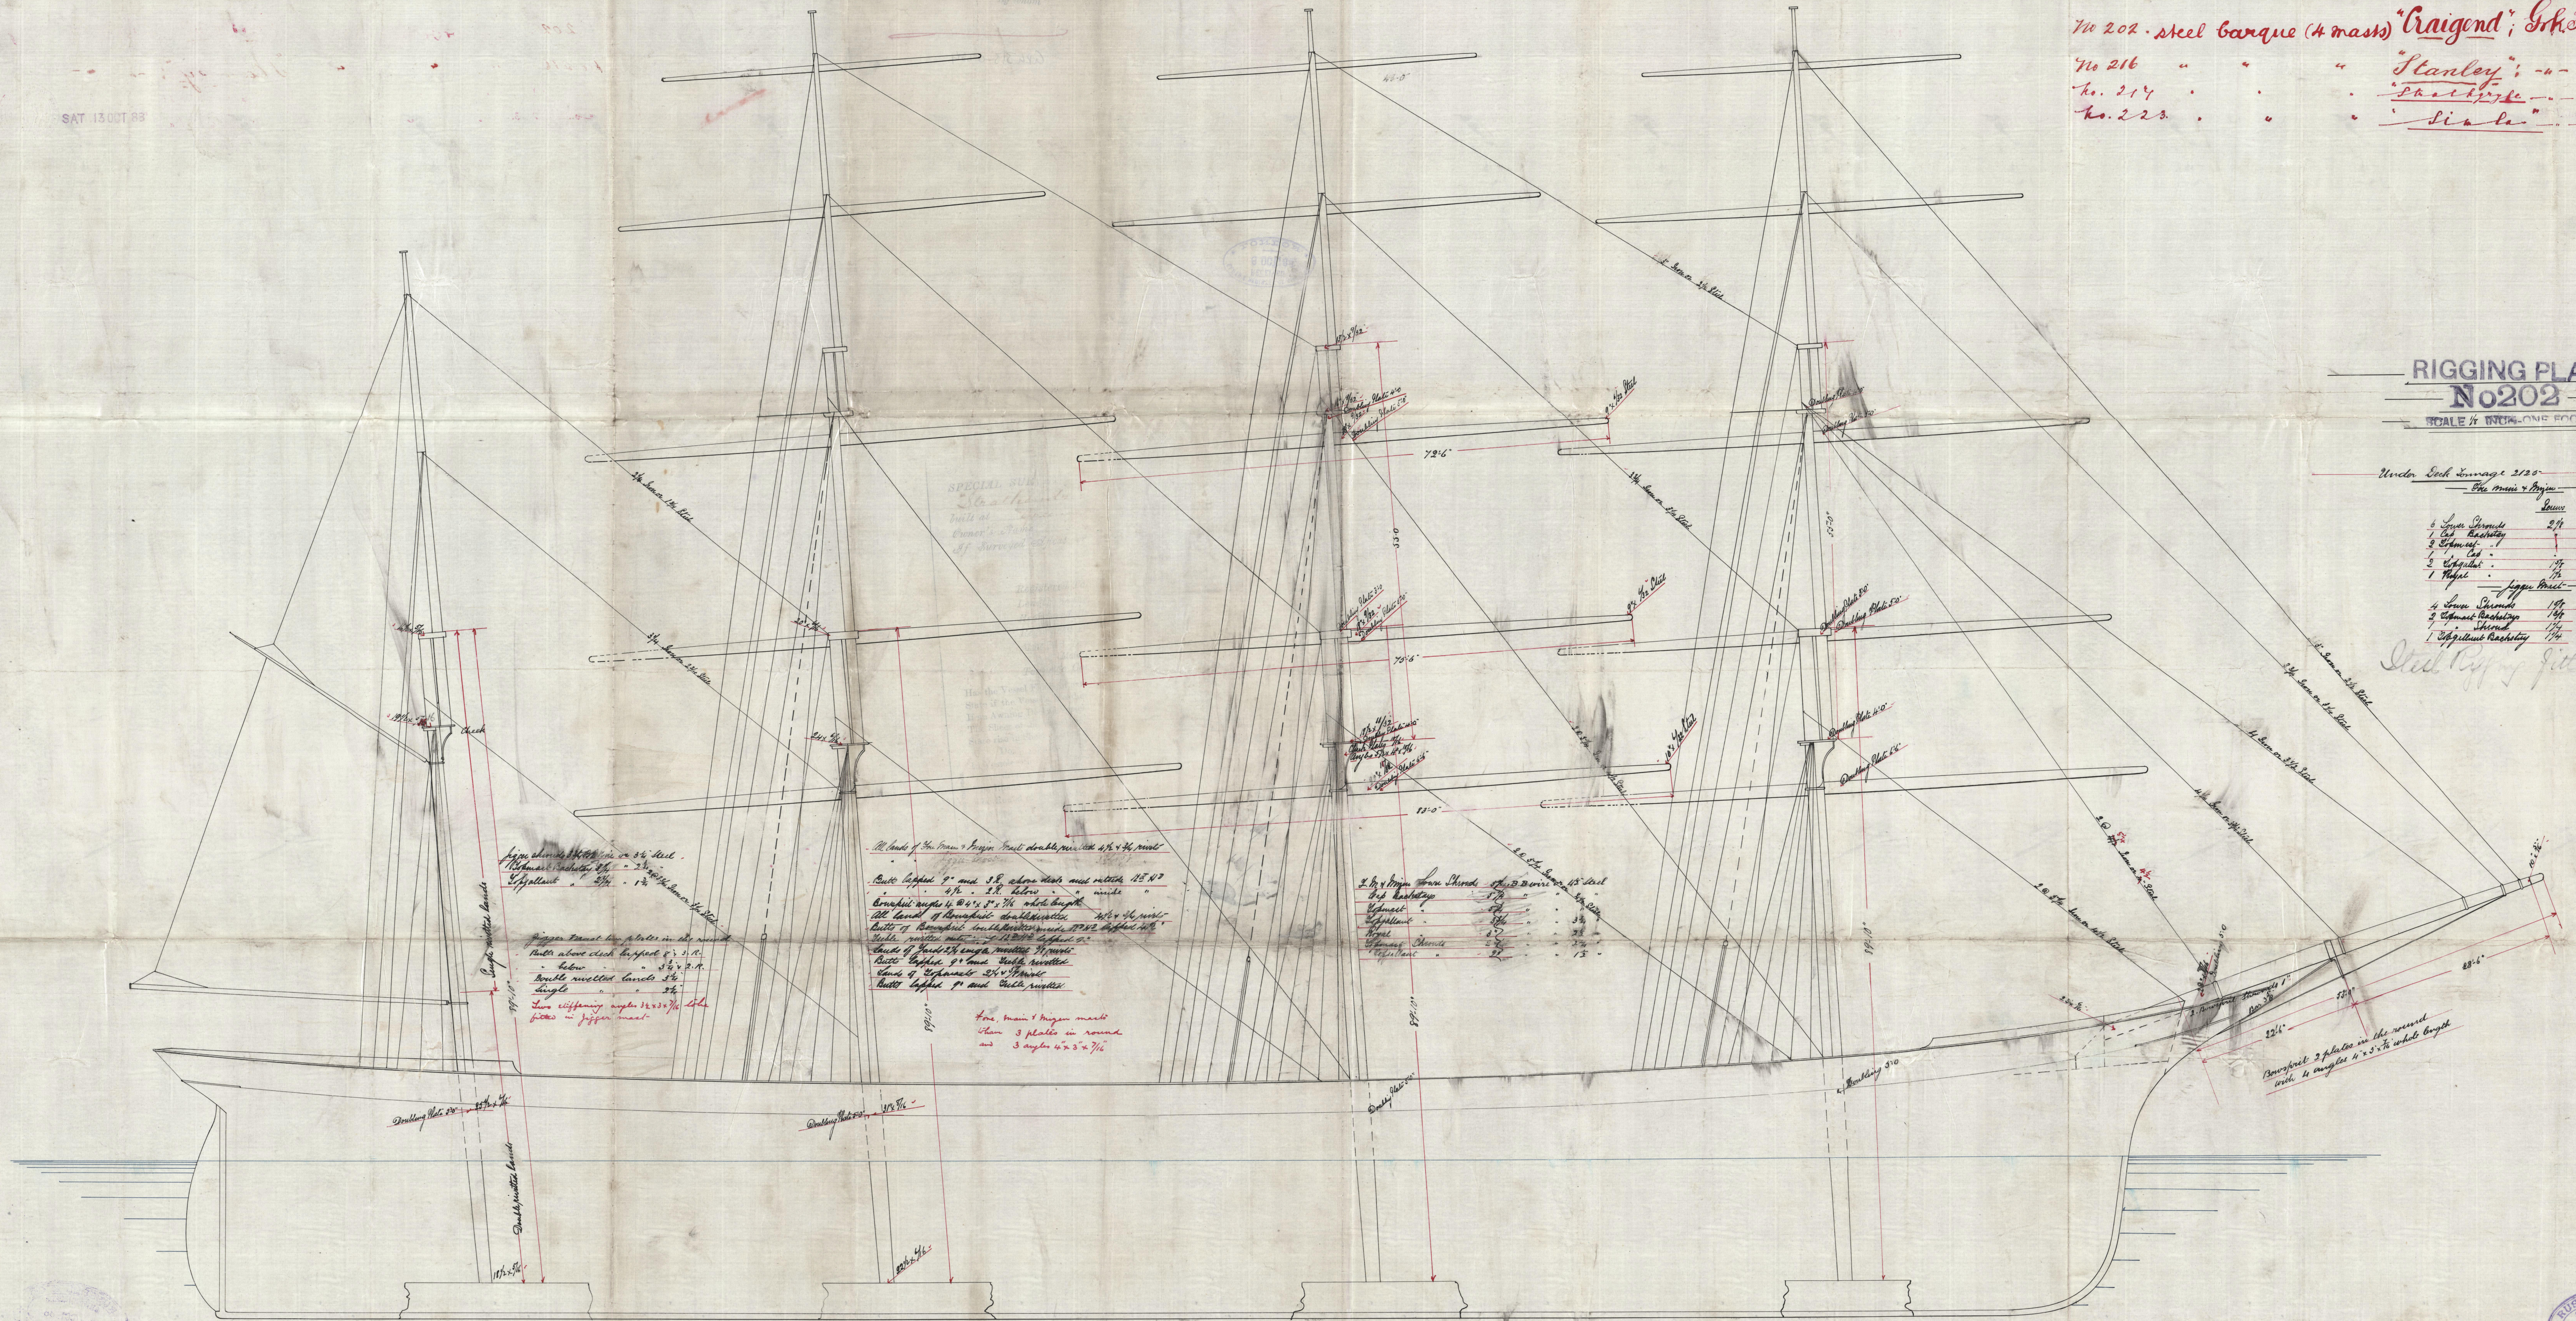

Shells & masts efficiently strengthened.





(202) " Craigend. LURK 9693  
(216) " Stanley " - 9830  
(217) " Strathgryfe " - 9894  
223. " Simla " - 9906  

ARK 313-0784



© 2020

Lloyd's Register  
Foundation