

Russell & Co.
17th July 1899.

No 217. "Strathgryffe". Steel Barque 4 masts.


MIDSHIP SECTION

No 216 17 & 23

No 216 - Stanley. Steel Barque. (4 masts.)
Greenock Report No. 9830
No 217 - "Strathgryffe". Steel Barque (4 masts.)
Junk Report No.

Reg. Dim. 278 x 41'11" x 24'4"

SCALE 1/2" = 1'0"

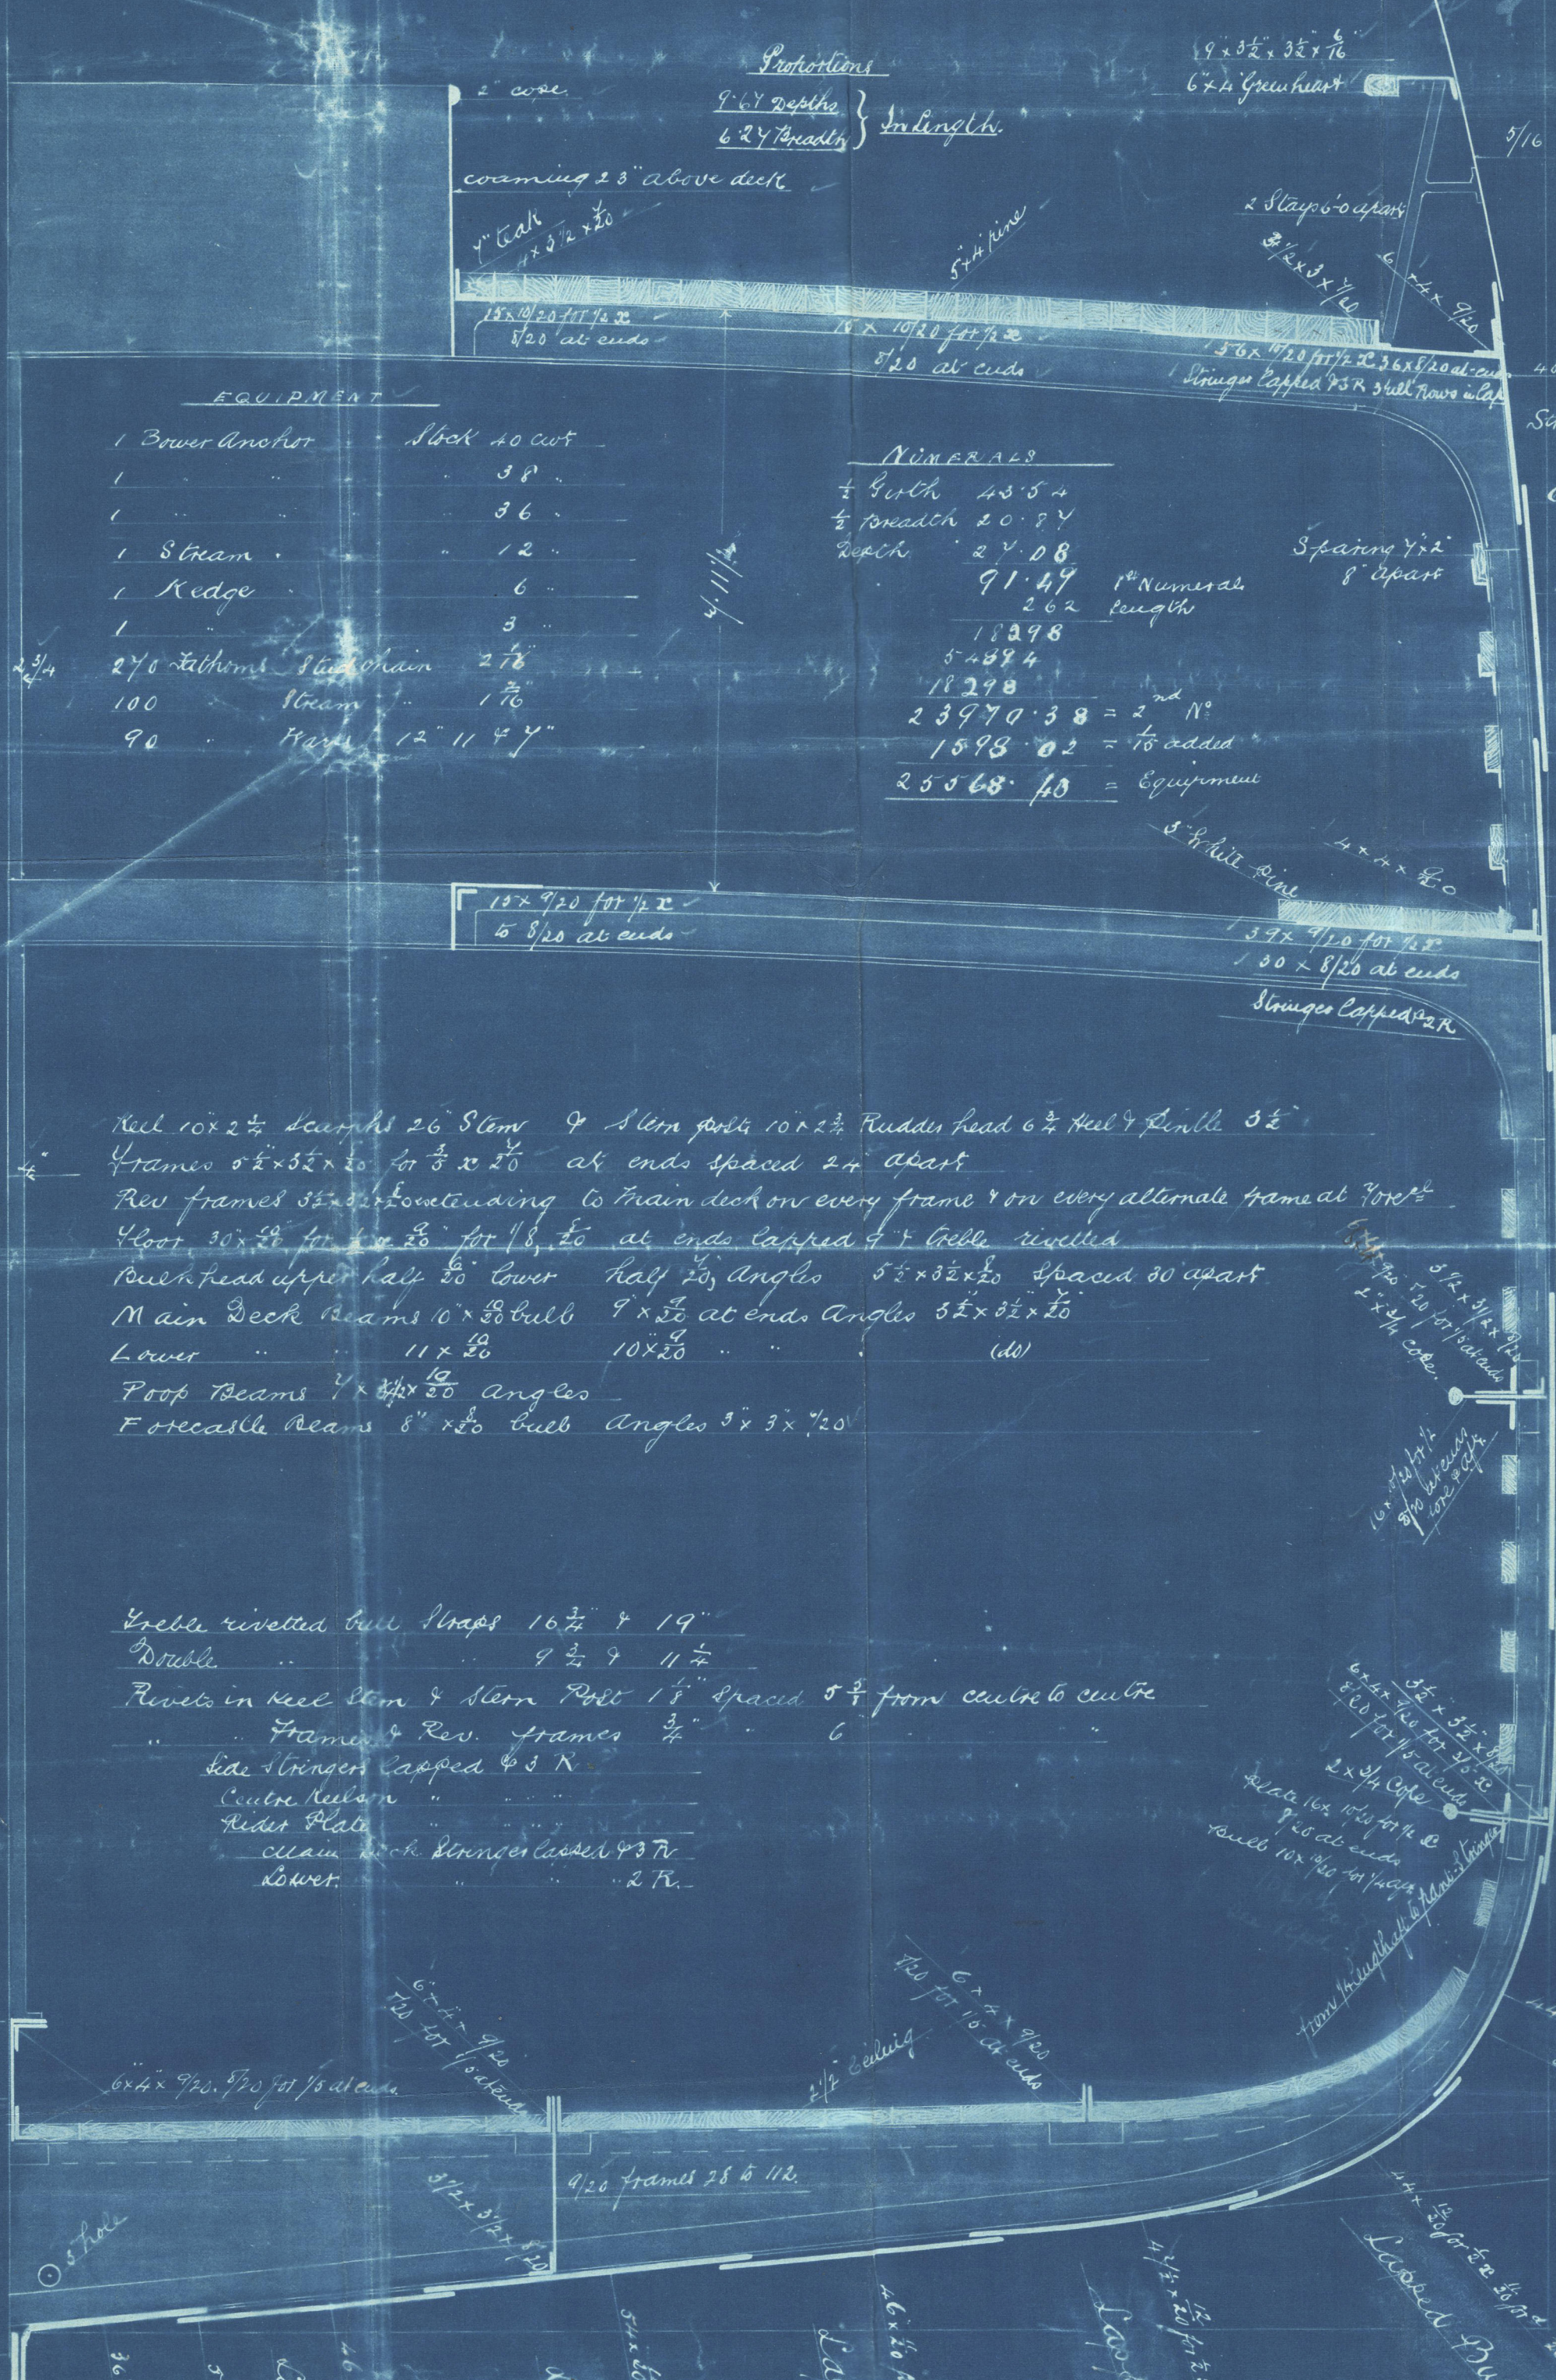

EQUIPMENT

1 Bower Anchor	Stock 40 cwt
1 "	38 "
1 "	36 "
1 Stream	12 "
1 Kedge	6 "
1 "	3 "
270 Lathams Steel Chain	2 1/2 "
100 "	1 1/2 "
90 "	12 " 11 1/2 "

NUMERALS

1/2 Bulk	43.54
1/2 Foredeck	20.84
Deck	24.08
	91.49
	262
	18298
	54884
	18298
23970.38	= 2 nd N ^o
1598.03	= 10 added
25568.40	= Equipment

Keel 10 x 2 1/2. Scams 26. Stem 9. Stern post 10 x 2 1/2. Rudder head 6 1/2. Keel & Plank 5 1/2.
Frames 5 1/2 x 5 1/2 x 10 for 3 x 20 at ends spaced 24" apart.
Rev frames 5 1/2 x 5 1/2 x 10 to main deck on every frame & on every alternate frame at 20 x 20.
Floor 30 x 30 for 10 x 20 for 18" to at ends capped & 4" Gills rivelled.
Bulk head upper half 50. Lower half 20. Angles 5 1/2 x 5 1/2 x 20 spaced 30 apart.
Main Deck Beams 10 x 30 bulb 7 x 20 at ends Angles 5 1/2 x 5 1/2 x 20.
Lower 11 x 20 10 x 20 (all).
Poop Beams 7 x 20 Angles.
Forecastle Beams 8 x 20 bulb Angles 5 x 3 x 20.

Keels rivelled Bull Straps 16 1/2" & 19".
Double 9 1/2" 11 1/2".
Rivets in keel stem & stern Post 1 1/2" spaced 5 1/2" from centre to centre.
Frame & Rev. frames 3/4" 6".
Side Stringer capped 4 3/4" R.
Centre Keelson " "
Rider Plate " "
clean deck Stringer capped 4 3/4" R.
Lower " " 2 R.

5/16 in way of Roof and Yell.

Straps 1/2" thicker for 3 x 20 & 3 x 20 at ends & 2 R.

6 Land 1 mile

46 x 10 for 20 20 for 20 20 for 20
all Straps 3 R above 40
Straps above 40 1/2" thicker for 2 R
at ends 1/2"

5 Land 1 mile

54 x 10 for 20 20 for 20 20 for 20
all Straps 3 R above 48
Straps above 48 1/2" thicker for 2 R
at ends 1/2"




Approved for approval
under Sec. 7 of the Act
11/7/99
11/7/99

Wardens & Carpenters
11/7/99

Russell & Co No 217.
Strathgryffe. mid Sec

Glenoch Rept No.



GRN 313-0285



© 2020

Lloyd's Register
Foundation