

Marque "Strathgryfe"

Received at _____ Office, _____ 18

Lloyd's Register of British and Foreign Shipping.

(Report on Vessel No. 9894 Port Greenock)

No. 2110

SHIP FORGINGS OR CASTINGS.

I have to report that the undermentioned Iron or Steel Forgings or Castings, manufactured by The Irvine Forge Co of Strathgryfe for the Vessel No. 217, being built by Messrs Russell & Co of Port Glasgow have been inspected by me as set forth below, and found to be, so far as can be seen, sound & efficient

The words FORGINGS or CASTINGS, IRON or STEEL, should be struck out as may be required.


Mark on Forgings.

Lloyd's
No. 2110
WH

William Hamilton
Glasgow
20/12/89

	STERN FRAME.	RUDDER FRAME.	STEM.
Material*	/	Scrap iron	/
How made	/	Forged.	/
Dimensions	/	6 3/4 to 3 1/2 dia	/
Progress on Inspection	/	Forging & smithing	/
Dates when Inspected	/	9.13.20/8/89. 4.20/9/89. 4.7 19.29/11/89. 18/12/89	/

SKETCHES OF FRAMES SHEWING POSITION AND DESCRIPTION OF WELDS OF FORGINGS, OR PARTICULARS OF TESTS APPLIED TO CASTINGS.

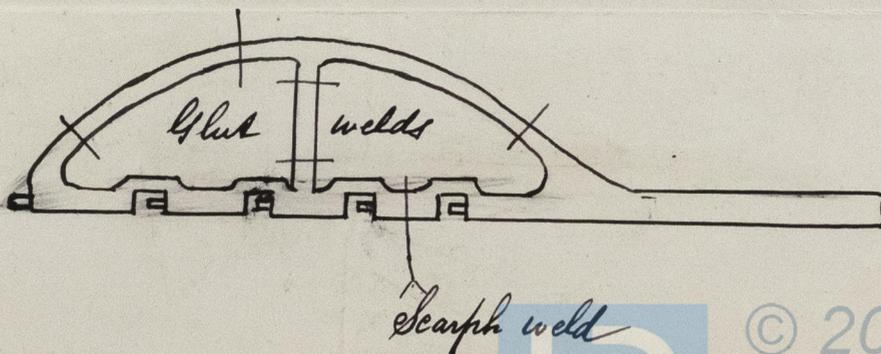

© 2019
Lloyd's Register
Foundation
21/12/89
W.H.
ARH 303-0257

* If of Iron, state whether scrap or puddled Iron.




Russell & Co. Bk. no 217.
Report Forging Rudder frame

Stralhyffe





© 2019

Lloyd's Register Foundation

