

Ship *Edenburgh*

Received at \_\_\_\_\_ Office \_\_\_\_\_ 18

# Lloyd's Register of British and Foreign Shipping.

(Report on Vessel No. *9908* Port *Breenvick*)

## No. *2163* SHIP FORGINGS ~~OR CASTINGS~~.

The words FORGINGS or CASTINGS, IRON or STEEL, should be struck out as may be required.

I have to report that the undermentioned Iron ~~or Steel~~ Forgings ~~or Castings~~, manufactured by *The Irvine Forge Co* of *Irvine* for the Vessel No. *224*, being built by *Messrs Russell & Co* of *Port Glasgow* have been inspected by me as set forth below, and found to be, so far as can be seen, *Sound & efficient*


Mark on Forgings.

Lloyd's  
No. *2163*  
WH

*William Hamilton*  
*Glasgow*  
*15/2/90*

	STERN FRAME.	RUDDER FRAME.	STEM.
Material*	/	<i>Scrap iron</i>	/
How made		<i>Forged</i>	
Dimensions		<i>6 3/4 dia to 3 1/4 dia</i>	
Progress on Inspection		<i>Forging &amp; smithing</i>	
Dates when Inspected		<i>29/9/90. 6. 12/2/90</i>	

SKETCHES OF FRAMES SHEWING POSITION AND DESCRIPTION OF WELDS OF FORGINGS, OR PARTICULARS OF TESTS APPLIED TO CASTINGS.

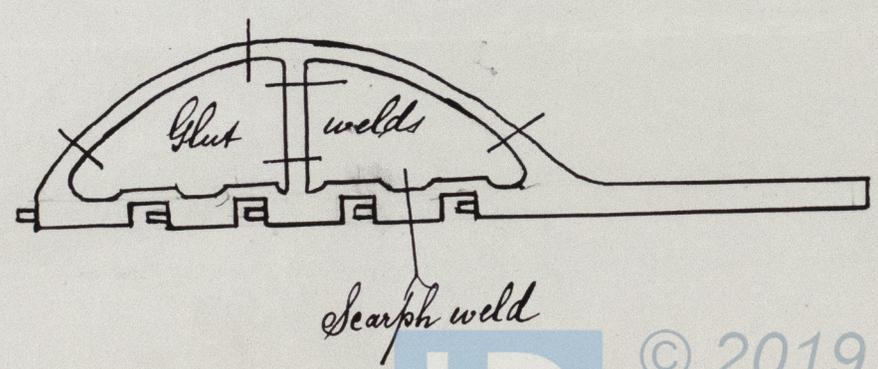

© 2019  
Lloyd's Register  
Foundation

\* If of Iron, state whether scrap or puddled Iron.

GRK314-0030