

Ship "Edenborough"

Received at _____ Office _____ 18

Lloyd's Register of British and Foreign Shipping.

(Report on Vessel No. 9908 Port Brecon)

No. 2163 SHIP FORGINGS ~~OR CASTINGS.~~

The reports FORGINGS or CASTINGS, IRON or STEEL, should be struck out as may be required.

I have to report that the undermentioned Iron ~~or Steel~~ Forgings or Castings, manufactured by The Irvine Forge Co of Irvine for the Vessel No. 224, being built by Messrs Russell & Co of Port Glasgow have been inspected by me as set forth below, and found to be, so far as can be seen, sound and efficient.


Mark on Forgings.

Lloyd's
No. 2163
G.N.

George Newcomb
Glasgow 6/6/89

	STERN FRAME.	RUDDER FRAME.	STEM.
Material*	Scrap iron	/	Scrap iron
How made	Forged		Forged
Dimensions	9 x 2 1/2		Stem 9 x 2 1/2 Keel 9 1/2 x 2 1/2
Progress on Inspection	Forging & smithing		Forging
Dates when Inspected	30/4/89, 24.28/5/89		3.8.11.19.25.30/4/89.

SKETCHES OF FRAMES SHEWING POSITION AND DESCRIPTION OF WELDS OF FORGINGS, OR PARTICULARS OF TESTS APPLIED TO CASTINGS.

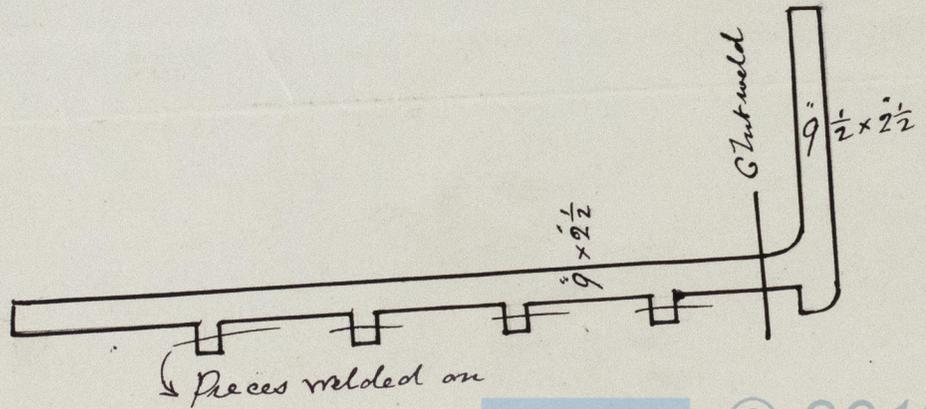

© 2019
Lloyd's Register
Foundation
GRK 314-0031

* If of Iron, state whether scrap or puddled Iron.