


Wm Hamilton & Co. S. S. N^o 70

Length on Awning Deck	244.0'
Breadth - - - - -	33.11
Depth of Hold to A.D.	21.9.

SAT 14 SEP 85
THU 19 SEP 85
TUE 1 OCT 85
MON 17 OCT 85
SAT 15 FEB 90

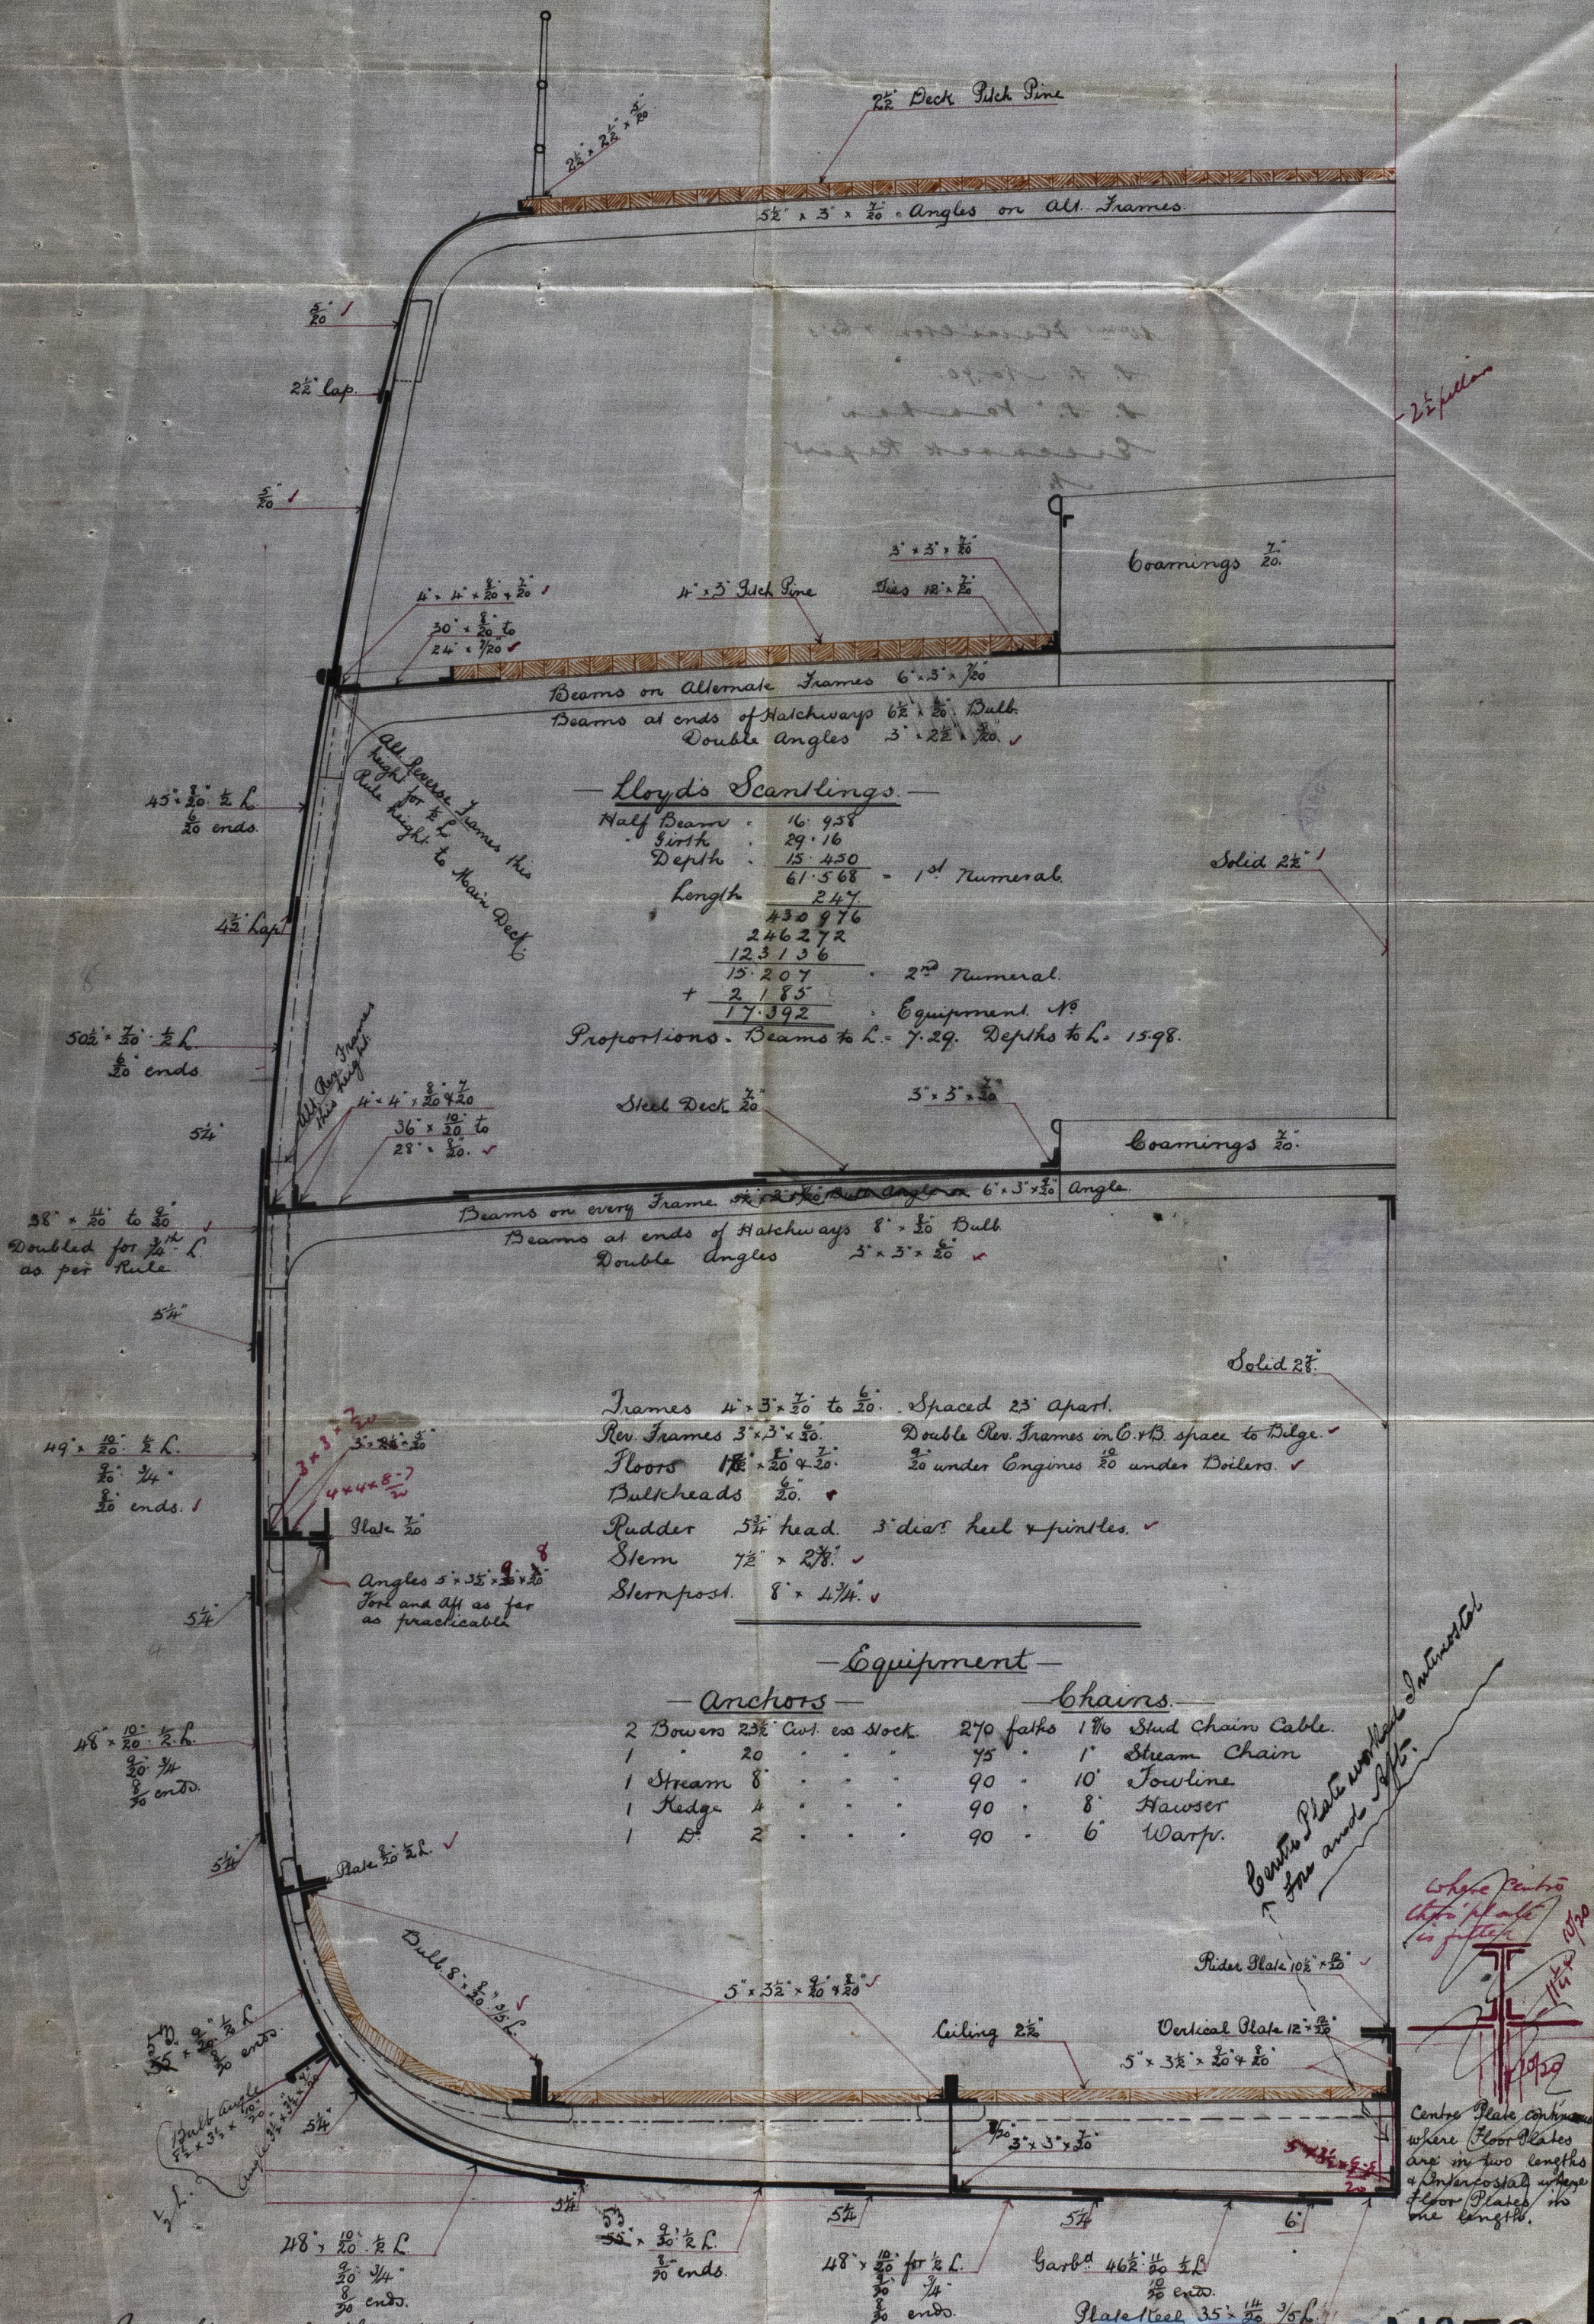

Butt Straps of Sheerstrake
Stringer plate and three strakes
at edges $\frac{3}{32}$ thicker than the plates
they connect.
Par. 11 Section 19. to be complied
with. *as regards breadth of plate &c*


Scale $\frac{1}{2}$ Inch. = one Foot.

-Nº 70-

2/21/98

Wm. Hamilton & Co's
S. S. No. 30.
S. S. "Vander"
Greenock Report
No.

GRK 314-0064

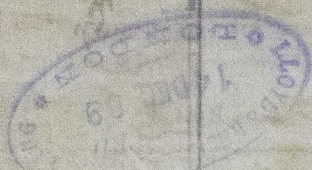

© 2019

Lloyd's Register
Foundation