




S. S. "Vauban"
Greenock Report No. 9912

—RIGGING PLAN.—
—S. S. N^o 70.—

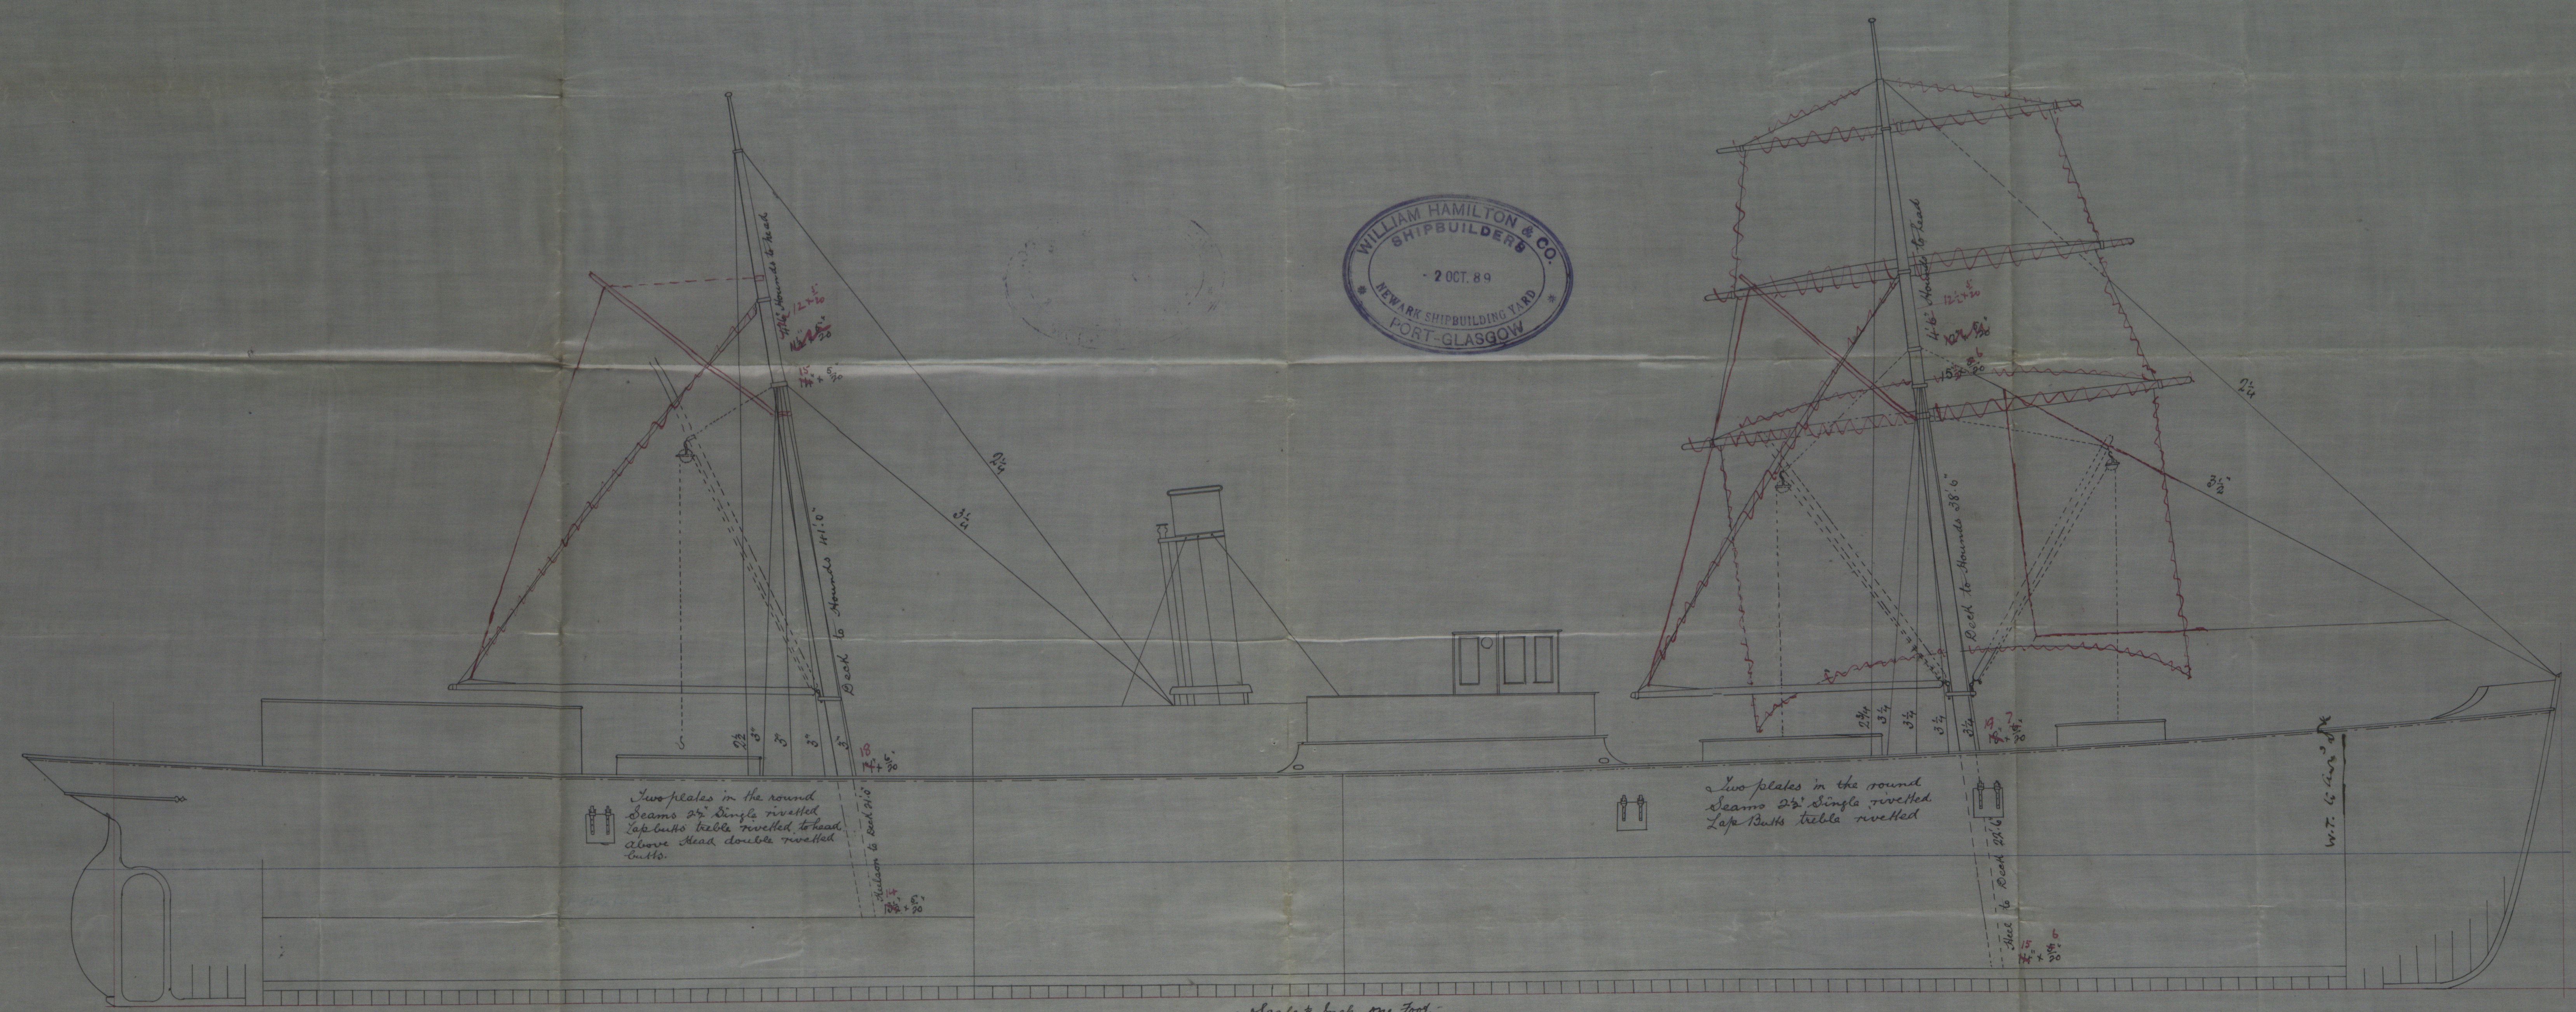

Scale 1/4 inch = one foot.


Masts & beams doubled in way of partners and efficiently strengthened at heels.

See Letter 7/10/89 R.

GRK 314-0065



S. S. "Fairbank"
Greenock Report
No. 9914

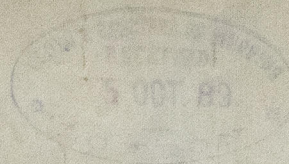

GRK314-0065



MON 5 OCT 89



© 2020

Lloyd's Register
Foundation