

S. S. "Kashan"

Received at

Office,

78

# Lloyd's Register of British and Foreign Shipping.

(Report on Vessel No. 9914 Port Greenock)

No. 2387

## SHIP FORGINGS OR CASTINGS.

The words FORGINGS or CASTINGS, IRON or STEEL, should be struck out as may be required.

I have to report that the undermentioned Iron or Steel Forgings or Castings, manufactured by Messrs Beardmore & Coy of Glasgow for the Vessel No. 70, being built by Messrs William Hamilton & Coy of Port Glasgow have been inspected by me as set forth below, and found to be, so far as can be seen, sound & efficient

Mark on Forgings.


Lloyd's  
No. 2387  
WH

William Hamilton

Glasgow  
12/10/89

	STERN FRAME.	RUDDER FRAME.	STEM.
Material*	Scrap iron	/	Scrap iron
How made	Forged		Forged
Dimensions	8 x 4 3/4		7 1/2 x 2 3/8
Progress on Inspection	Forging & Smithing		Forging & Smithing
Dates when Inspected	6.10.12.18.20.23.24/9/89		6/9/89. 2.7 10. 11/10/89

SKETCHES OF FRAMES SHEWING POSITION AND DESCRIPTION OF WELDS OF FORGINGS, OR PARTICULARS OF TESTS APPLIED TO CASTINGS.

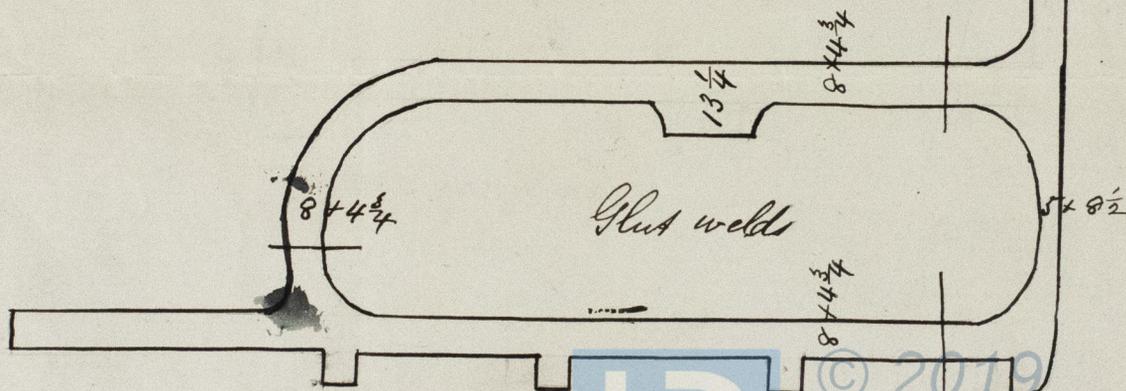

GRK314-0069












© 2019

Lloyd's Register  
Foundation