


— Proposed Arrangement of Stiffeners —
— for Bulkheads. —


S. S. "Vasdan"
Greenock Report No. 9914

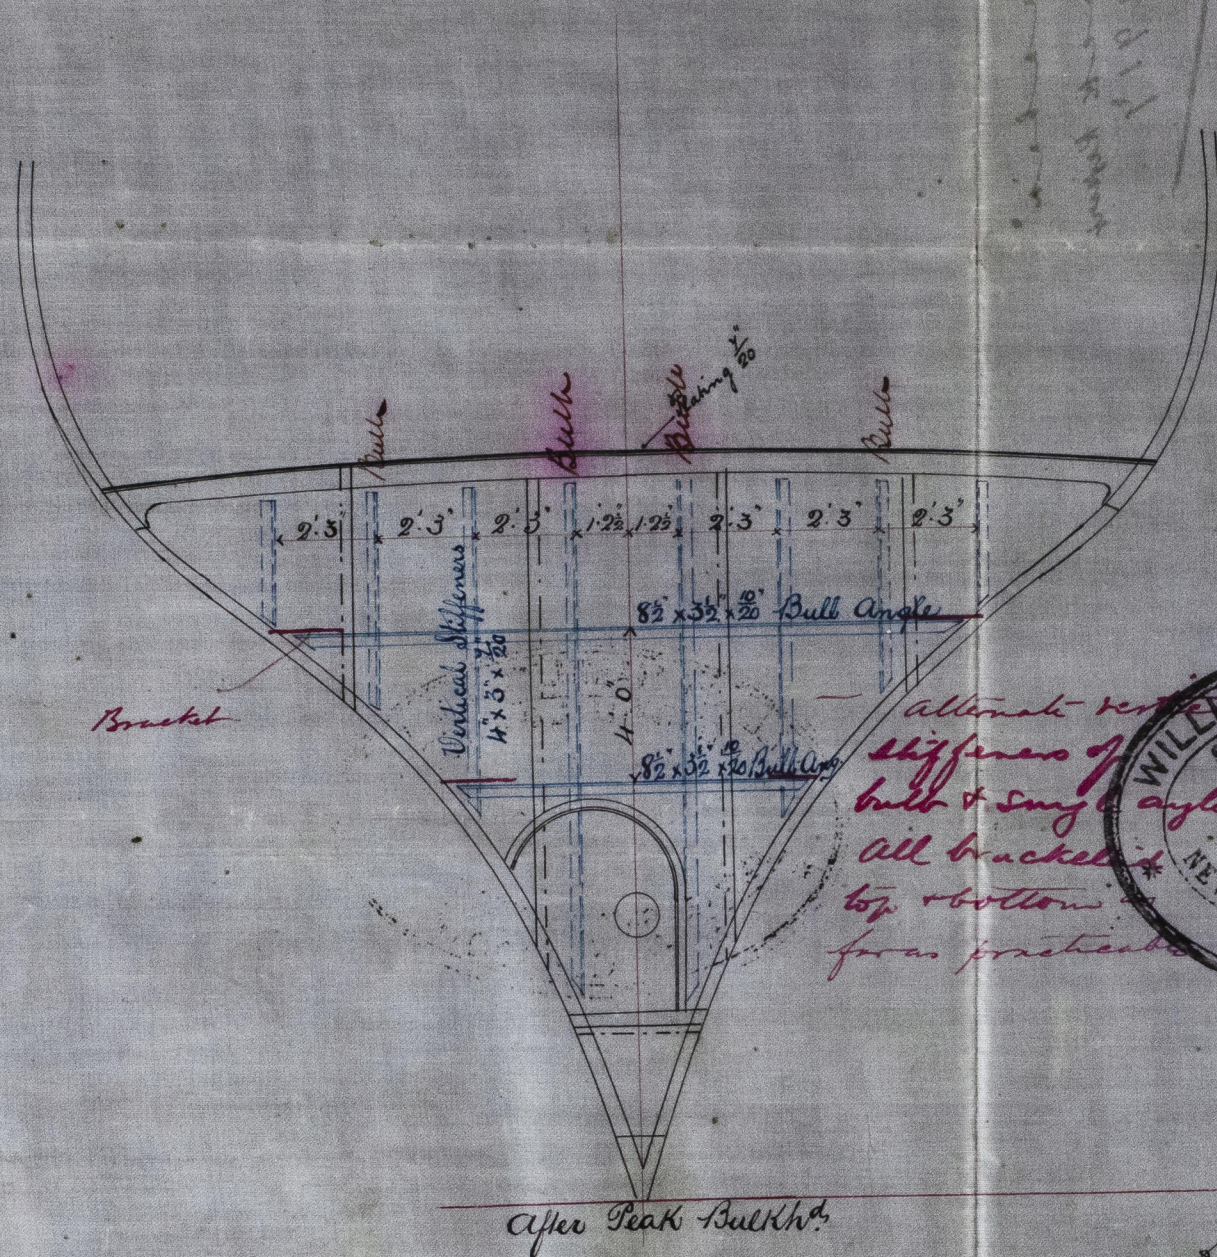

SAI 14 SEP 89



Scale $\frac{1}{4}$ Inch = One Foot

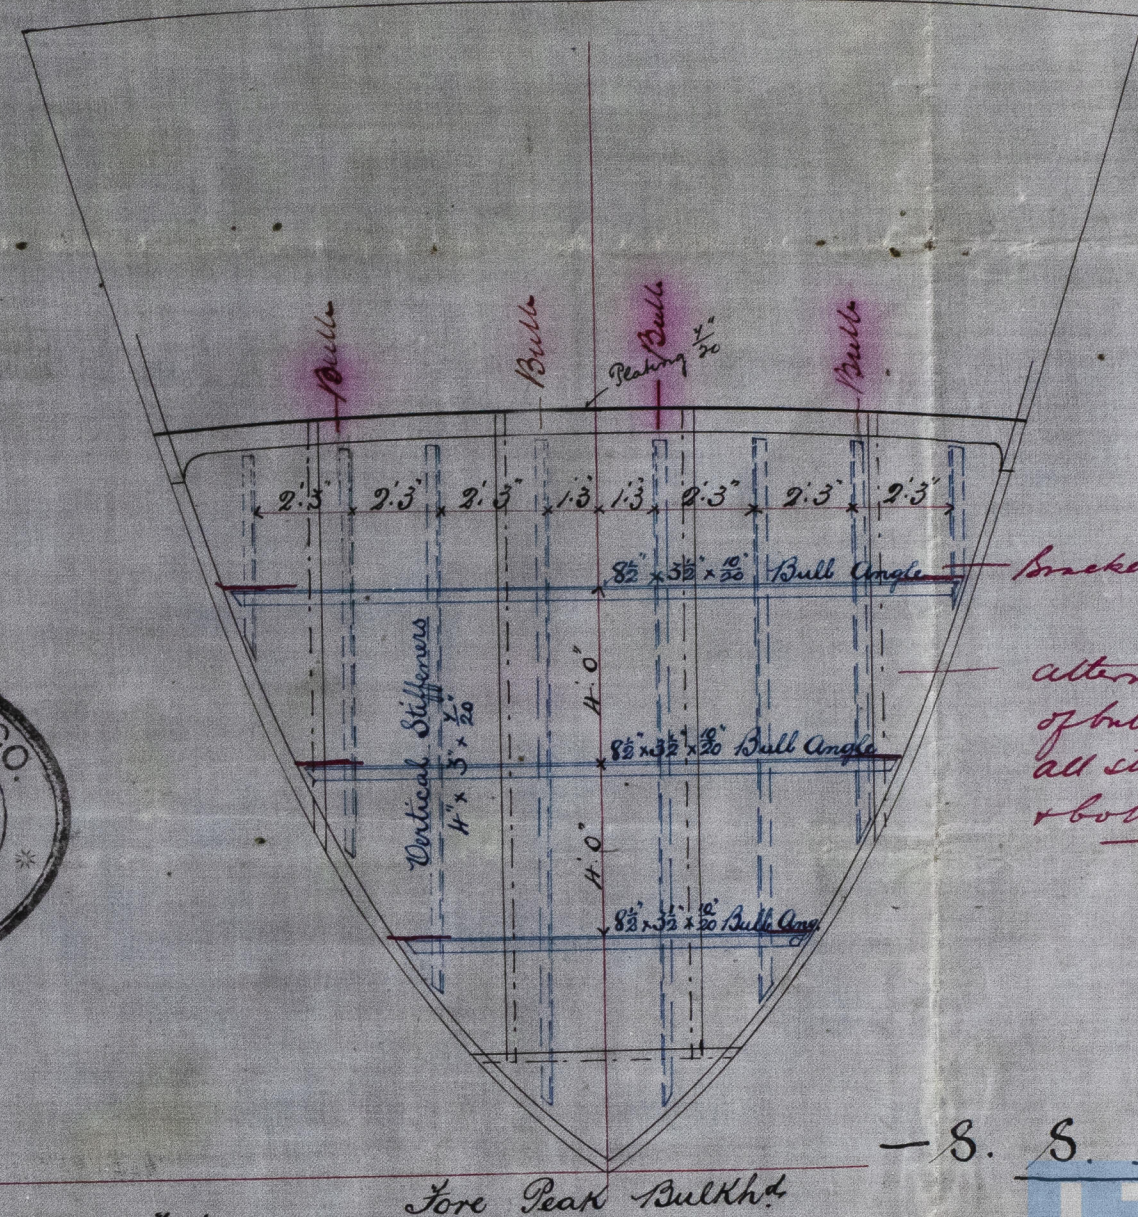

— S. S. No. 70 —




© 2019
GIRK 314-0072yd's Register
Foundation
Date 10/9/89


S. S. 'Rashen'
 Greenock Report
 No. 9917


GRK314-0.072

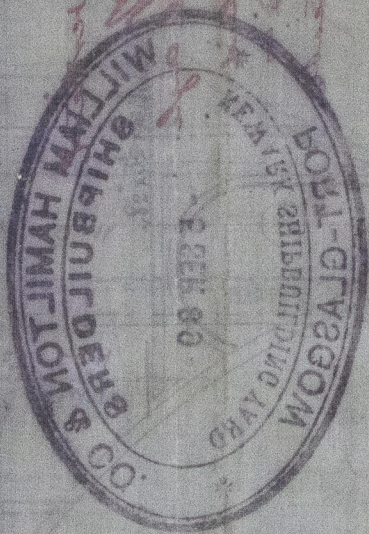

Scale 1/4 inch = One foot

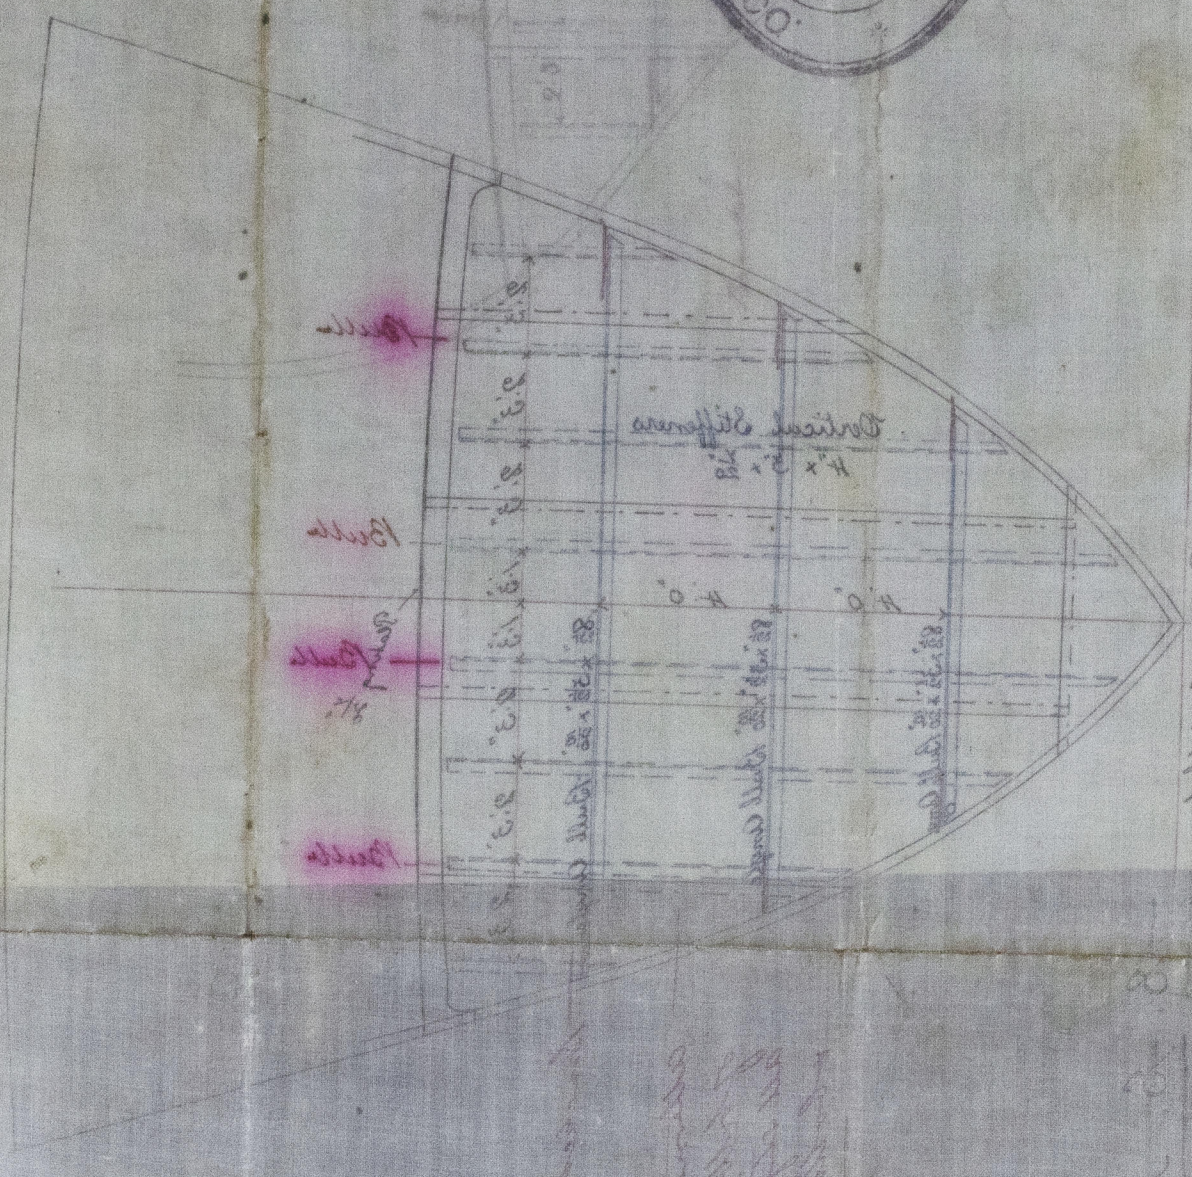

One inch = One foot





© 2019
 Lloyd's Register
 Foundation