


dt: 20/12/89.
1.1.90


S. S. "Vanton"
Greenock Report No. 9914

— Plan of Pumping Arrangement —
— S. S. No 70. —

 

MA
17-12-89

— Scale 1/4 Inch = One Foot —

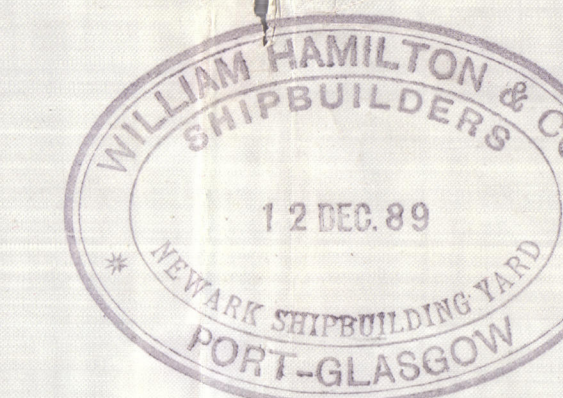

S. S. Vashen
Greenock Report
No. 9914

GRK314-0073

Old Suction Pipe

Don't hold out. expirations to have pitted at most

TUNNEL



© 2020

Lloyd's Register
Foundation