

Midship Section S.S. No 231.

Length P.P. 293' 10" Breadth M. 40' 0" Depth M. 20' 9"


Class 100A1 at Lloyd's Steel

Scale 1/2" = one foot.

Numerals.	
Half Beam	20' 00
Depth to Keel	21' 58
Half Girth	38' 30
	79' 88 1/2 M
	242' 16
	23337' 74 2nd M
	2977' 72
Erections	25915' 46 Equipment M
	26255
	25916



THU 29 AUG 89  
FRI 13 SEP 89  
FRI 27 SEP 89  
WED 12 OCT 89  
MON 21 OCT 89

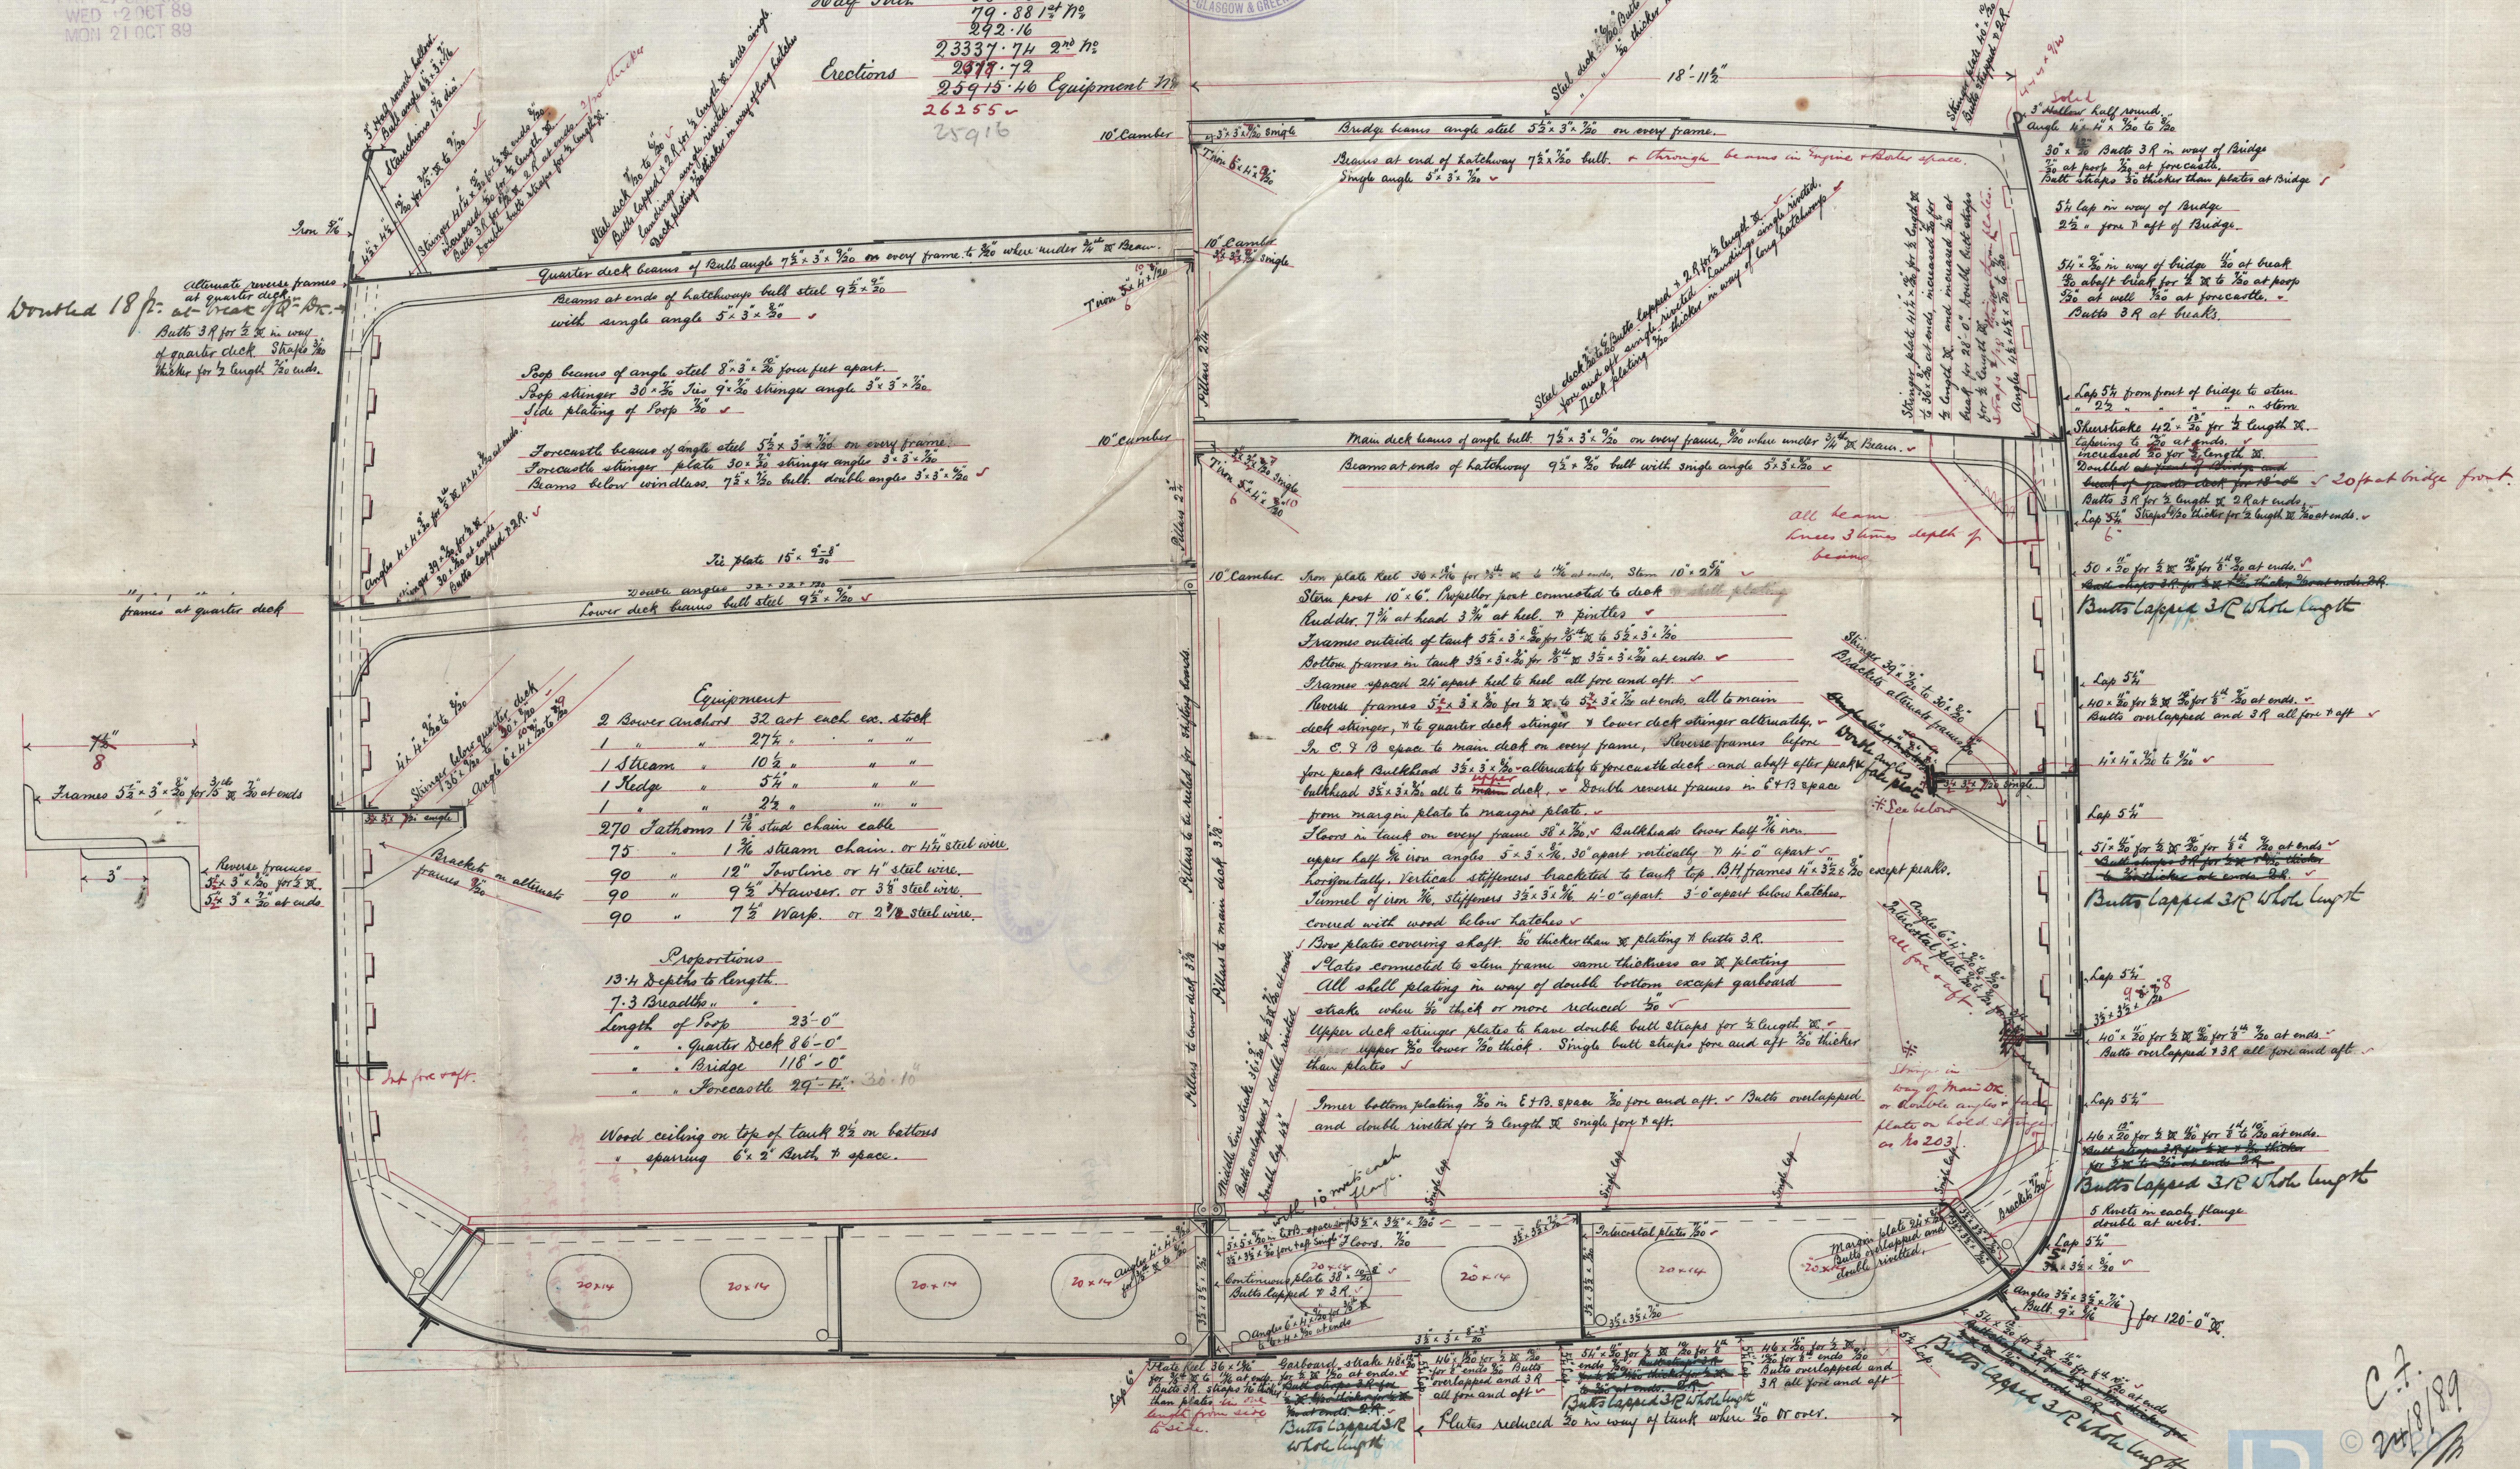



.....

GRK315-0002

© 2020

Lloyd's Register  
Foundation