

"Strathallan"  
Greenock report  
No. 10008.


Proposed finish of side frames

S.S. No. 231.

Scale  $\frac{1}{2}$  inch = one foot.



MON 2 OCT 89

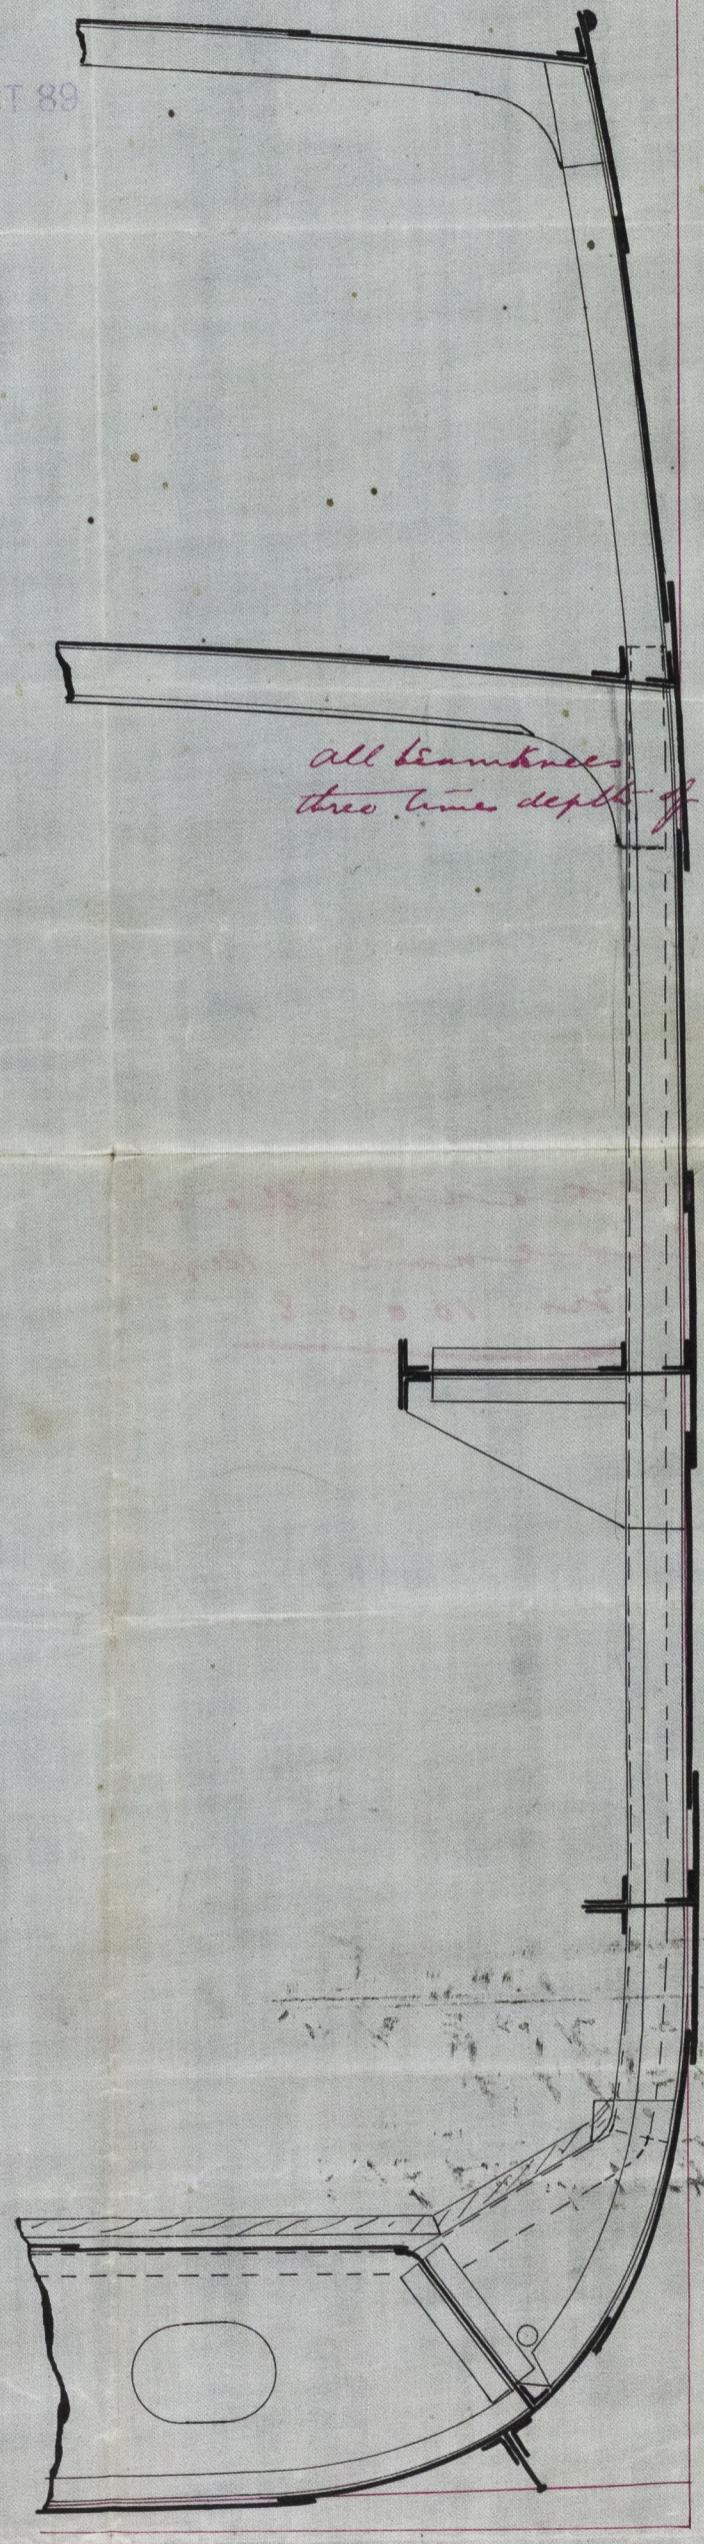

all beam knees  
three times depth of beam.



Russell & Co.  
C.J. 18/10/89.  
© 2021 Lloyd's Register Foundation  
GRH3K5+0003



"Strathallan"  
Greenock Rept.  
No. 10008

GRK315-0003

Proposed  
by  
P.D.H. 1891



© 2021  
Lloyd's Register  
Foundation