


THU 29 AUG 89
FRI 13 SEP 89

New Steamer "Skotchdoon"
Greenock Report No. 10.008

Longitudinal & Deck Plans of No. 231.
To class 100 A1 at Lloyd's Steel
Scale 1/2 inch = one foot.



Plans - James Smith & Co.
17th March

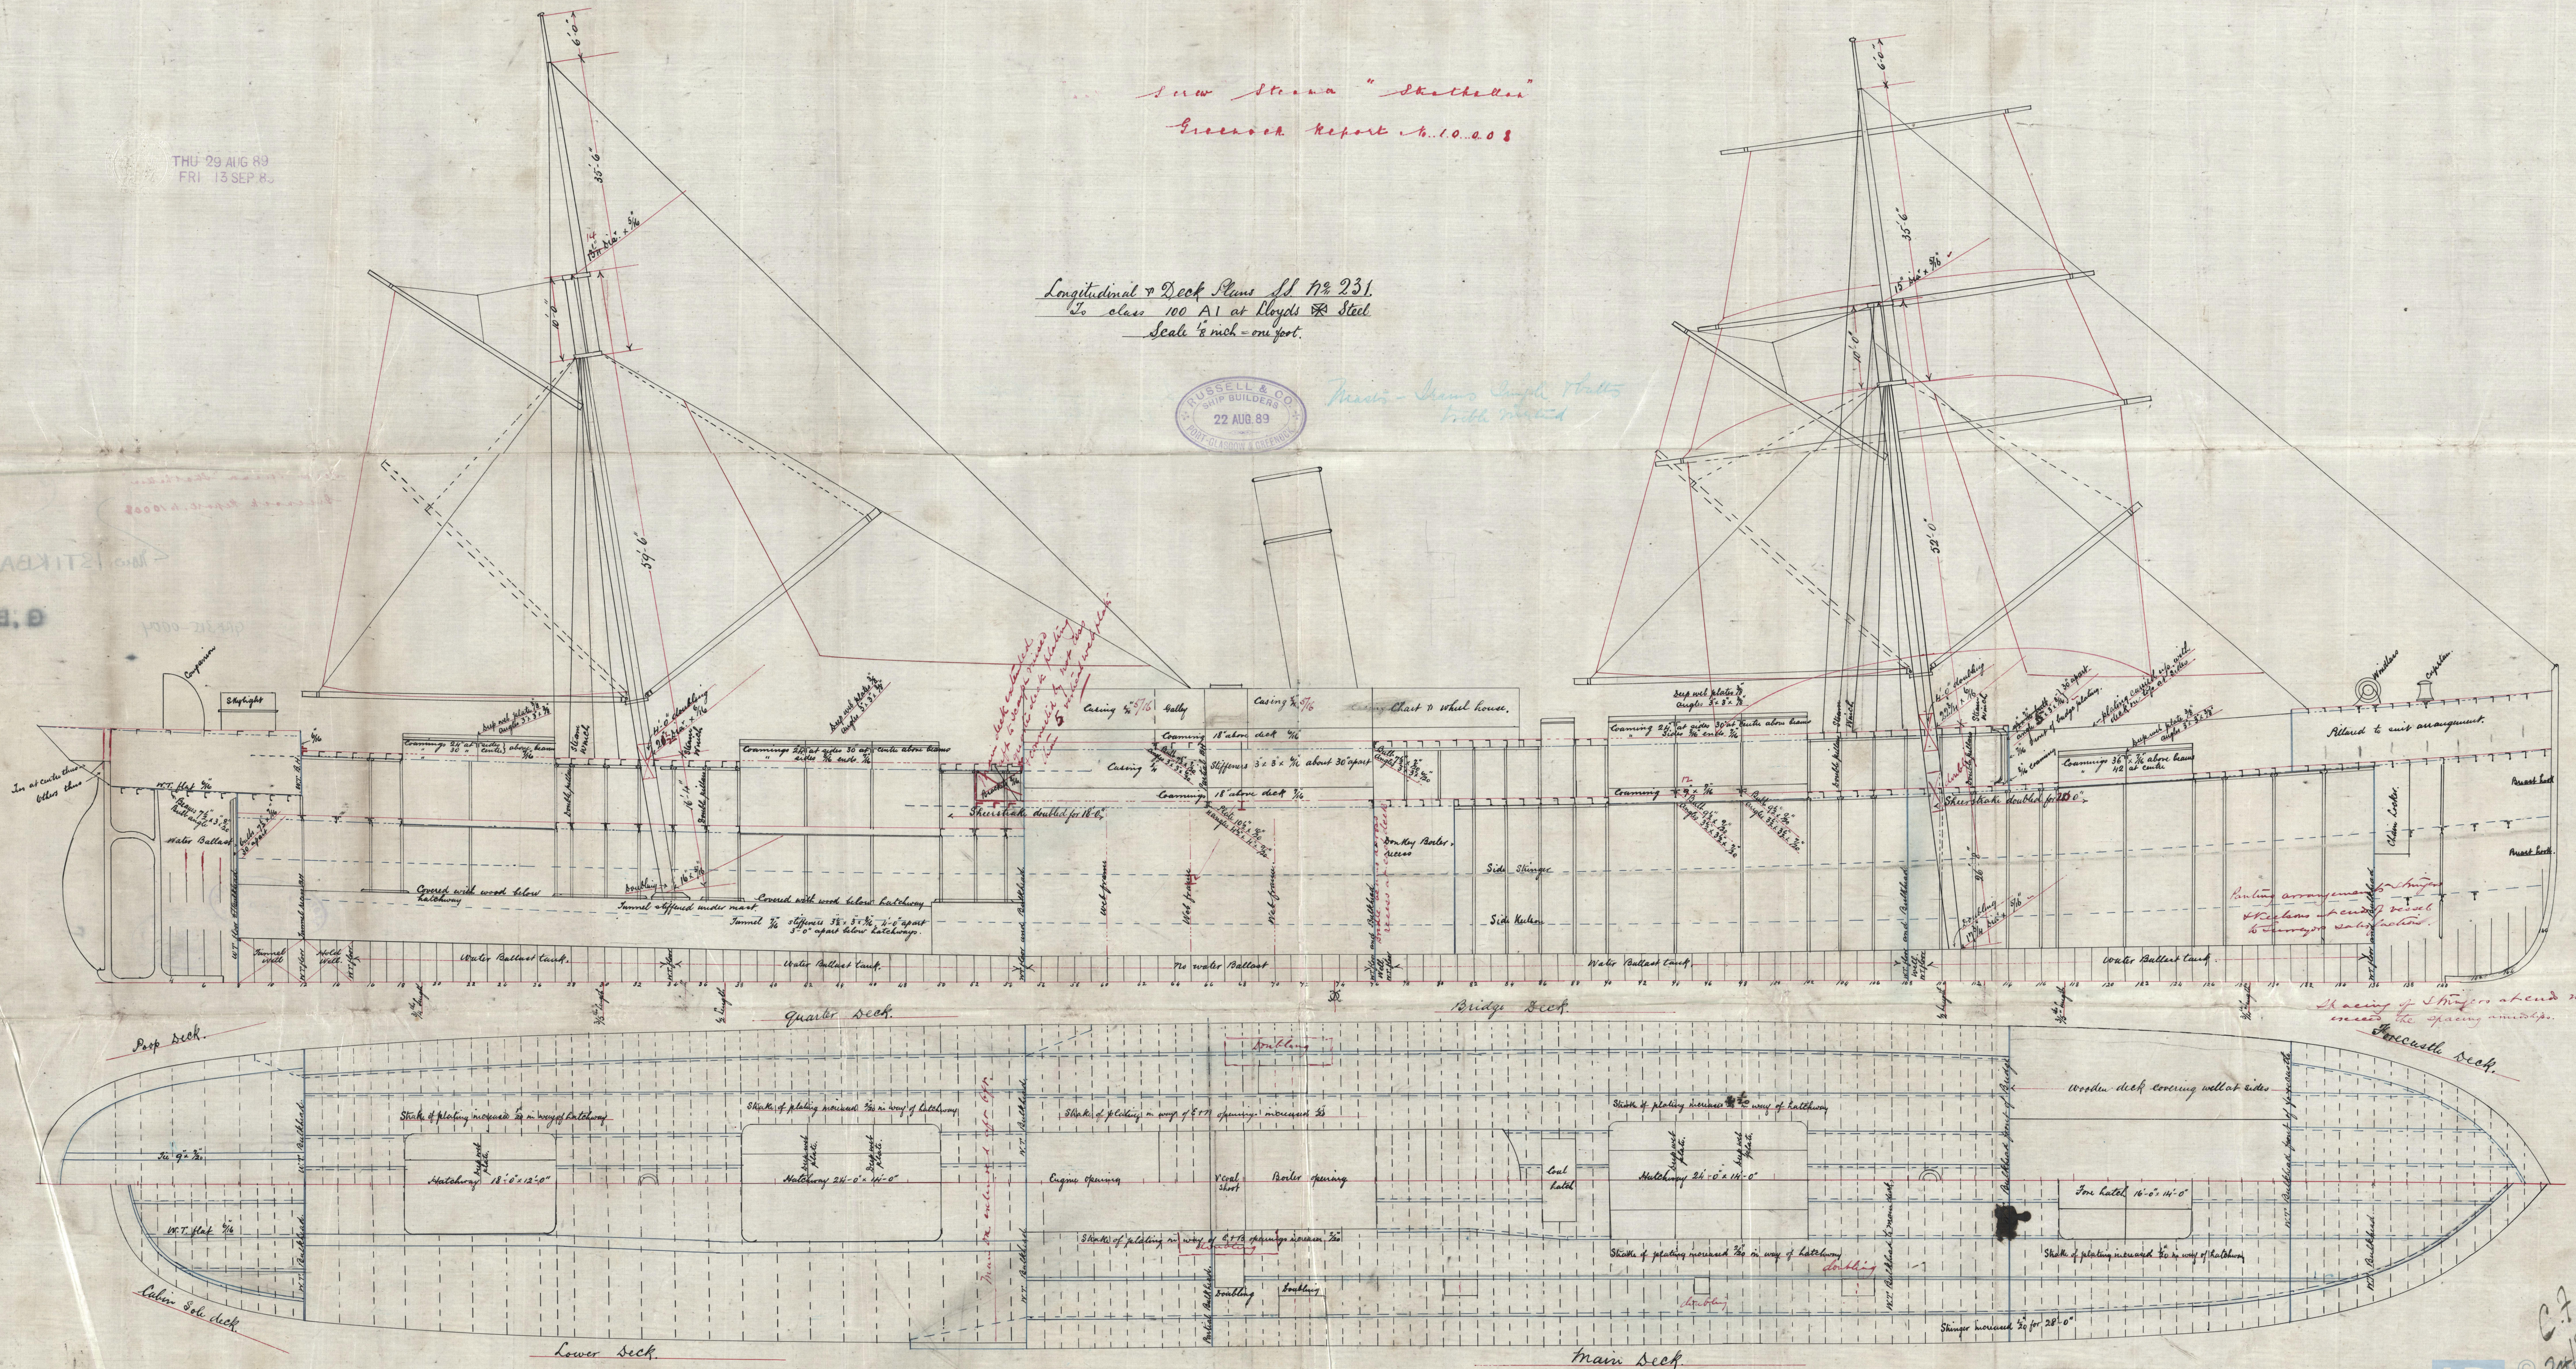

Greenock Report. to 10008

G. B.

GRK315-0004



© 2020

Lloyd's Register
Foundation