

"Latham Hallen"
Greenwich Report
No. 10008.

92K315-0008

LIBRARY
SEP 18 1880

RECEIVED
OCT 18 1880


RECEIVED
OCT 18 1880

LIBRARY
SEP 18 1880

"Stratthallen"
Greenock Report
No. 10008.



Plan of tank top in E & B. Space S.S. No. 231.
Showing open spaces with plating $\frac{1}{32}$ " in way of same
Scale $\frac{1}{4}$ " = one foot.

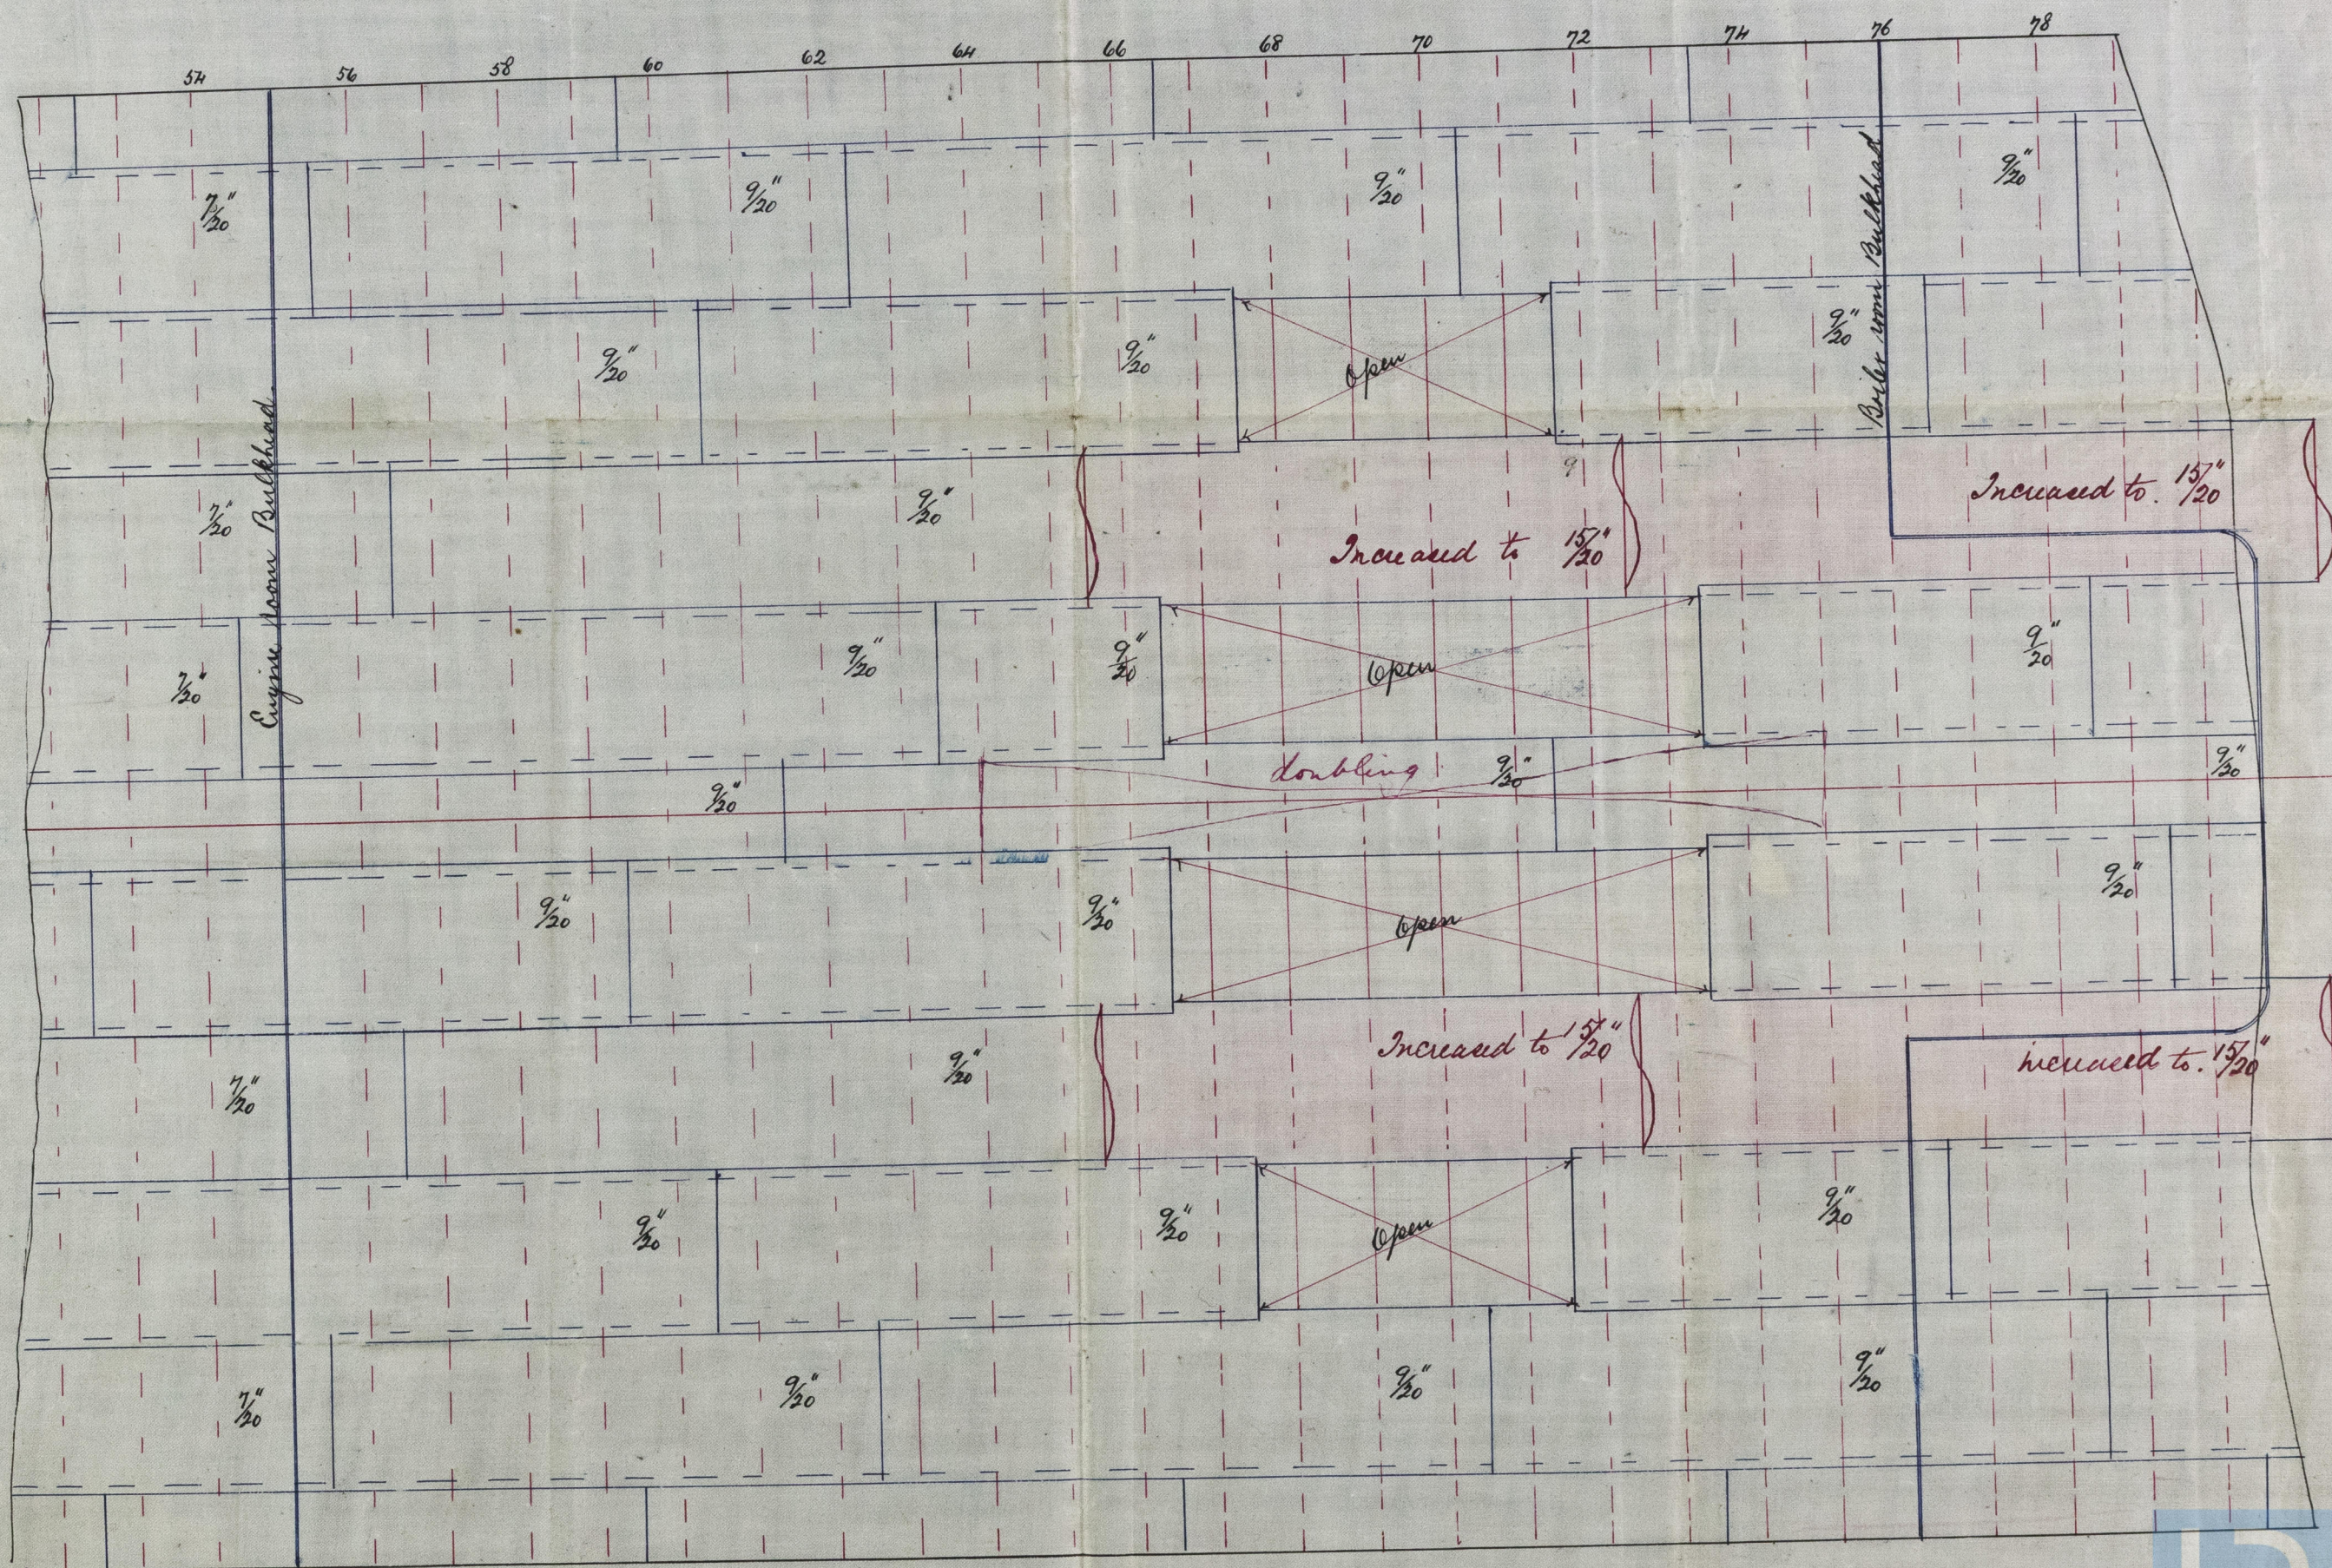

C.F. 2018/8/89.

Lloyd's Register
GRK 315-0008