



"Lathallen"
Greenock Report
No. 10008.

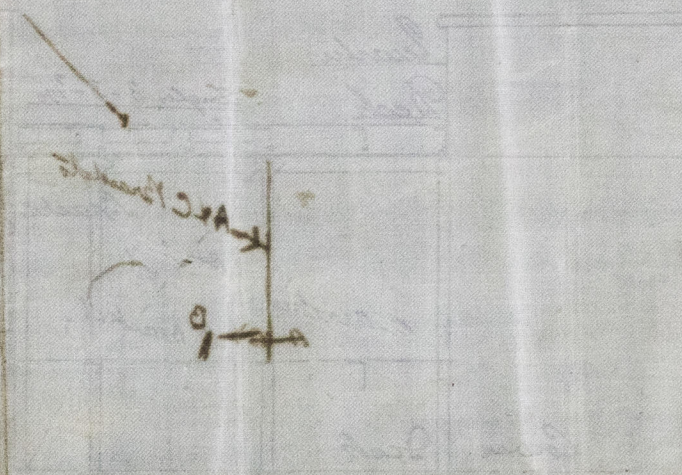

GRK315-0013

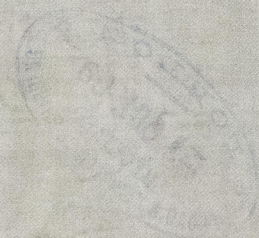




WED 2 OCT 89

s.s. "Strathallan"
Greenock Report No. 10008

S.S. No 231

Proposed Strengthening at Break of In. Deck
1/4 Scale

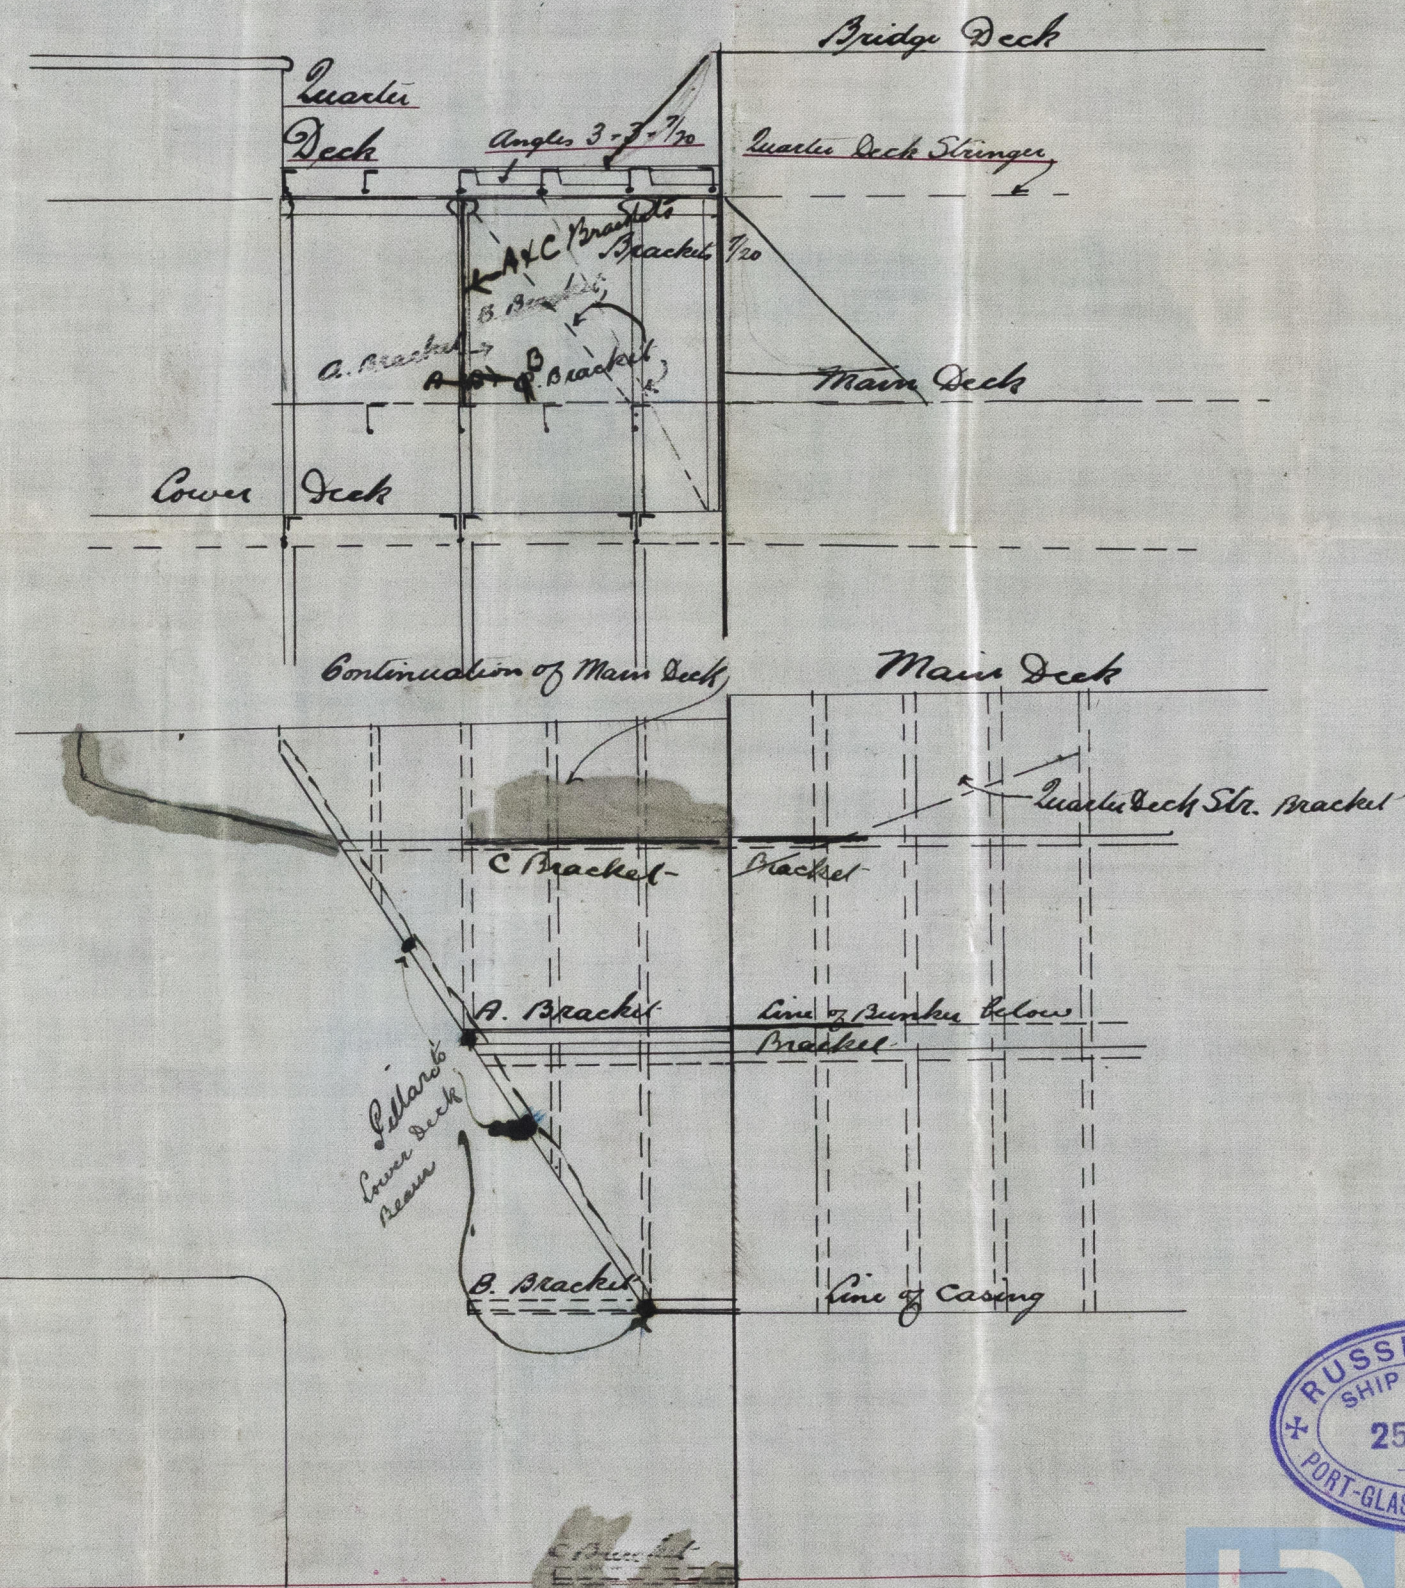

C.F.
25/9/89



© 2019

Lloyd's Register
Foundation

GRR 315-0013