



Boiler

Scale one inch = one foot

Working Pressure 70 lbs

E-N°200

DAVID J. DUNLOP & CO
ENGINEERS & SHIPBUILDERS
PORT GLASGOW

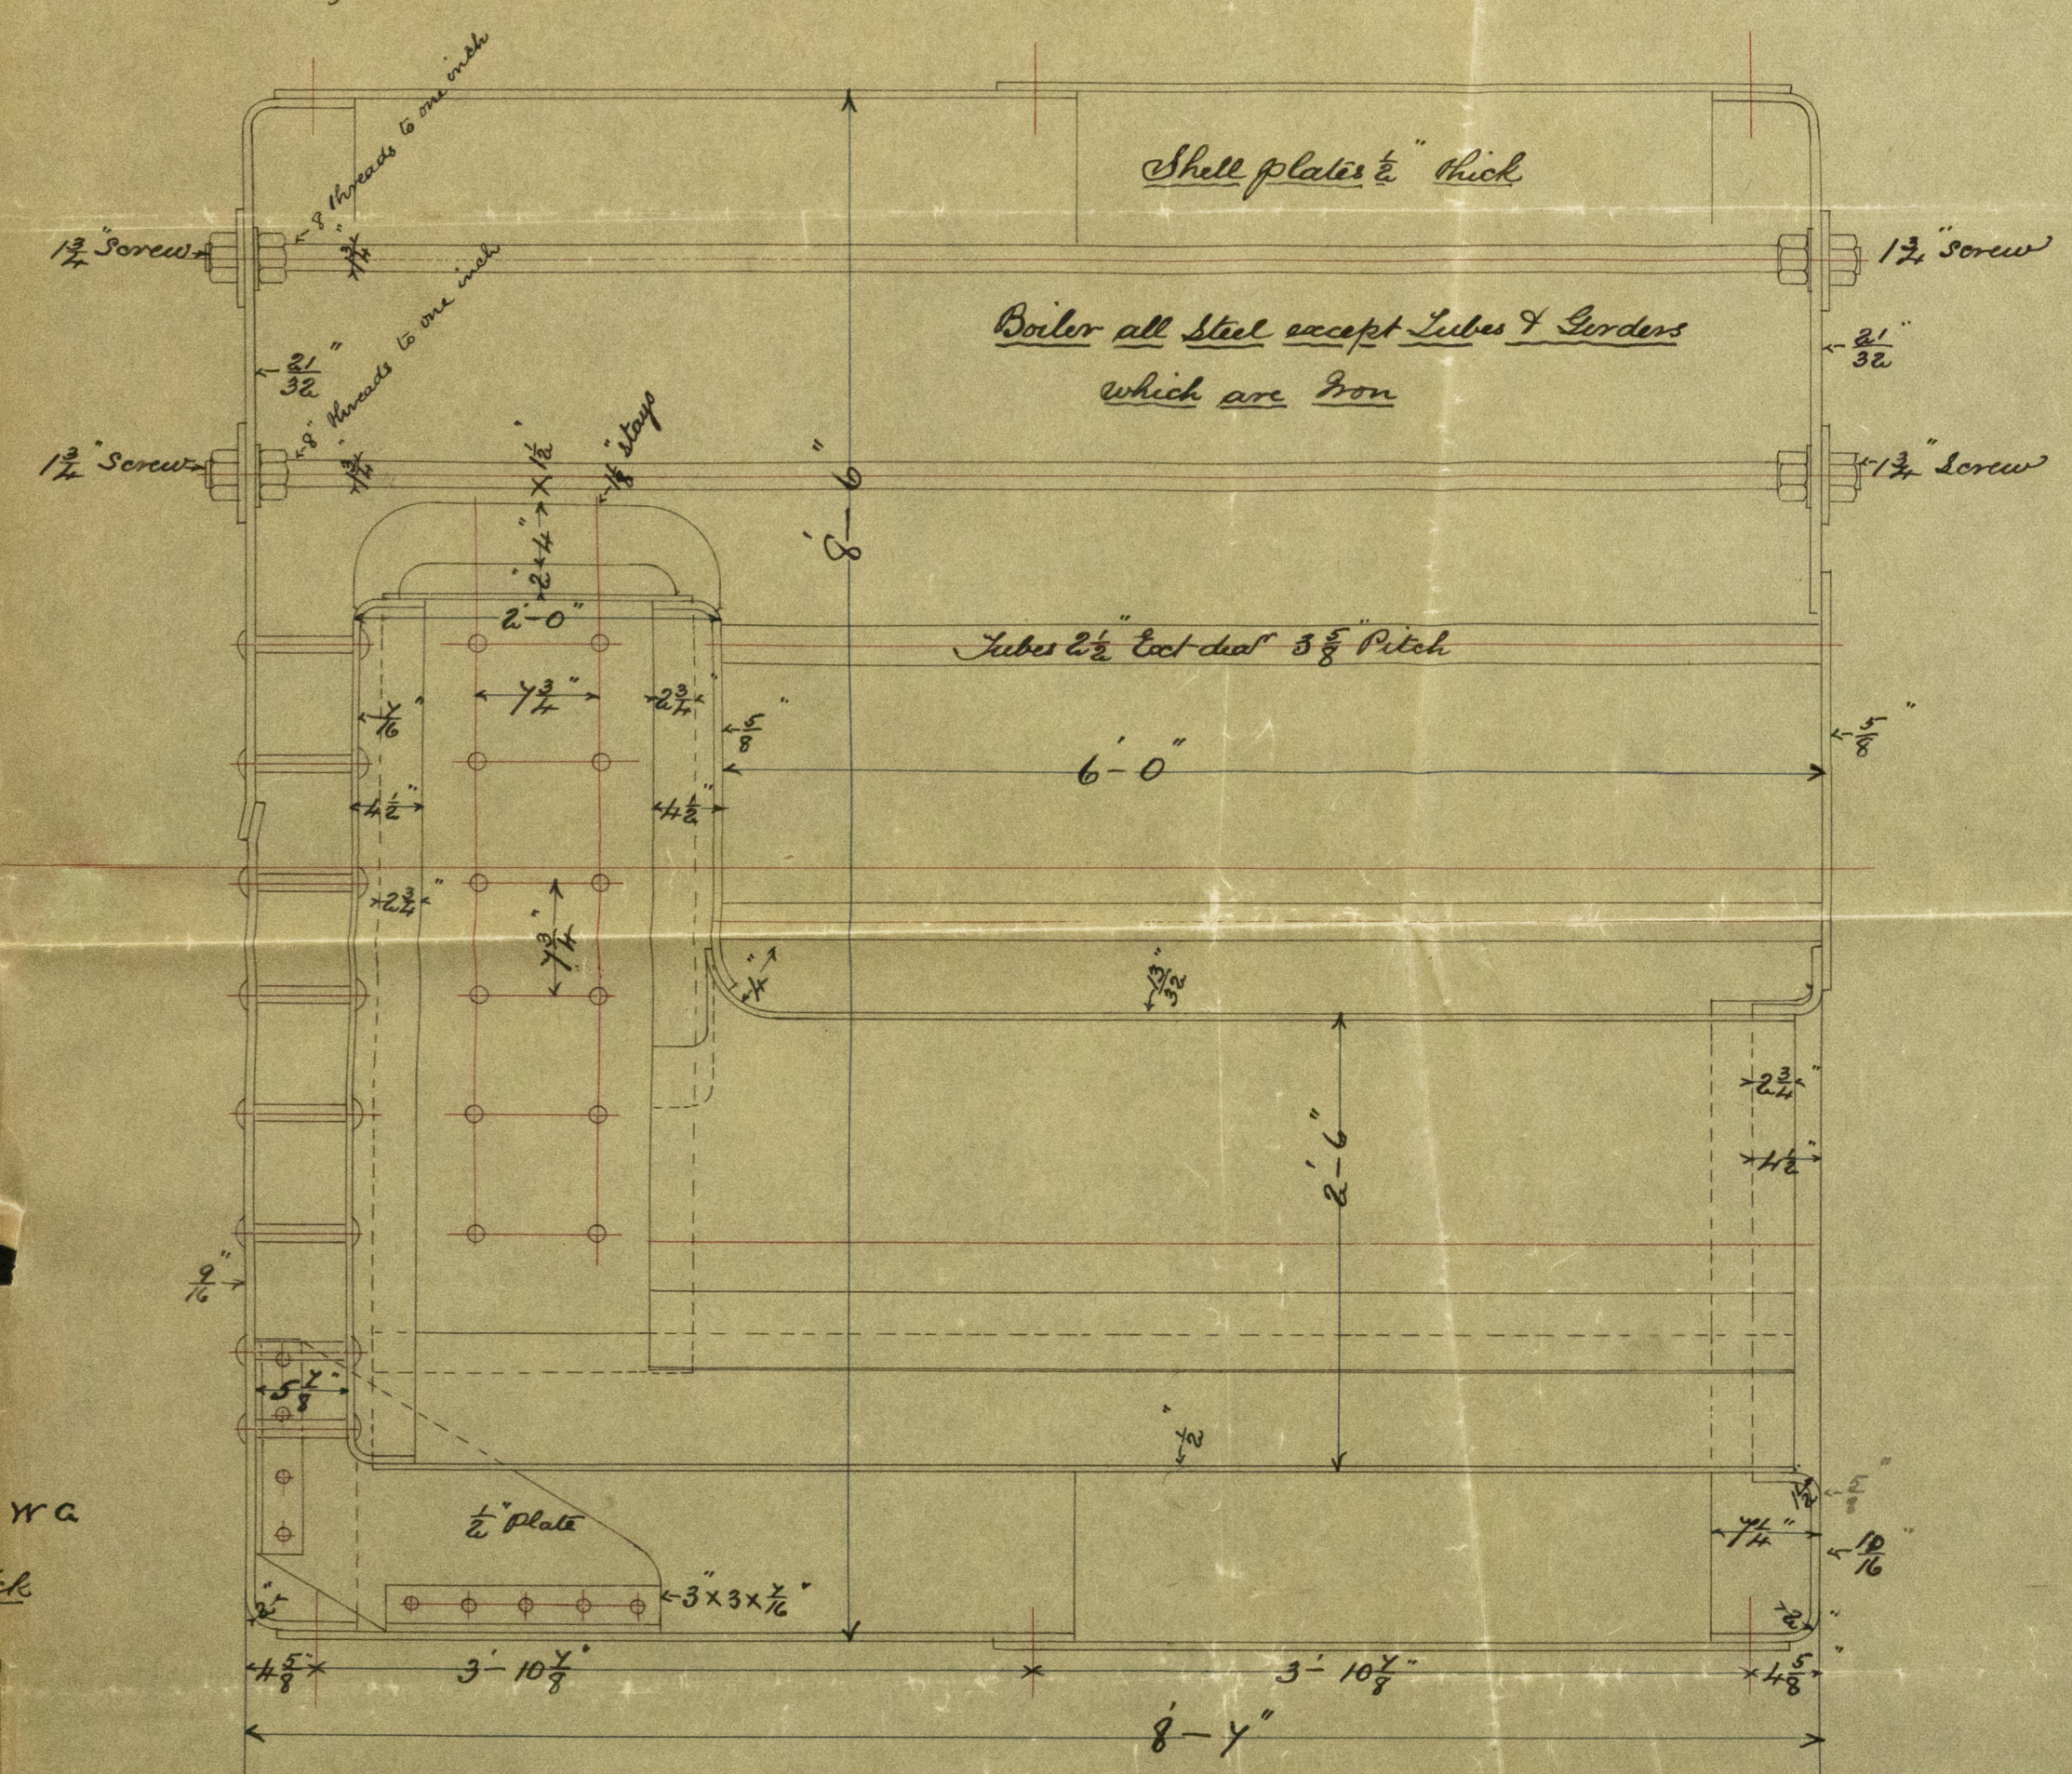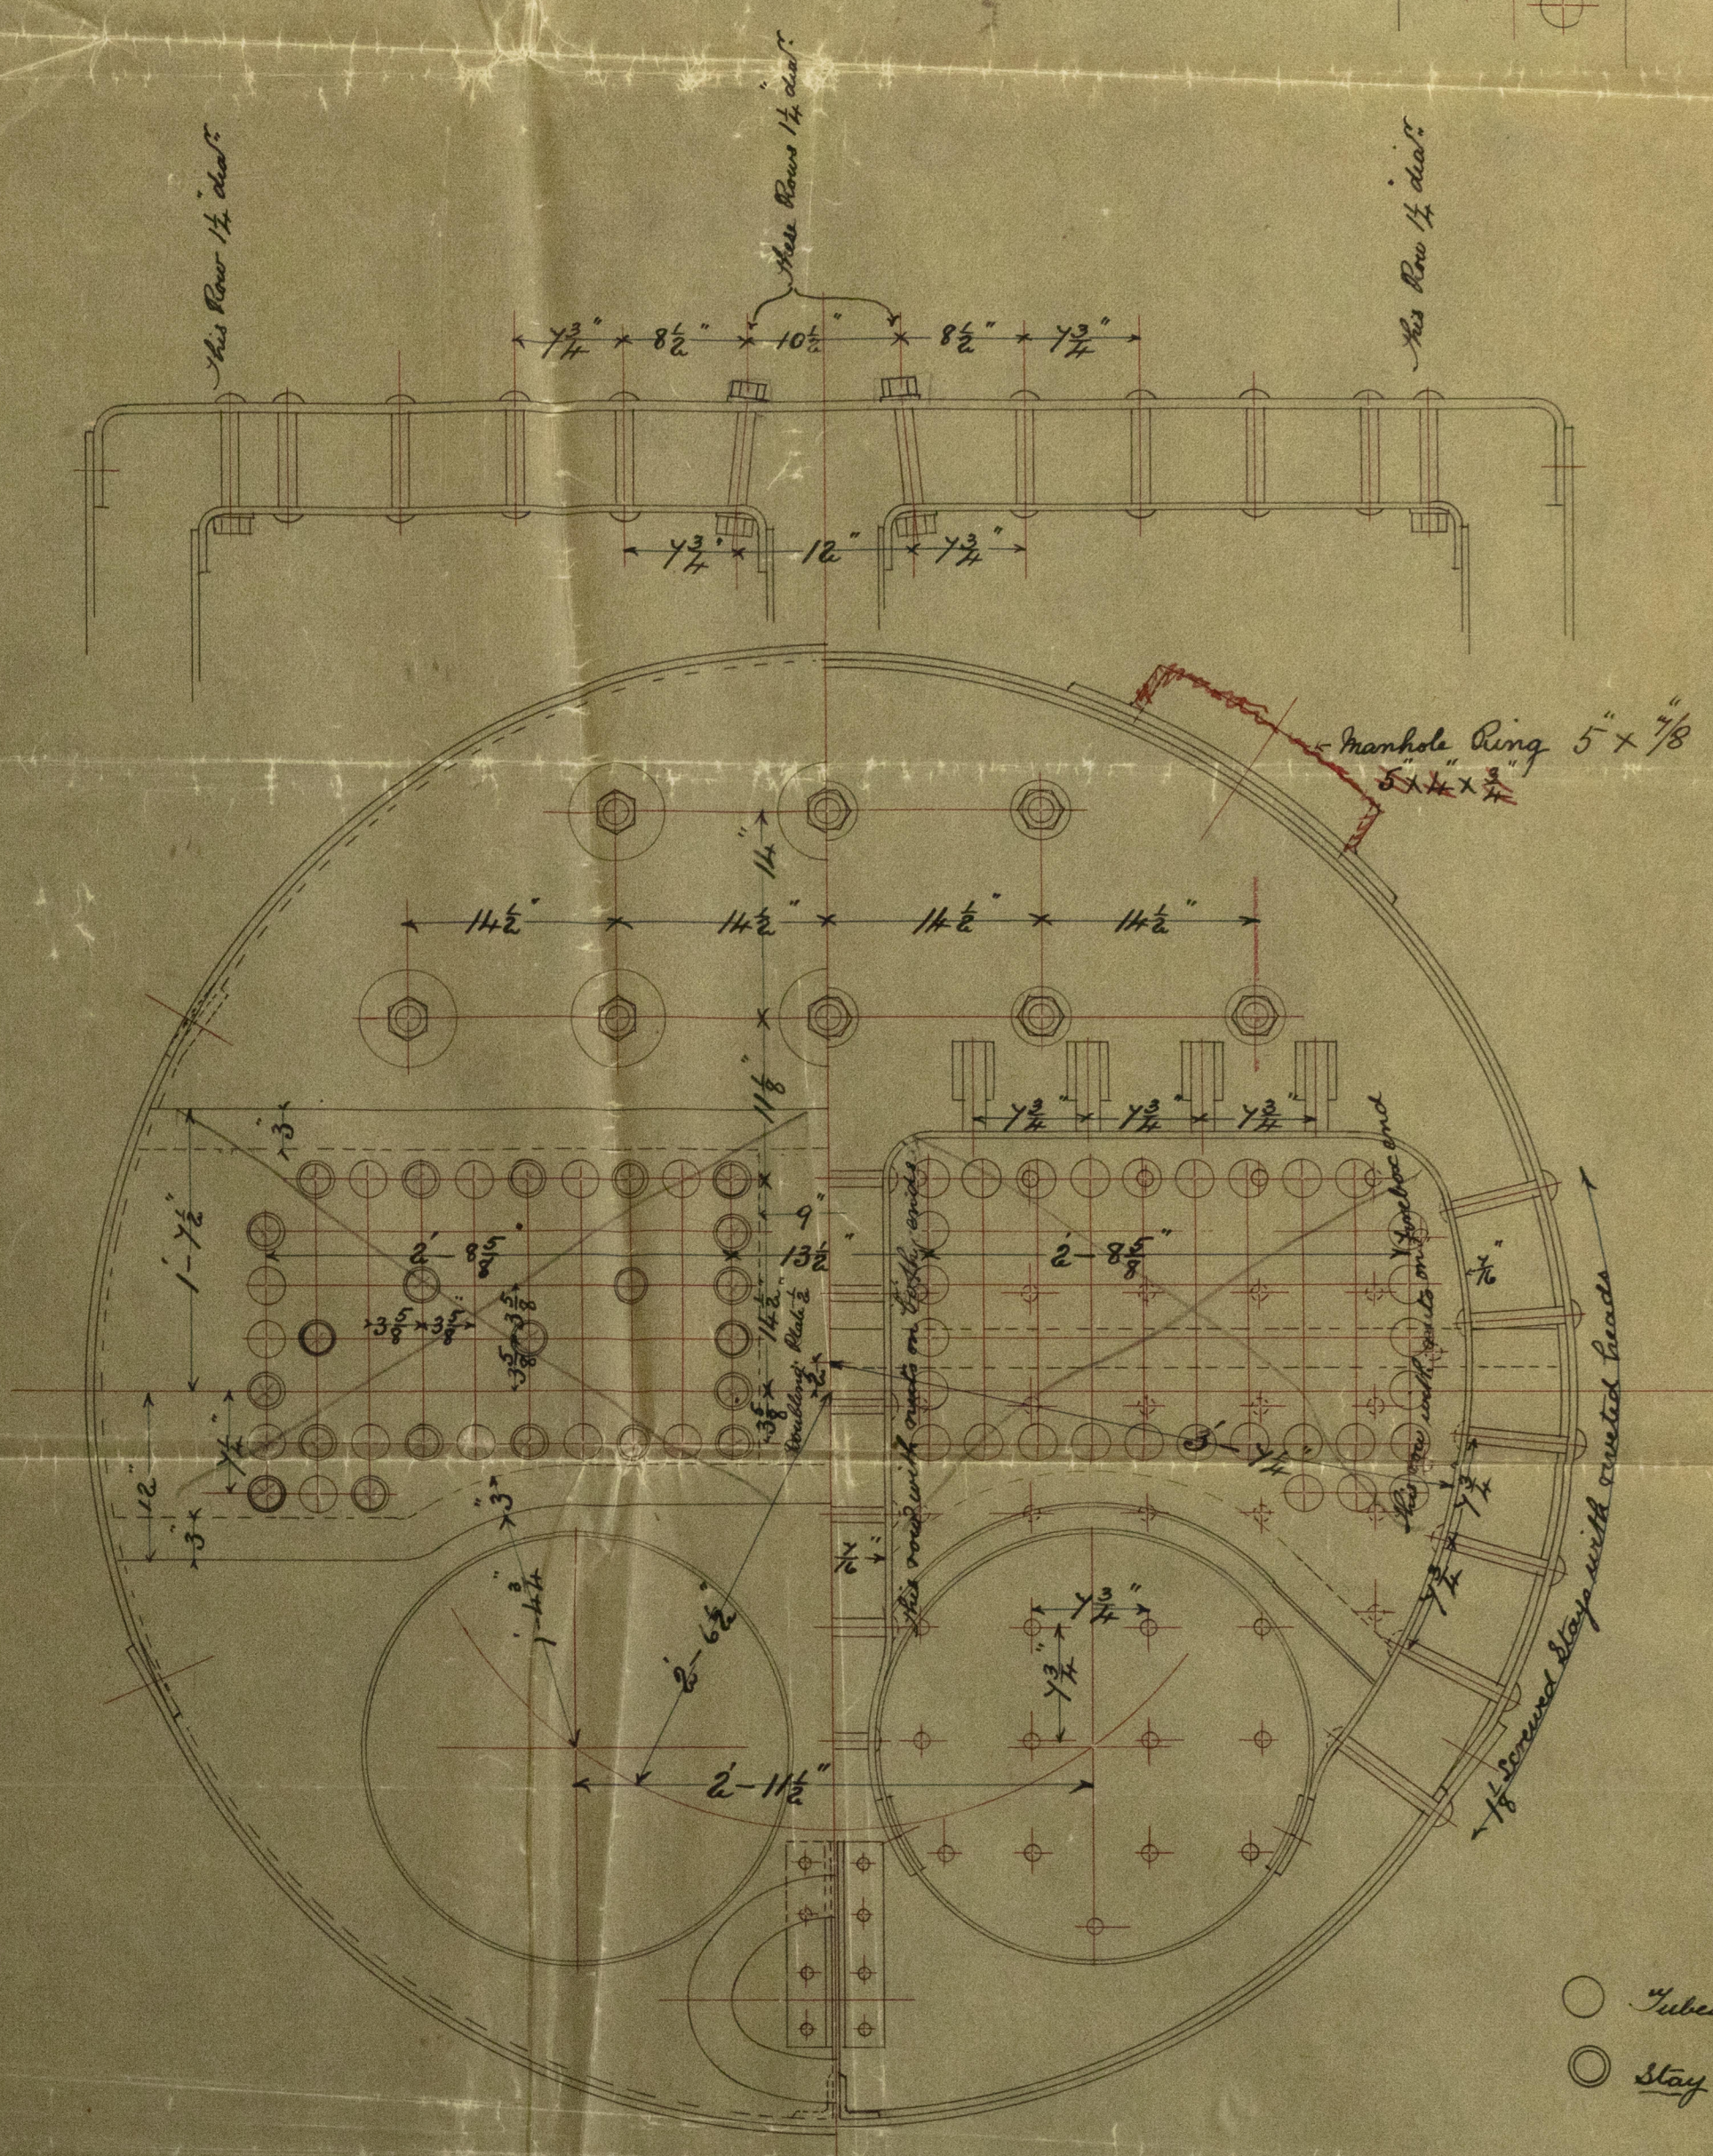

- Tubes thick N° 10 S.W.A.
- Stay tubes $\frac{7}{16}$ " thick

Wd.
84.90



luxan 28/4/90
A.C.H.

20/10/19



"William Turner"
Greenock Report
No. 10029.

GRK315-0060

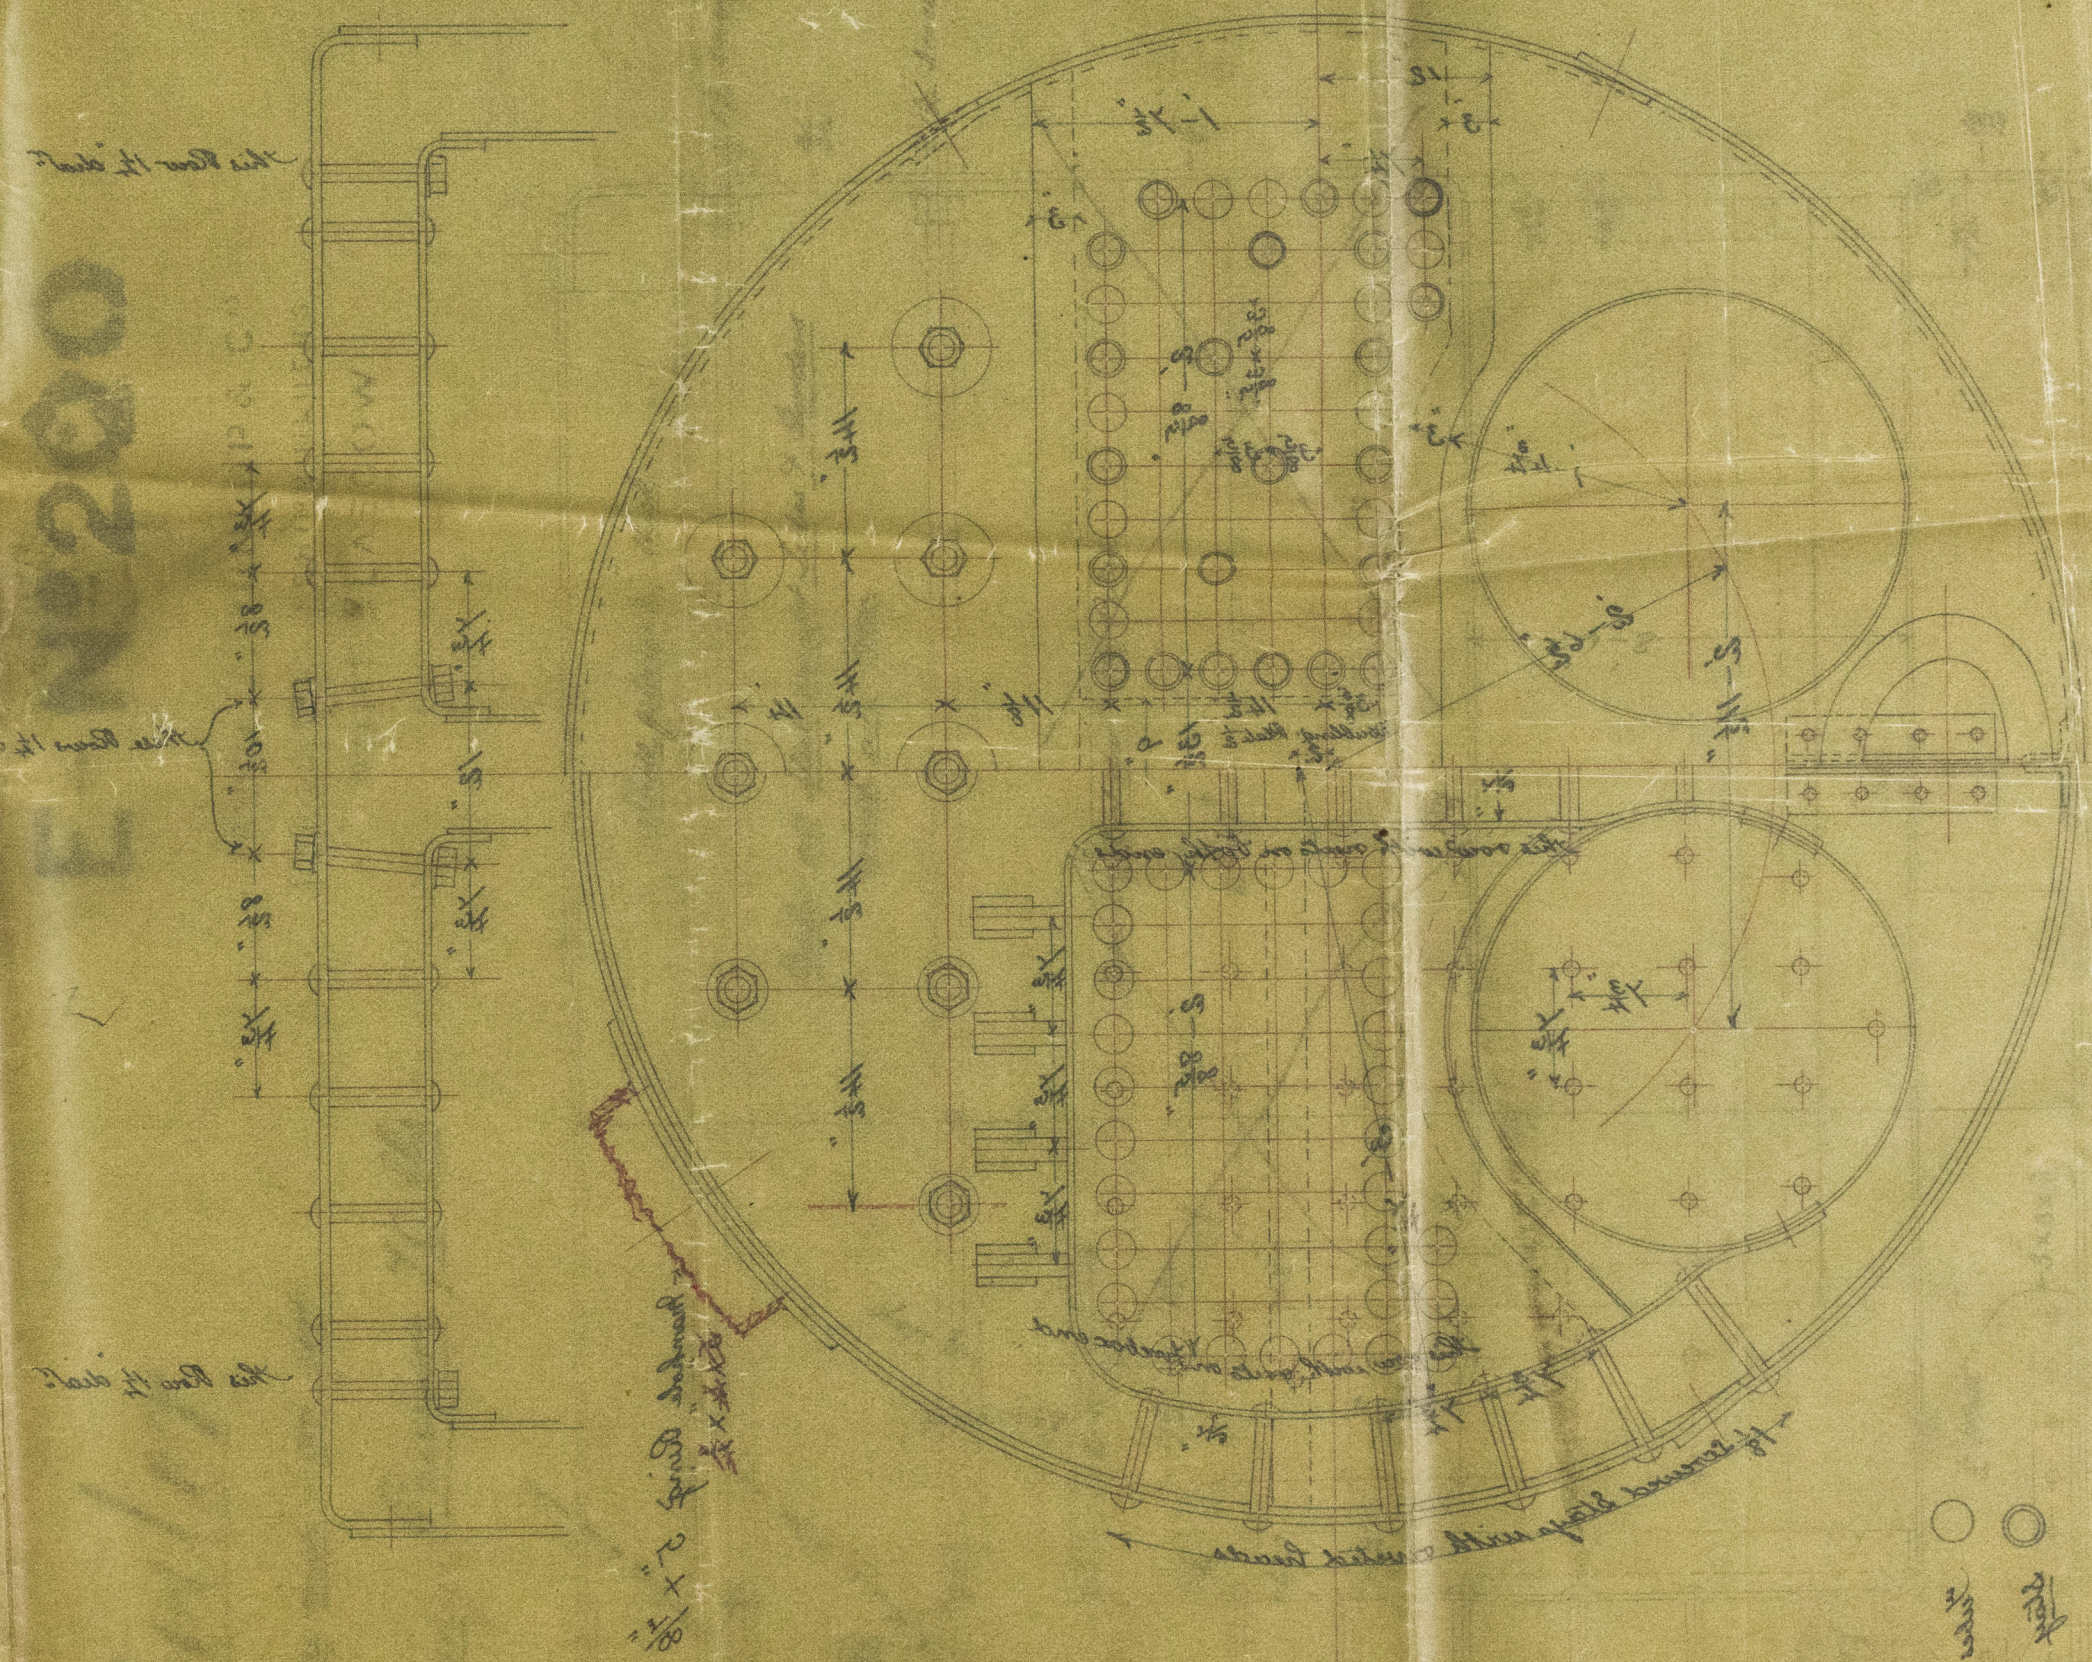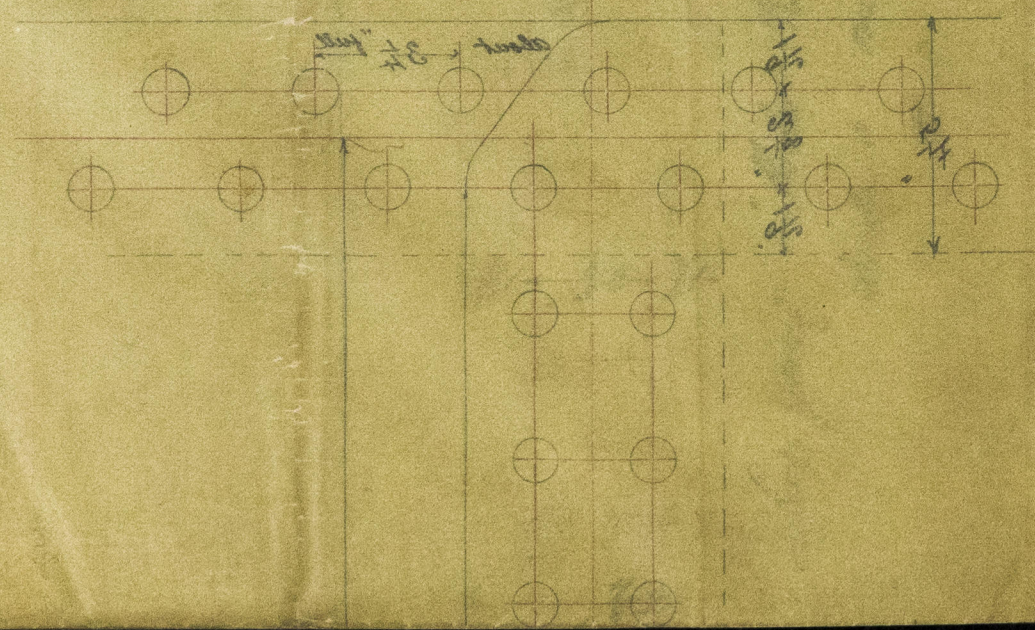

20/10/19

