


"William Flower"
Greenock Report
No. 10029.

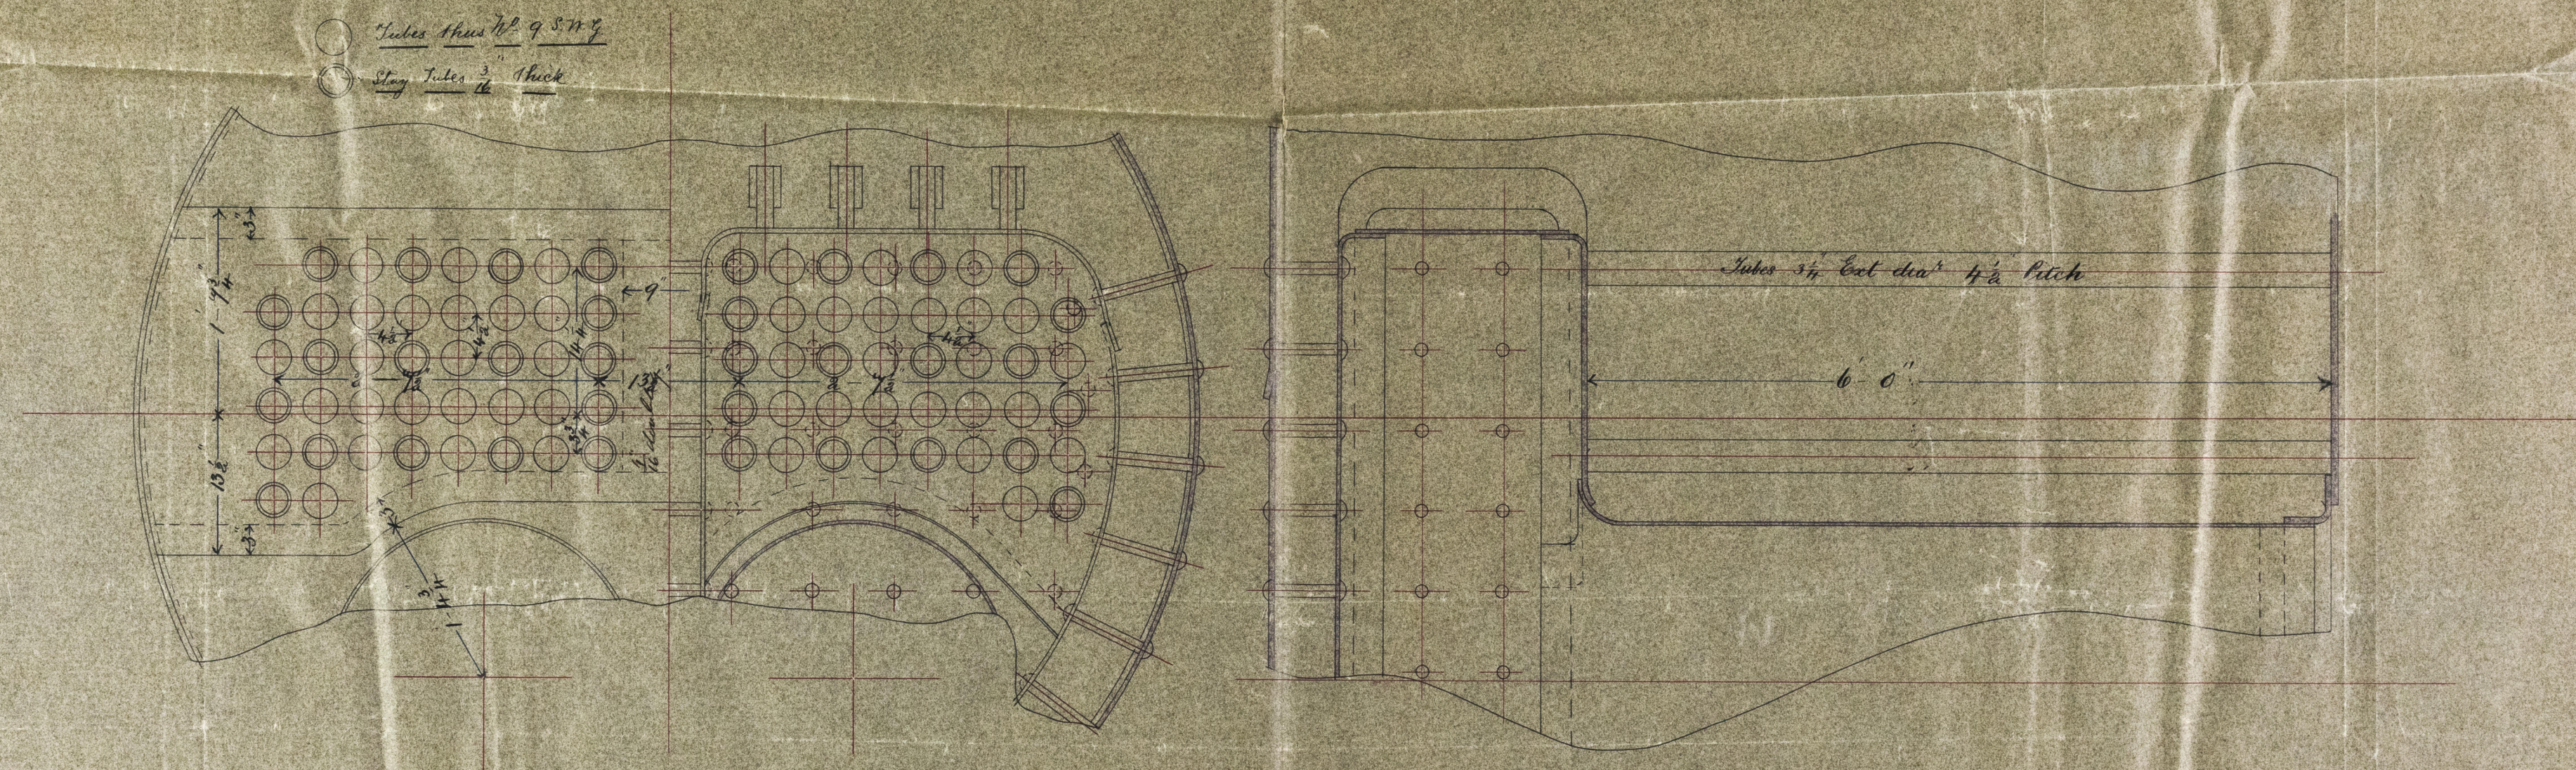

Amended plan of tubes
as fitted in boiler
A.C.H.

Arrangement of Tubes in Boiler
for
E.W. 200
Scale 1" = one foot

DAVID J. DUNLOP & CO
ENGINEERS & SHIPBUILDERS
PORT GLASGOW