

Russell & Co.

No 232 - Snagrow Barque Amato.  
Gut. Rpt. No 11051.

London. Fri 13 Sep 1889.  
Wed 25 Sep - 89.

N<sup>o</sup> 232 9.38 7.15 7.16.  
MIDSHIP SECTION  
SCALE 1/4 INCH ONE FOOT.

Reg'd Draw. 285 x 42.92 x 24.25 Hold.

Forecastle 30.0  
Striker 36 x 1/2 to 27 x 1/2  
Side plating 70  
Lie plate 11 1/2 x 70  
Aisle 3 1/2 x 3 1/2 x 70

Port 36.0  
Side plating 70  
Lie plate 11 1/2 x 70  
Aisle 3 1/2 x 3 1/2 x 70


Equipment

1	Power Anchor	exclud	Stock	40 cent
1	do	do	do	38
1	do	do	do	36
1	Stream	do	do	12
1	Keage	do	do	6
1	do	do	do	3
270	tailorm	2 1/2	Spud Chain	
100	do	1 1/2	Stream	
90	do	12 x 11 1/2	Hawsters	

Proportions  
6.74 depth } 2 in length  
9.90 depth }

Reel Stem 91 Stern 10 x 7 1/2 frames head 7 1/2 feet apart 5 1/2  
Frames 5 1/2 x 3 1/2 x 70 for 3 1/2 at ends spaced 24" from cen. to cen.  
Reverse frames 4 x 3 1/2 x 70 to 11" at every frame & alternately to fore & aft  
Port 30 x 70 for 3 1/2 at ends capped 9 x 3 R  
Bulkhead over hull to upper 5/8 x 3 1/2 x 70 spaced 30"  
Main or beam 10 x 70 bulk to 9 x 70 angles 3 1/2 x 3 1/2 x 70  
Lower 11 1/2 x 70 - for 3 1/2 x 6 1/2 x 70 angles 3 1/2 x 3 1/2 x 70  
Forecastle 8 x 70 - angles 3 x 3 x 70 4-0 apart  
100 7 1/2 x 3 1/2 x 70 depth 4-0 apart if over 30 ft beam

Plating  
Rivets in Keel Stern & Stern post 1 1/2 spaced 58" from cen. to cen.  
frames & reverse frames 3/4 spaced 5 1/4

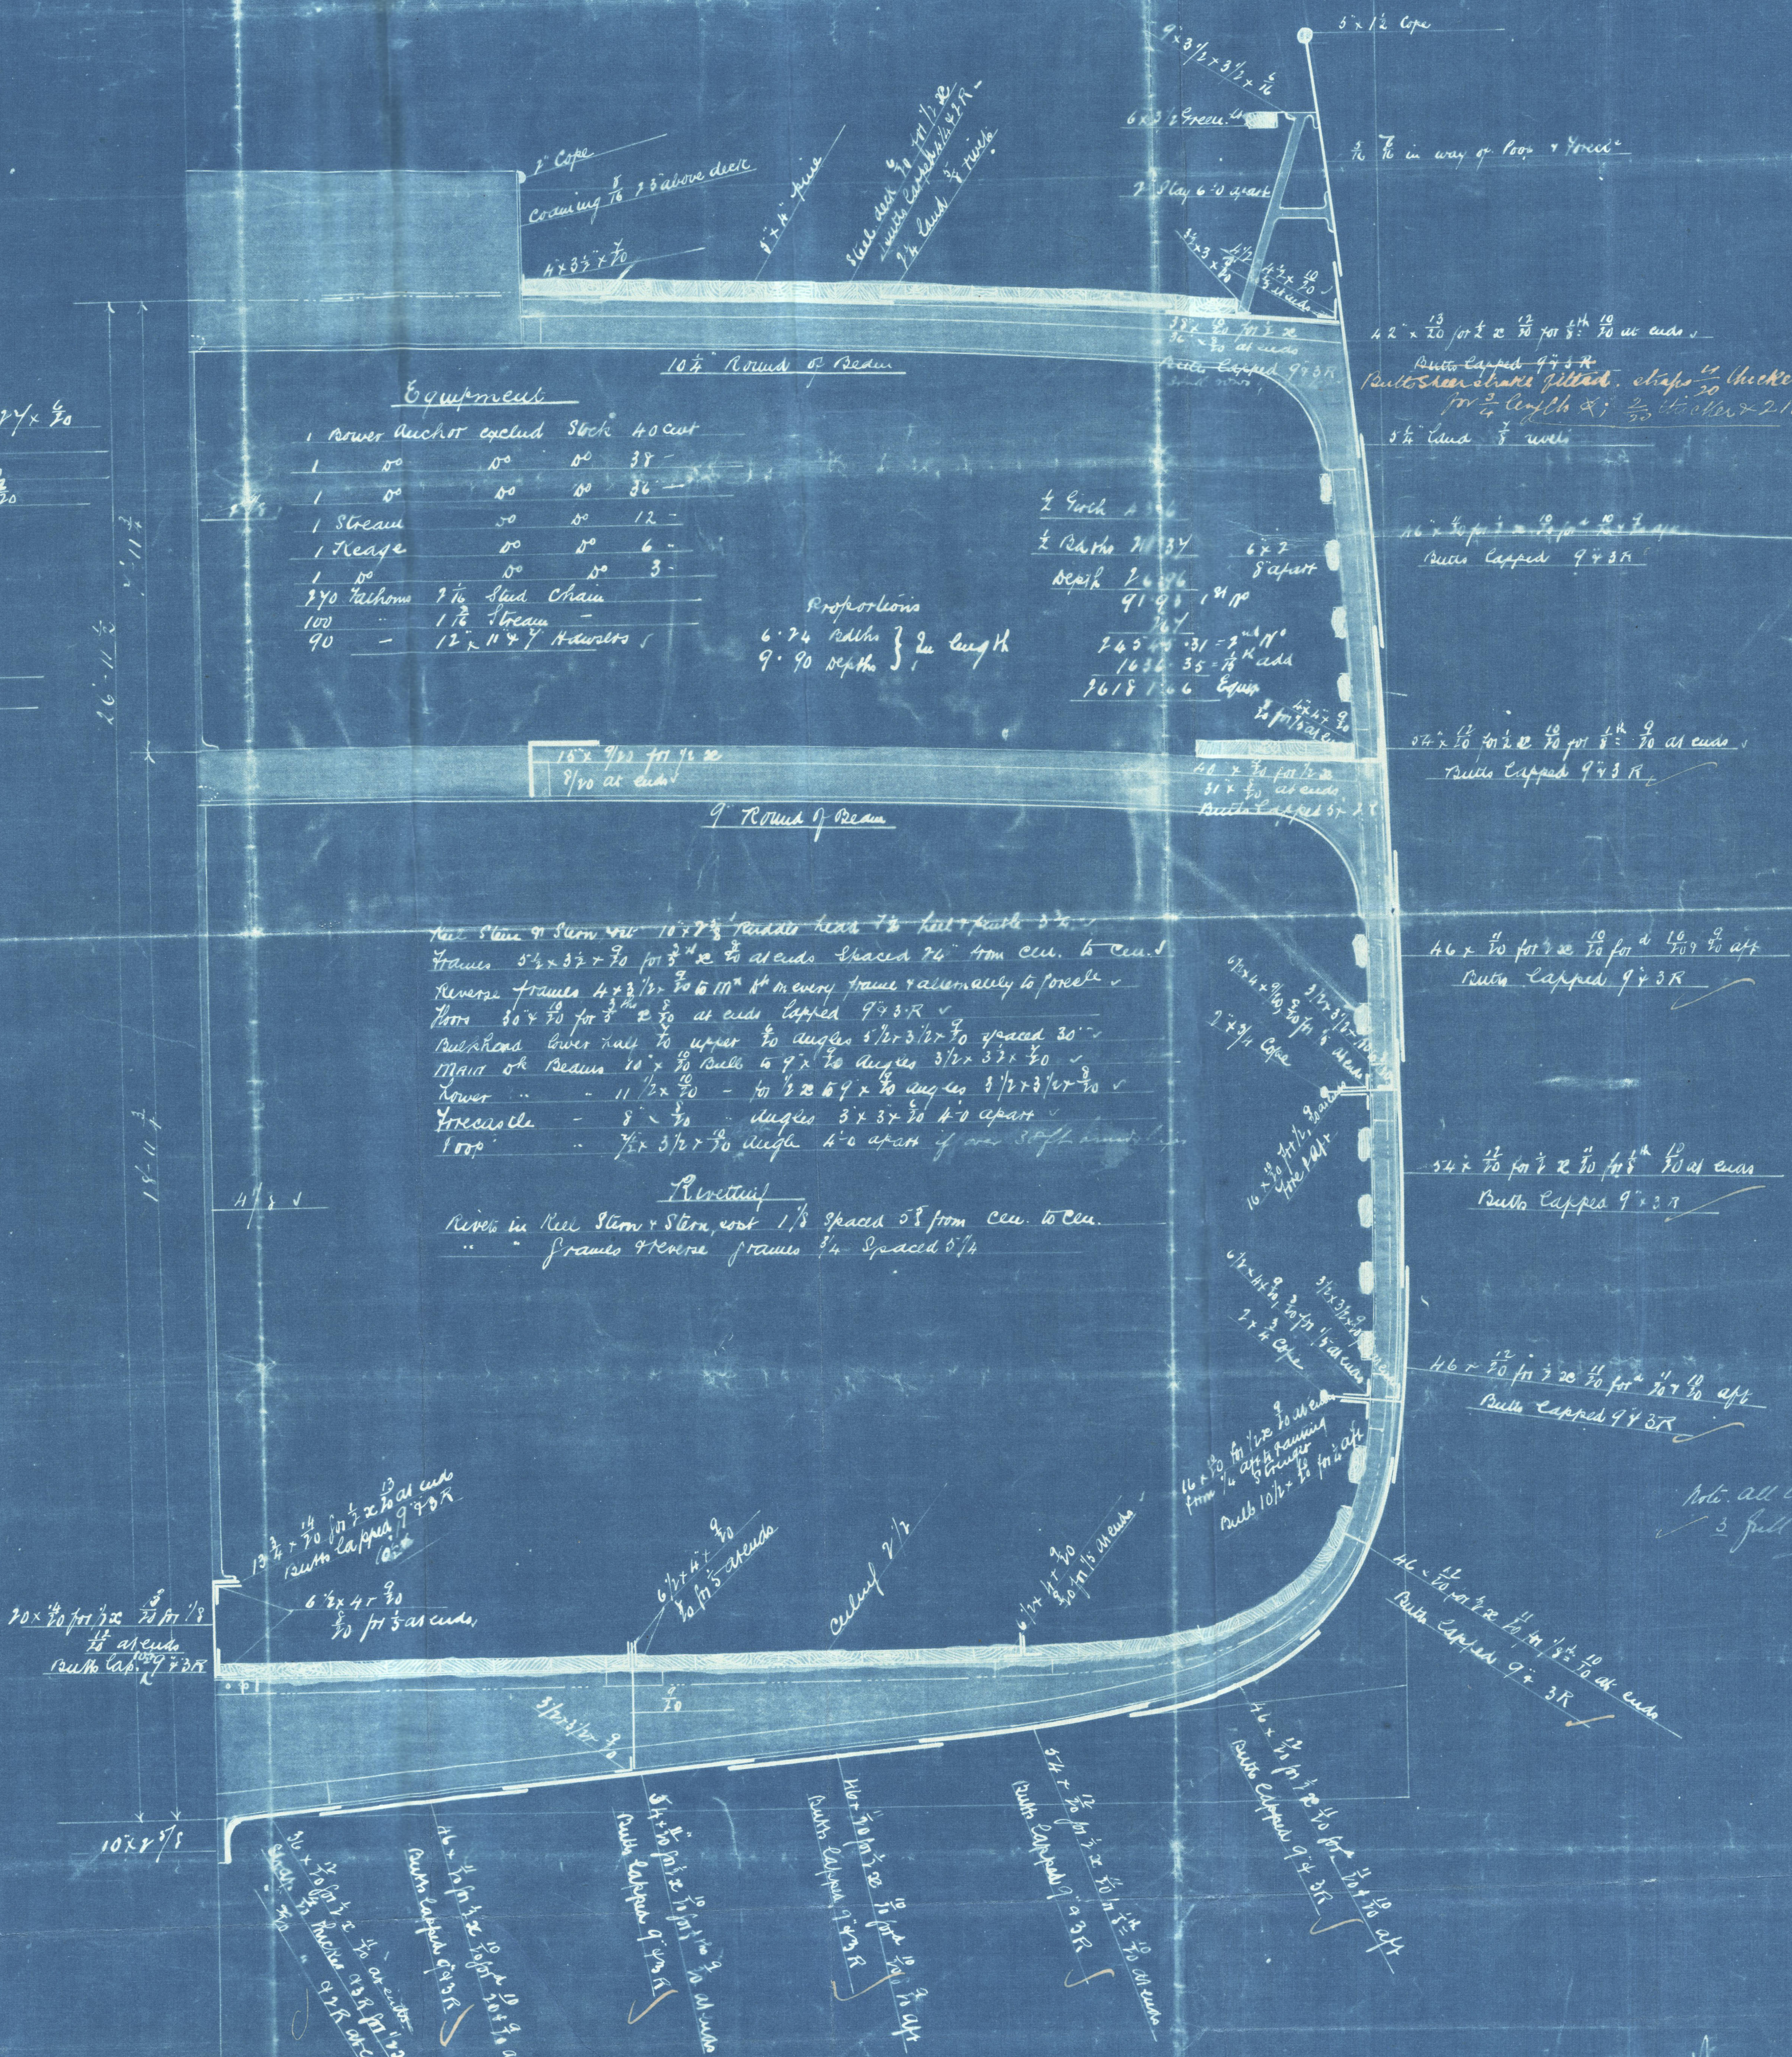

Note: all capped bulks 5 have  
3 full mms of steel

13/9/89  
Lloyd's Register  
Foundation

GRK315-0126



Russell & Co no 232  
"Snaigow"

Greenock Report  
no. 10048.



3-1832-3  
J. S. & Co. Secy



GRK 315-0126

© 2020

Lloyd's Register  
Foundation