

"Snairow"

Received at

Office,

38

Lloyd's Register of British and Foreign Shipping.

(Report on Vessel No. 10018 Port of Greenock)

No. 2414

SHIP FORGINGS OR CASTINGS.

I have to report that the undermentioned Iron or Steel Forgings or Castings, manufactured by
The Portland Forge Co of *Hilmarnock*
for the Vessel No. *233*, being built by *Messrs Russell & Co*
of *Port Glasgow* have been inspected by me as set forth below, and found
to be, so far as can be seen, *Sound & efficient*

Mark on Forgings.

Lloyd's

No. 2414


W.H.

William Hamilton

Glasgow
28/3/90

	STERN FRAME.	RUDDER FRAME.	STEM.
Material*		<i>Scrap iron</i>	
How made		<i>Forged</i>	
Dimensions		<i>7 1/2 to 3 3/4</i>	
Progress on Inspection		<i>Forging & smithing</i>	
Dates when Inspected		<i>2. 4. 15. 23. 25. 30/4/90</i> <i>6. 8. 10. 13. 16. 23. 27/5/90</i>	

SKETCHES OF FRAMES SHEWING POSITION AND DESCRIPTION OF WELDS OF FORGINGS, OR PARTICULARS OF TESTS APPLIED TO CASTINGS.

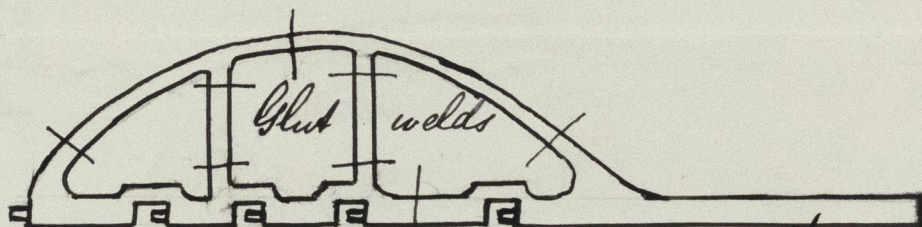

Scarf weld

*Used in
Stern No 233*

Russell & Co.
No 233. Rudder Frame
Used w No 232

SHIP FORGINGS OR CASTINGS

(Report on Form No 1)

Form

Special Register of British and Foreign Shipping



© 2019

Lloyd's Register
Foundation