


Blackwood & Gordon  
 No. 270.  
 S. S. Satellite.  
 Gen. Report No. 1000.

GRK 315-0196

THE REGISTER  
 LONDON  
 100, MARK LANE  
 1895

1 1/4 Dia 1 1/2 Green  
 1 1/4 Dia 1 1/2 Green  
 1 1/4 Dia 1 1/2 Green

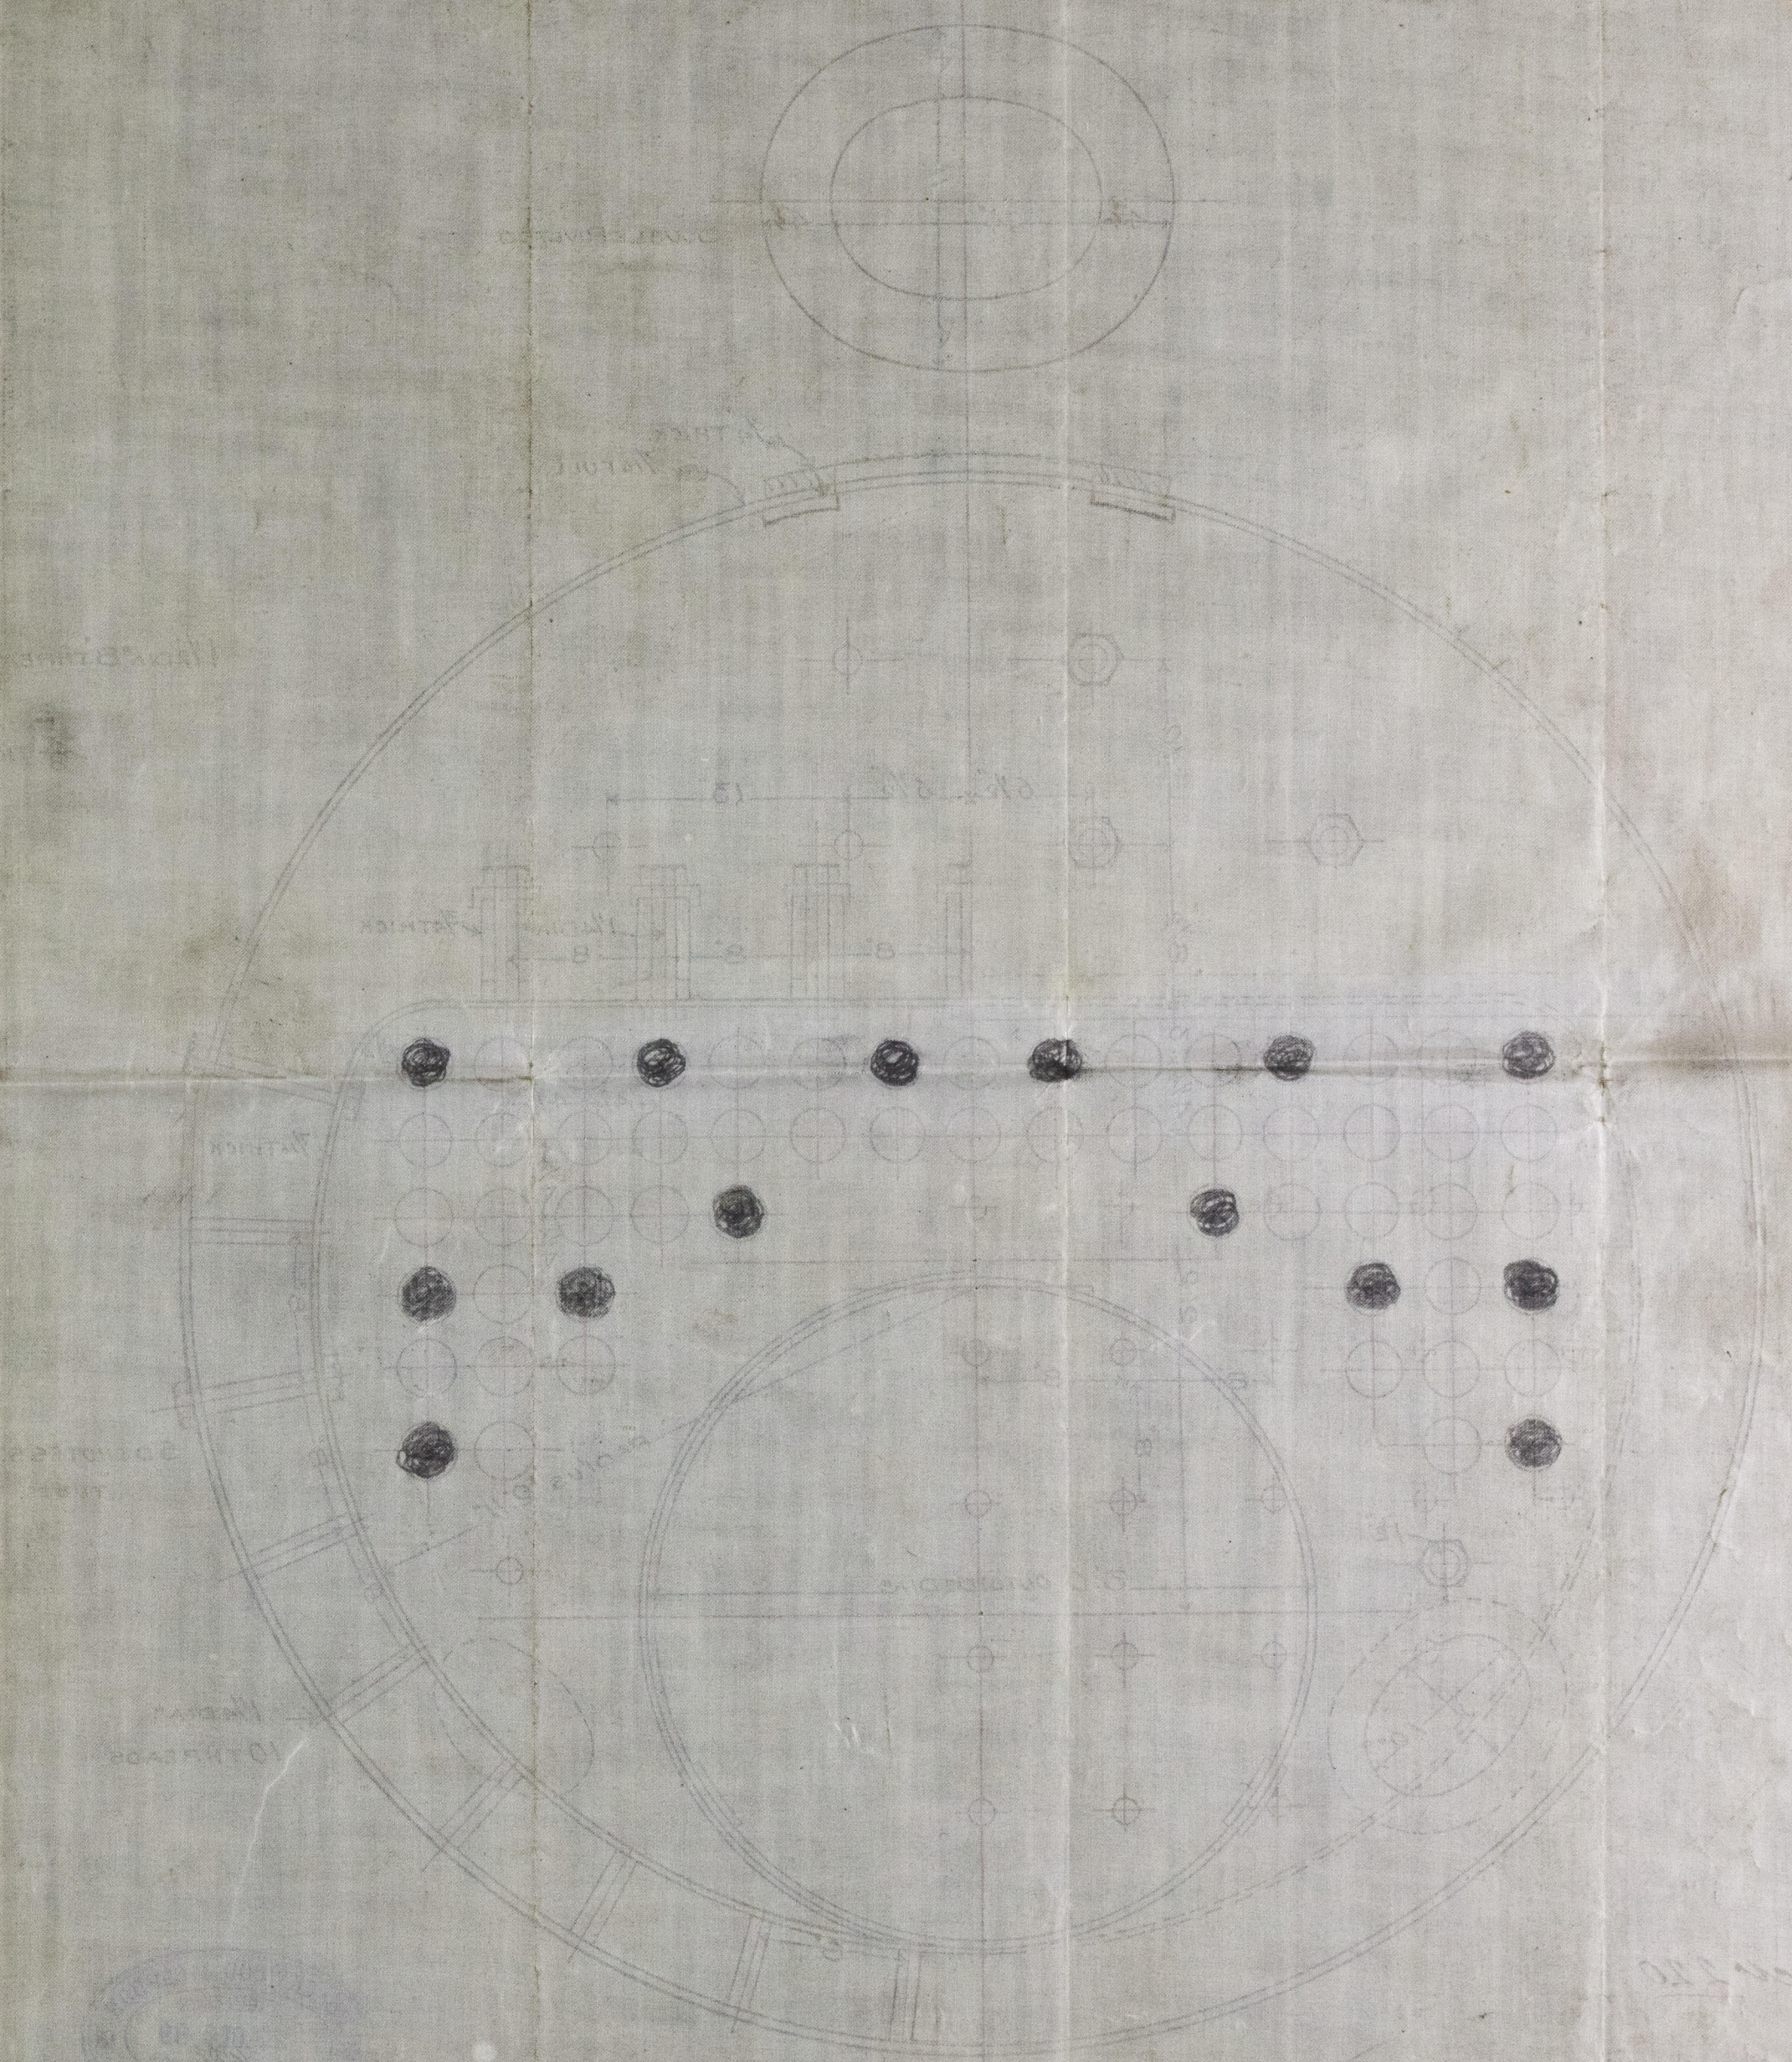



THE REGISTER  
 LONDON  
 100, MARK LANE  
 1895

W 305 DONKEY BOILER



Dec 6 1 90

S. S. Satellite  
Gen. Report No. 10060.

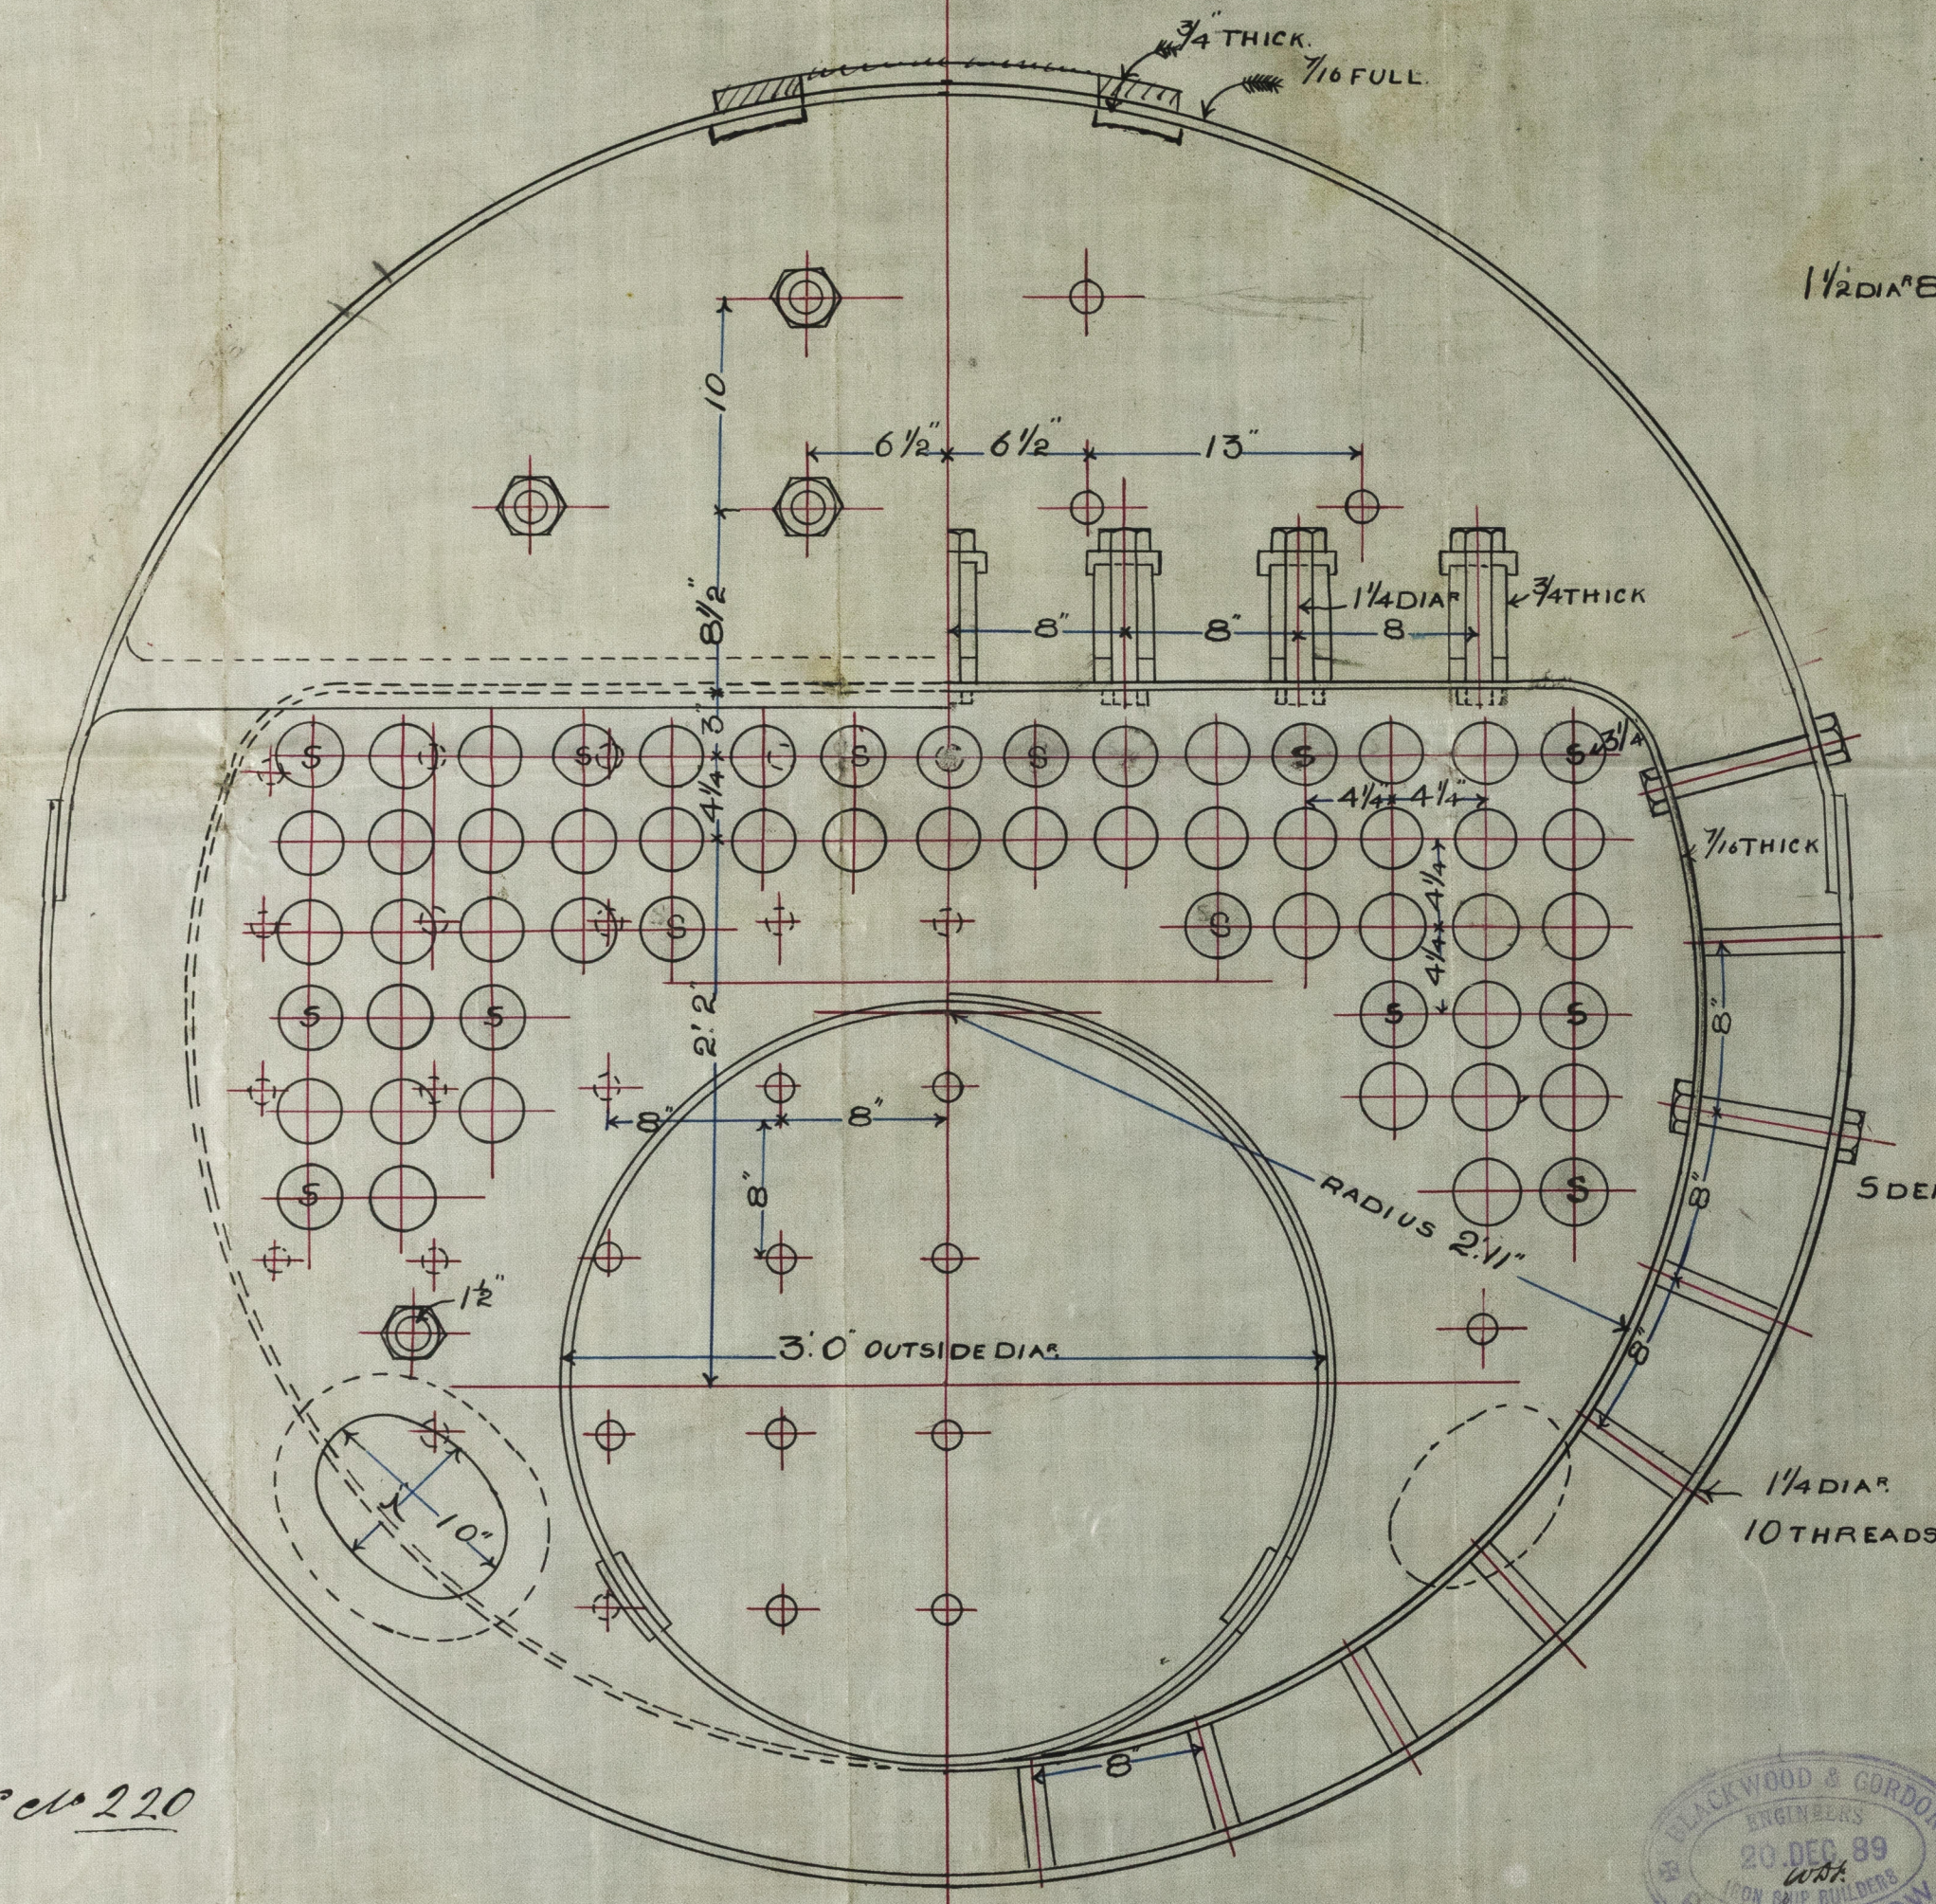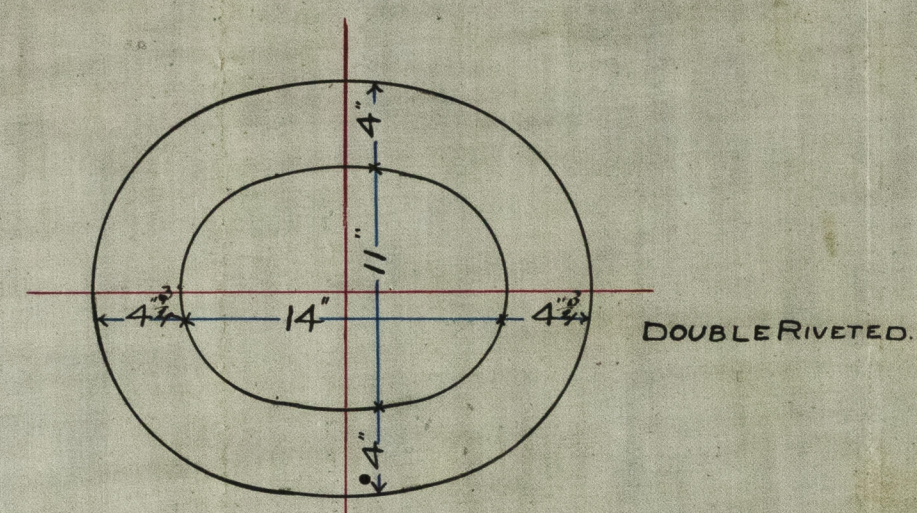

1 1/2 DIA 8 THREAD

5/8 THICK

1/2 DIA STEEL

5.2 INSIDE TUBE PLATES

DIA OF TUBES 3 PLAIN NO WG 10. STAY TUBE 1/4 THICK  
D OF IRON  
D OF SCREWED INTO TUBE PLATES

1/32 THICK

4.0 INSIDE DIA  
3.0 OUTSIDE DIA

PITCH 1 1/2 RIVET HOLES

7.3 OVERALL

5/8 THICK


1 3/8 DIA 10 THREADS  
1 1/4 DIA 1 3/8 DIA

1/16 THICK

3 1/2

1/16 THICK

1 1/4 DIA

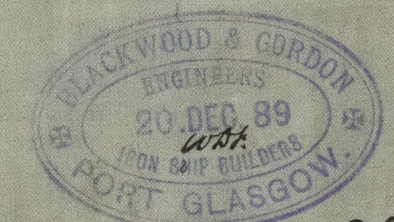

Drawing No 23

Exam 3/1/90  
New

For SS No 220

# No 302 DONKEY BOILER.

SCALE 1 1/2 INCHES = 1 FOOT.

80 LBS. PER. INCH OF WORKING PRESSURE LLOYDS SURVEY. PLATES OF STEEL