
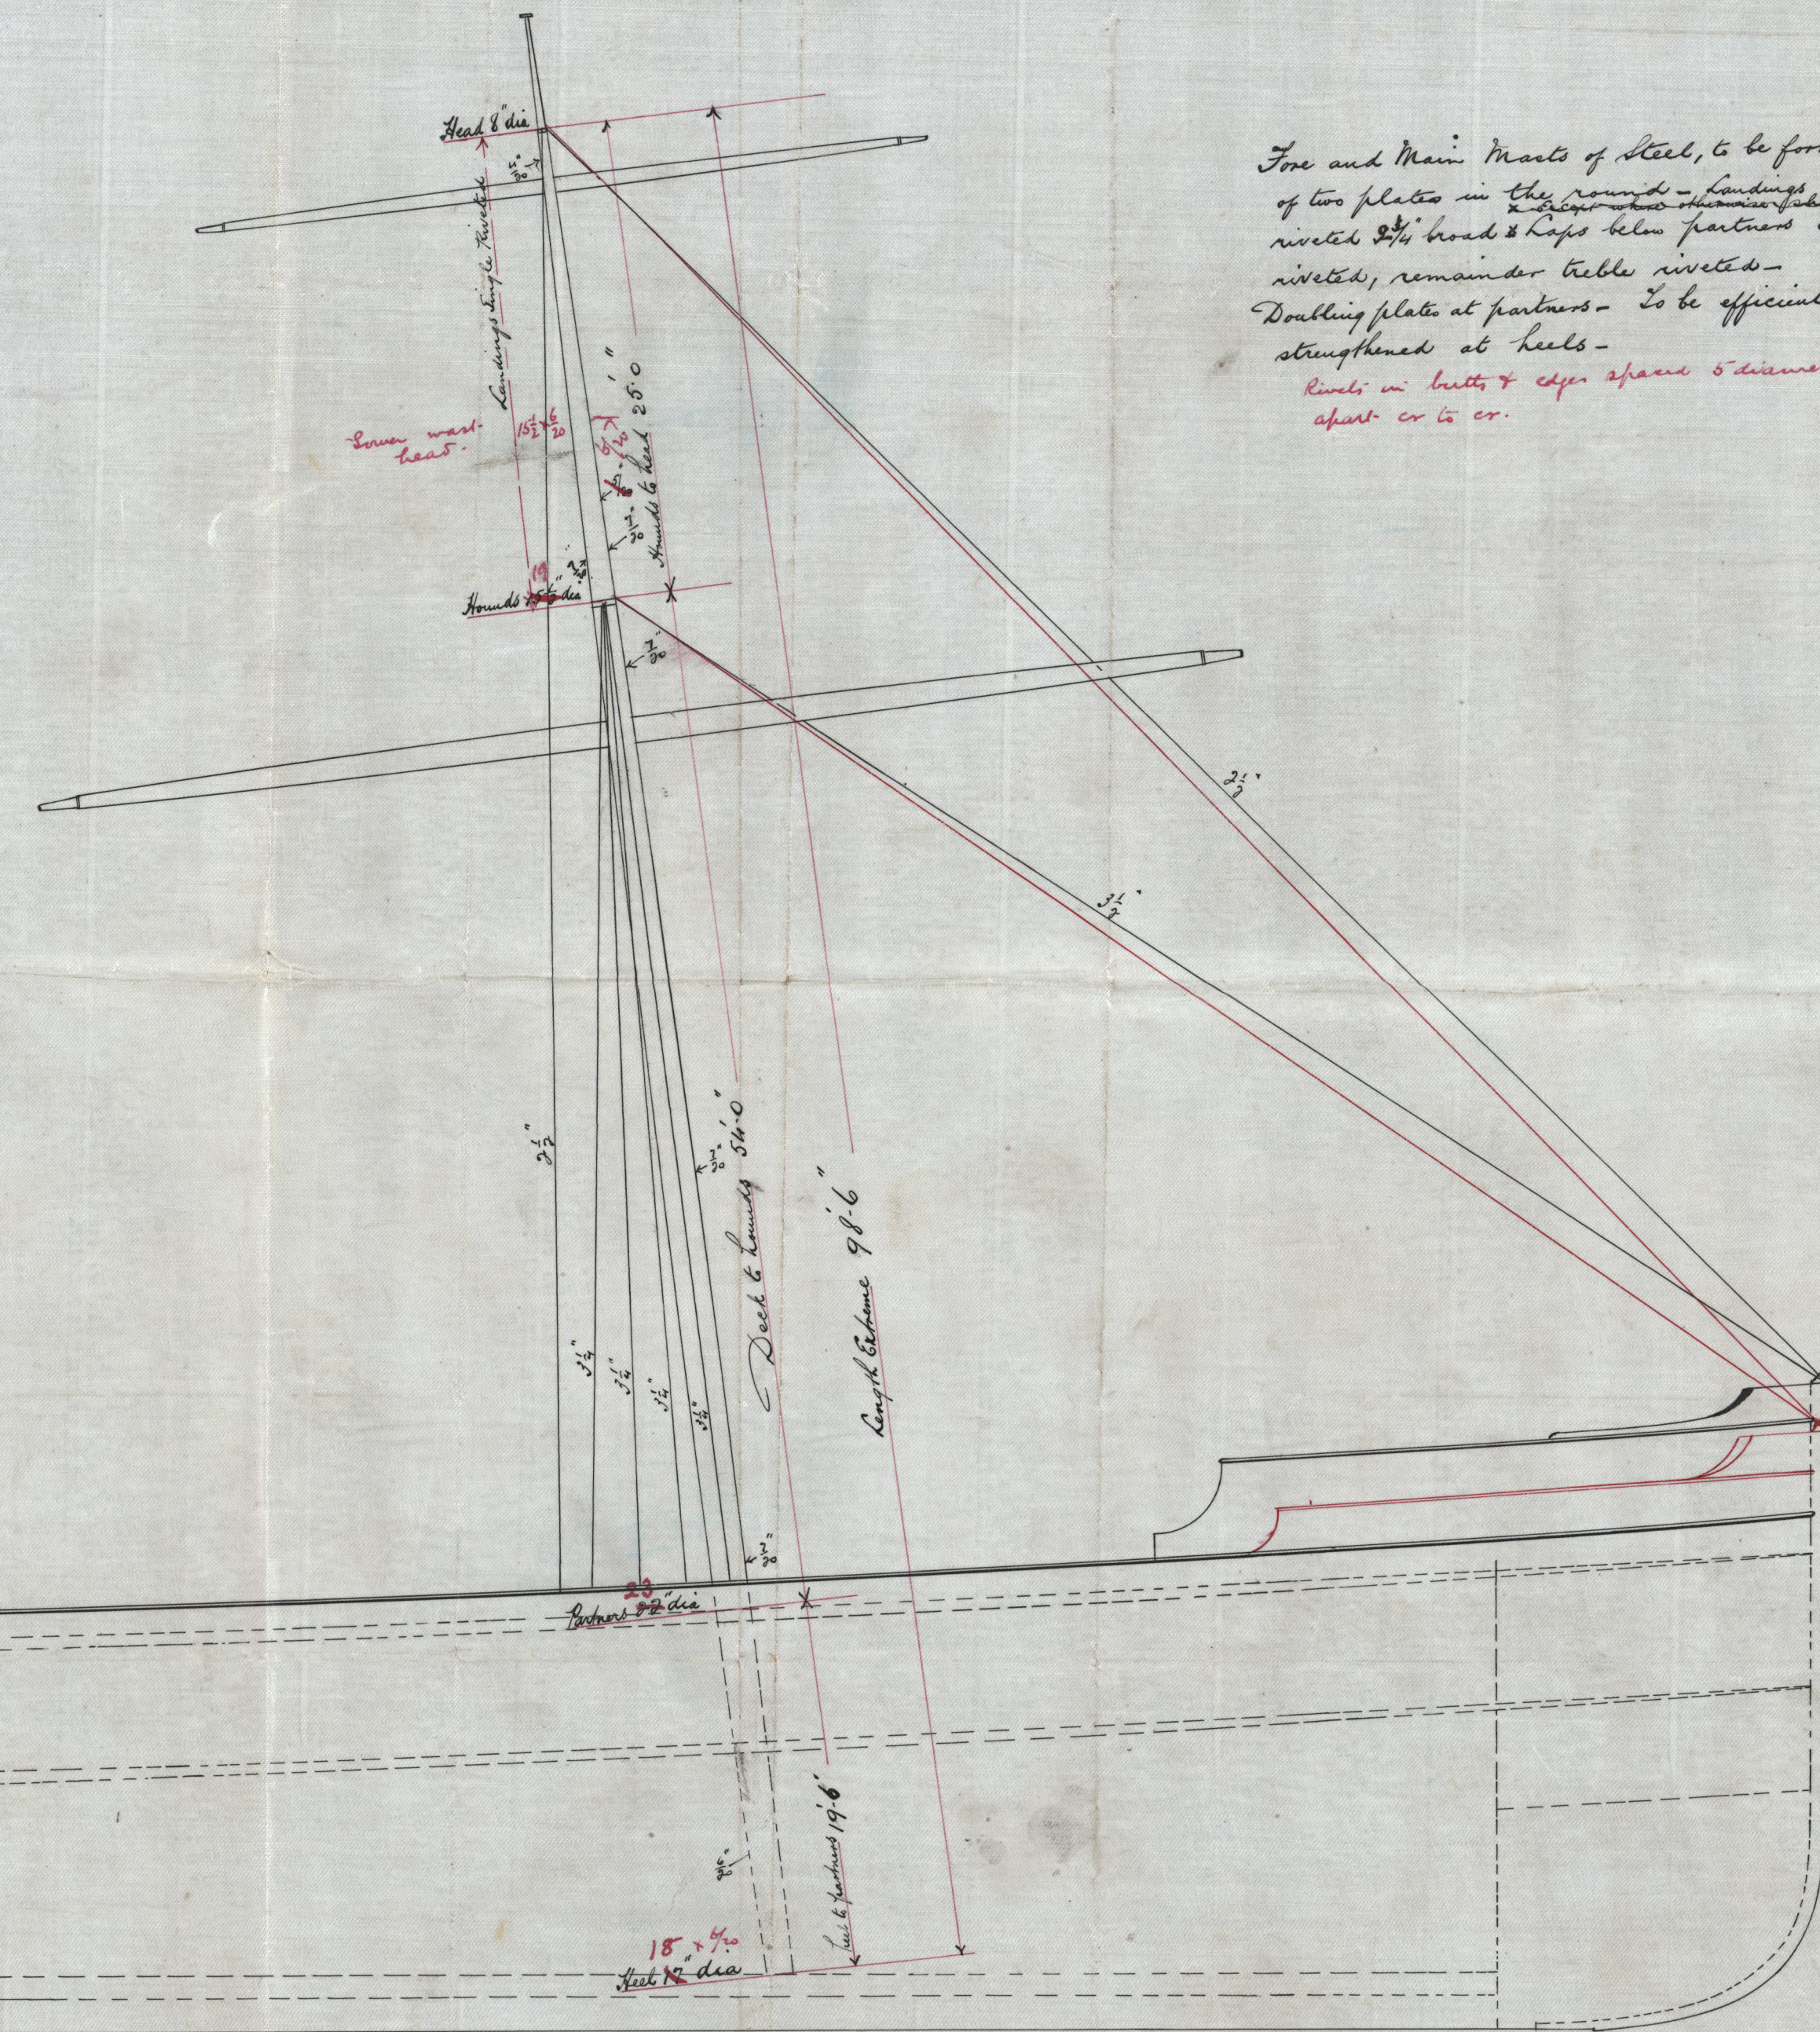


*S. S. Satellite.*  
Gen. Report No. 10060.

Plan showing Scantlings of Masts  
Scale  $\frac{1}{8}$  inch = 1 foot

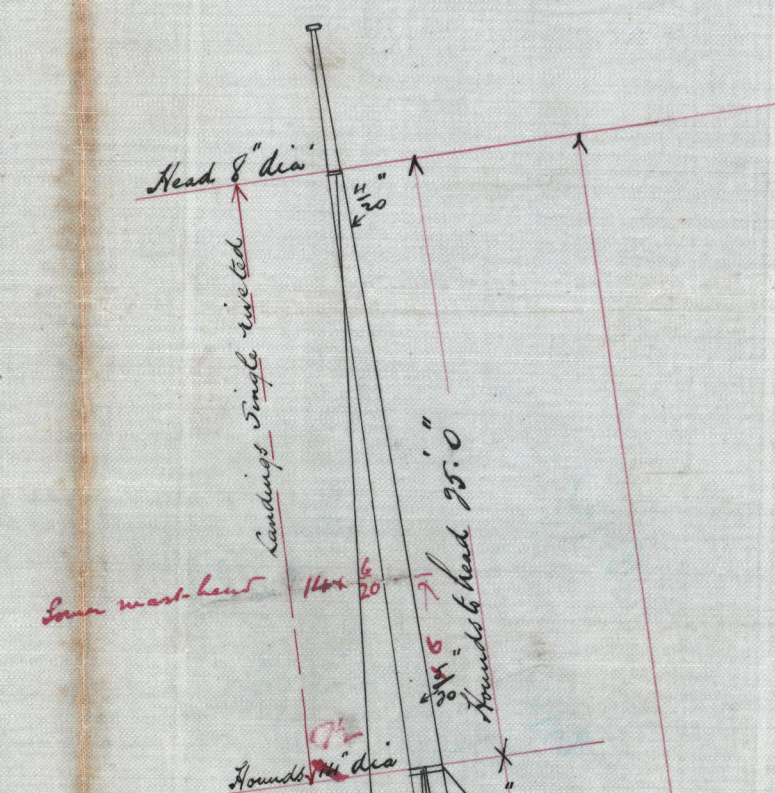

Fore and Main Masts of Steel, to be formed  
of two plates in the round - <sup>single</sup> Landing <sup>double</sup>  
riveted <sup>to the mainmast</sup> <sup>to the foremast</sup> <sup>to the mainmast</sup>  
to the board & keels have partners double  
riveted, remainder keels riveted -  
Doubling plates at partners - To be efficiently  
strengthened at heels -  
Keels in brigs & open square 5 diameters  
apart or to cr.

J. H. L.  
18/4/90



7

S. S. Satellite  
Grk. Report No. 10060

GRK 315-0199



© 2020

Lloyd's Register  
Foundation