

071312-0500

THU 5 DEC 83

WED 29 JAN 90

THU 20 FEB 90


mmmm

"Satellite"  
TWIN Greenock Report n...


# Midship Section of S.S. N<sup>o</sup> 220

Scale  $\frac{1}{2}$  in. = 1 foot

Class 100 A1. at Lloyd's

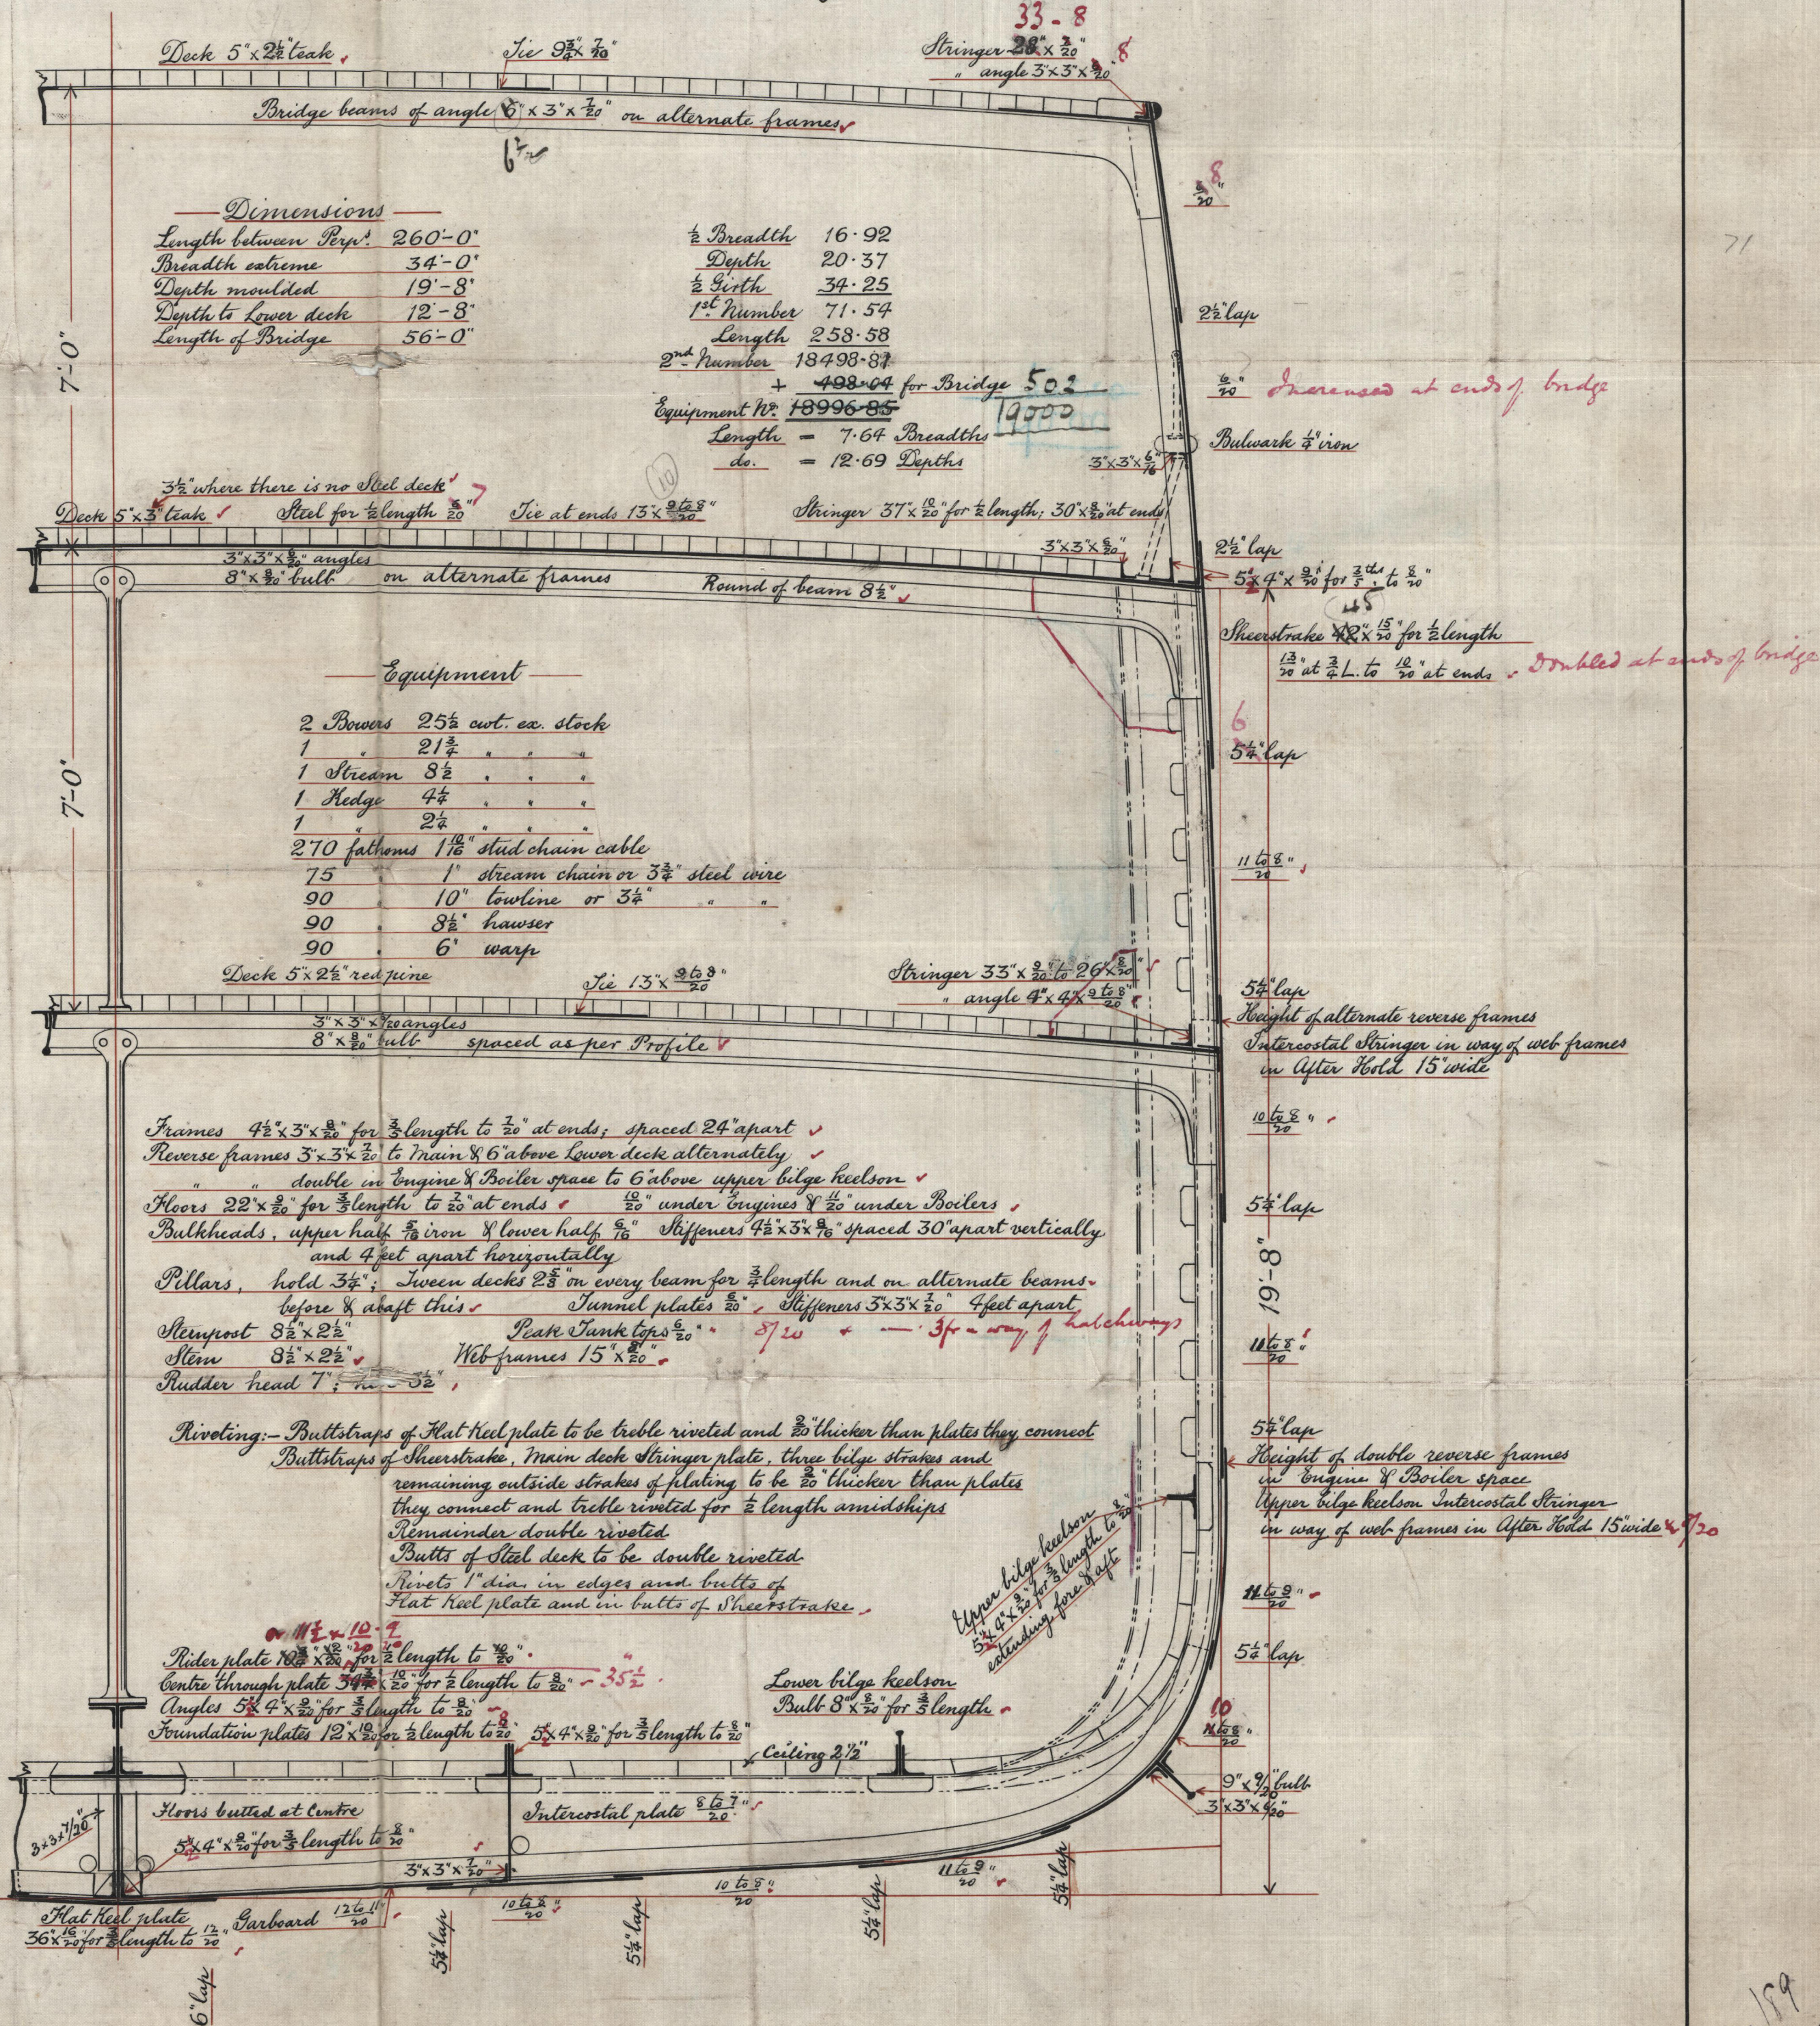

Section in way of Webframes  
in afterhold (for spacing see profile)

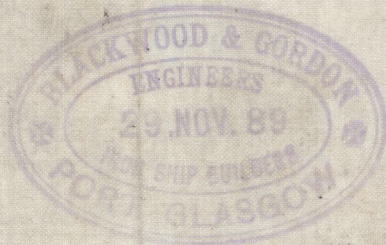

10/1  
4/12/89

Notes: Where strakes exceed Rule breadth, strakes to be 1/2 thicker.



