
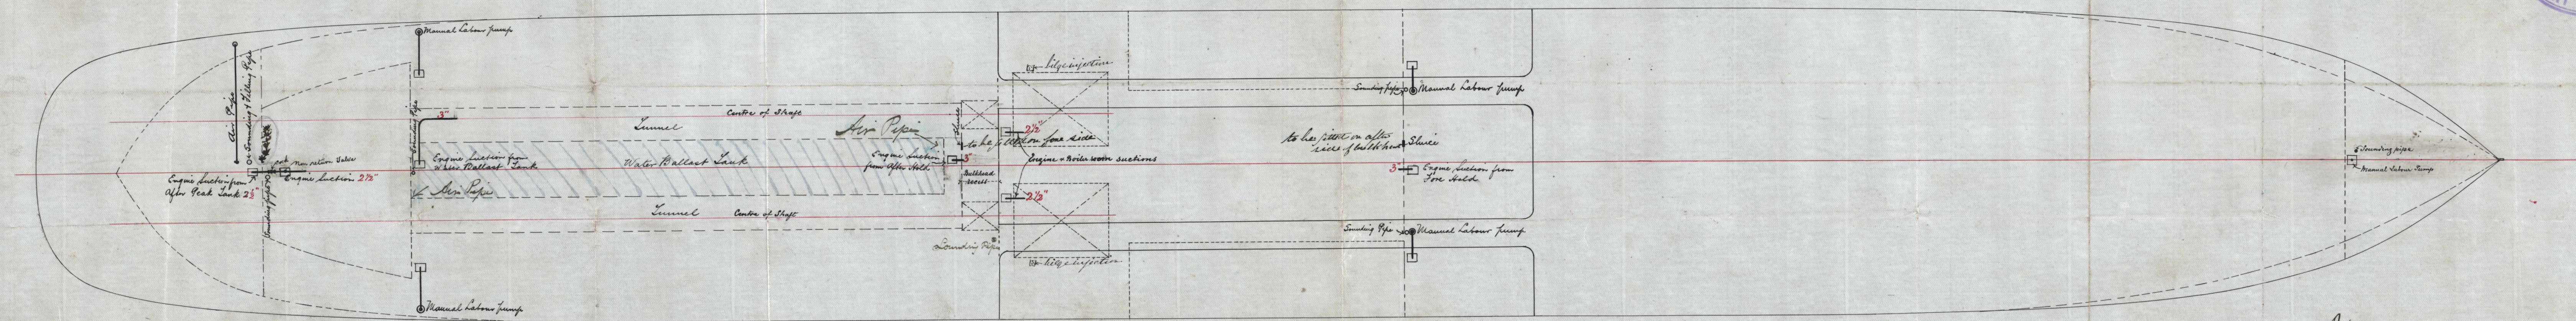


Dec 28/11/90

S. S. Satellite
 Pumping Arrangement ^{TWIN} S. S. 220 *Gen. Report No. 10060.*
 Scale $\frac{1}{8}$ inch = one foot

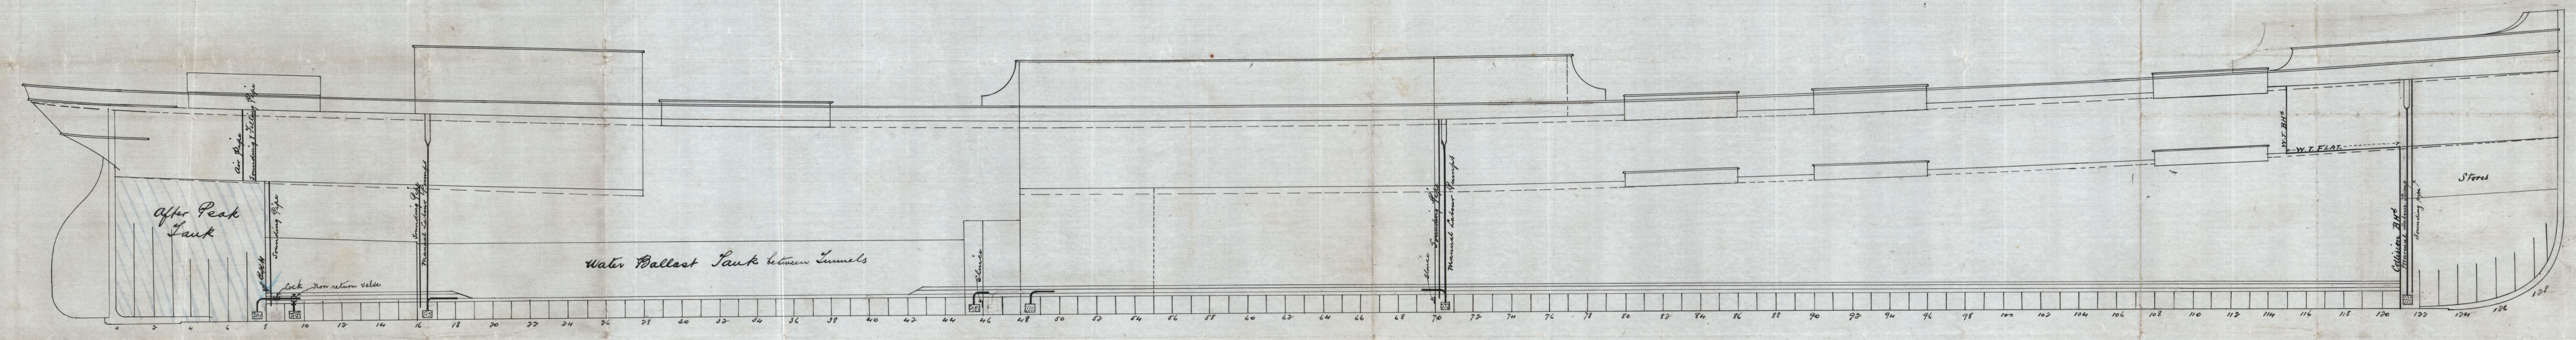

BLACKWOOD & GORDON
 ENGINEERS
 24 - APR 90
 115 118
 IRON SHIP BUILDERS
 PORT GLASGOW


MA.
 26.4.90

REGISTER OF SHIPS
 LLOYD'S REGISTER
 FOUNDATION

GRK315-0201

S. S. "Satellite"
Grk. Report No. 10060

GRK 315-0201

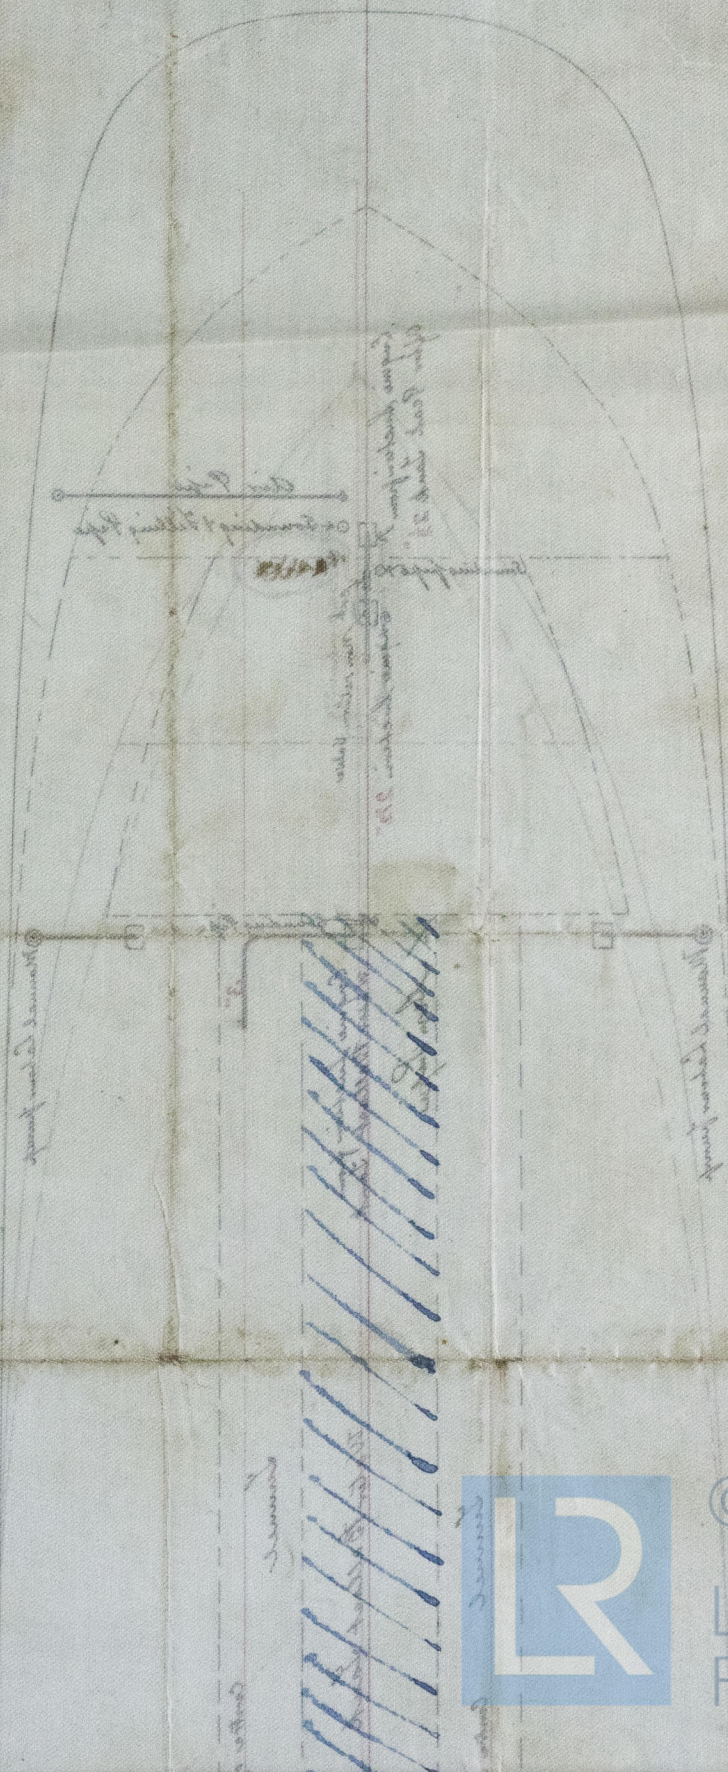

© 2020

Lloyd's Register
Foundation