

Russell & Co.

No 232 & 33 also 245 & 246

no 245. "Breidablik"


Grate Rpt No-

London
Fri 13 Sep 89.
Wed 25 Sep 89.

Log 4 Stem 285 x 42.92 x 24.25 ft. old.

Forecastle 30.0
Stimulor 36 x 6.6 to 24 x 30
Side plating 70
Lee plate 11 1/2 x 30
Mast 32 x 32 x 30

Port 36.0

Equipment

Proportions
6.74 masts } 24 length
9.40 masts }


15 x 9 1/2 ft 1/2 in
8/10 at ends

9. Round of Beam


Plating


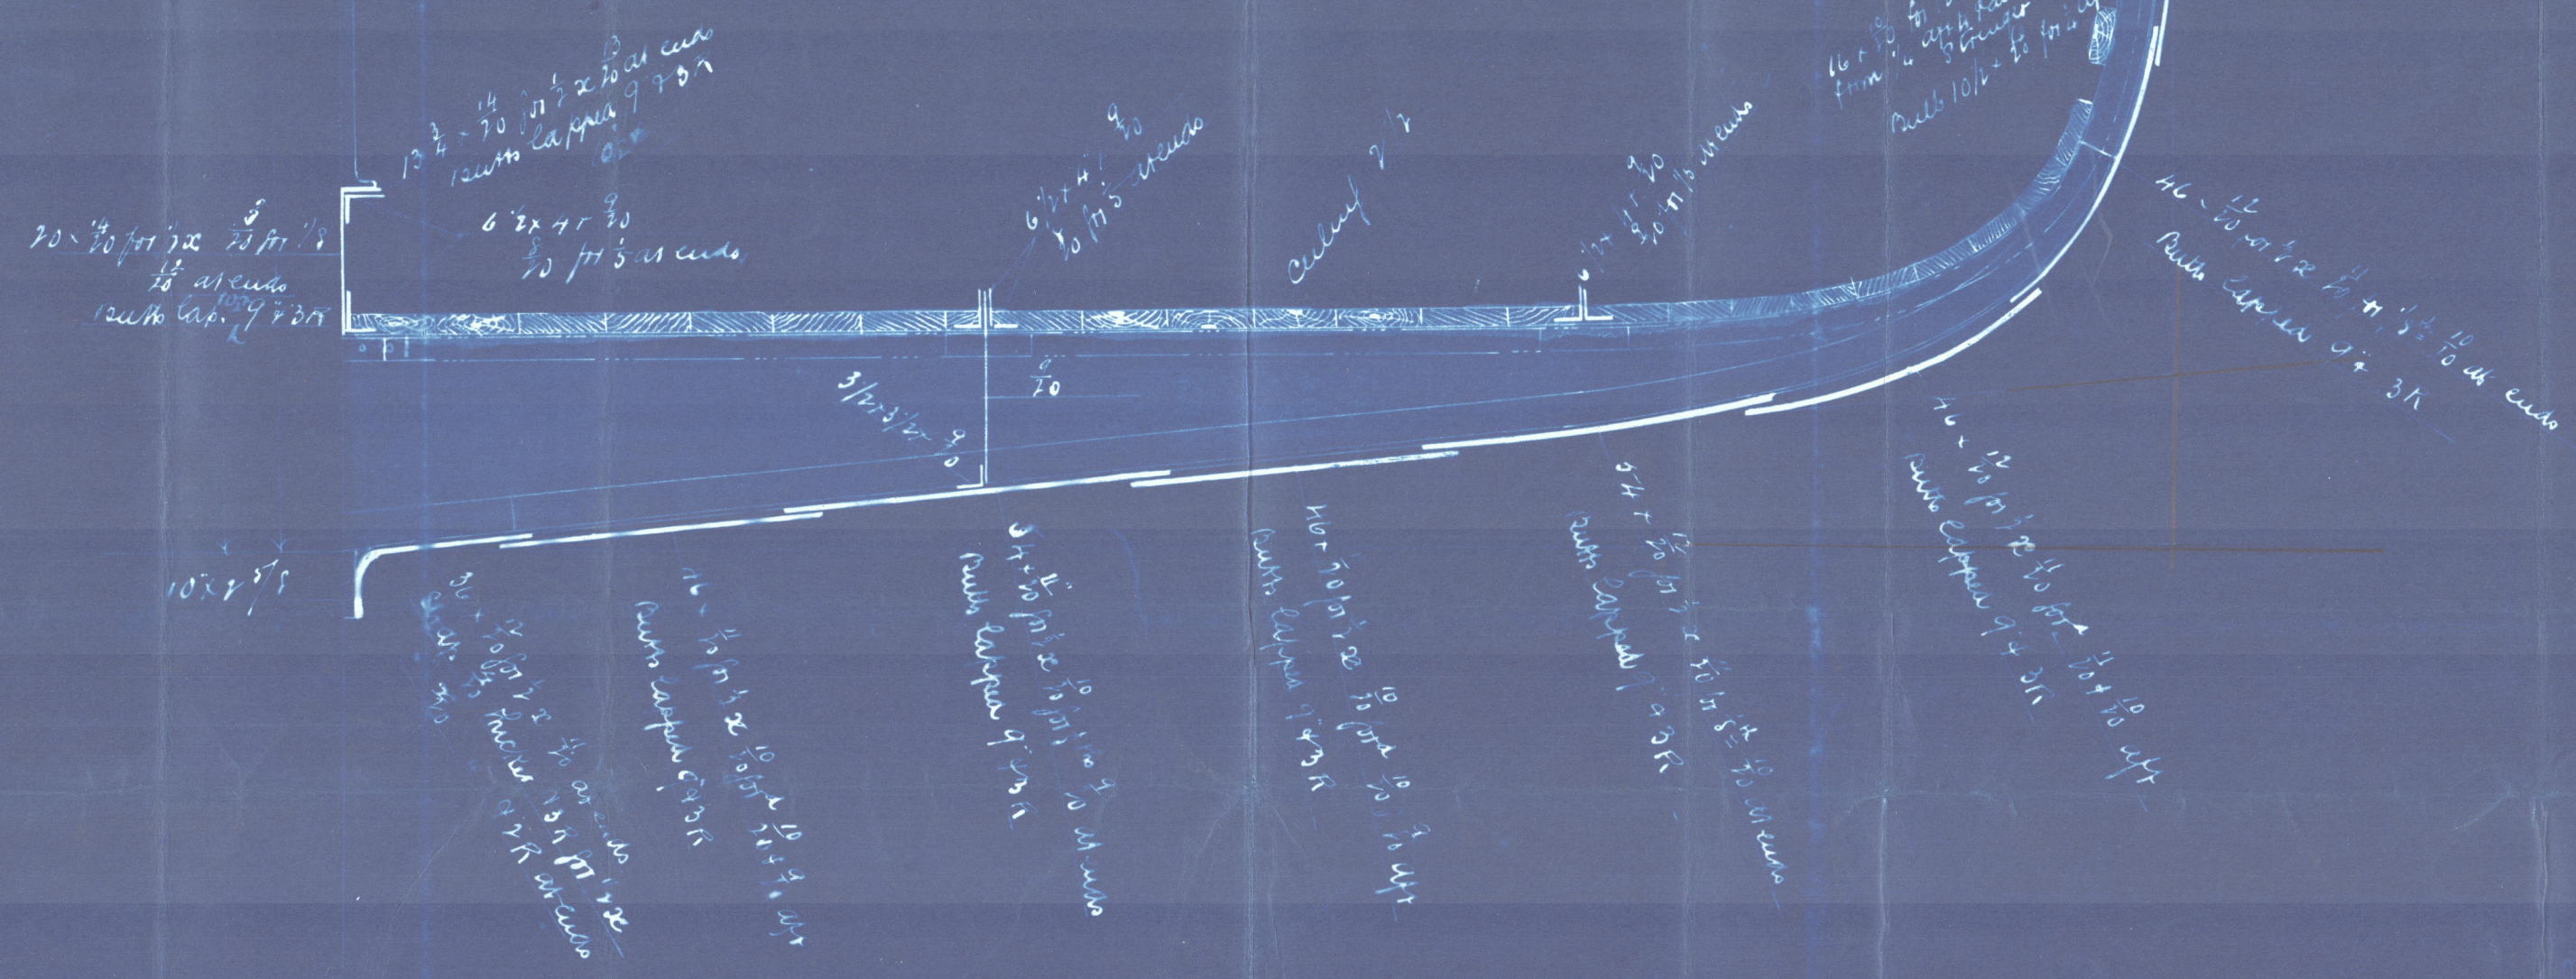

Middle Pectin

GRK316-0079

"Breidablik"
Greenock Report No. 10121

GRK316-0079

0079



© 2020

Lloyd's Register
Foundation