
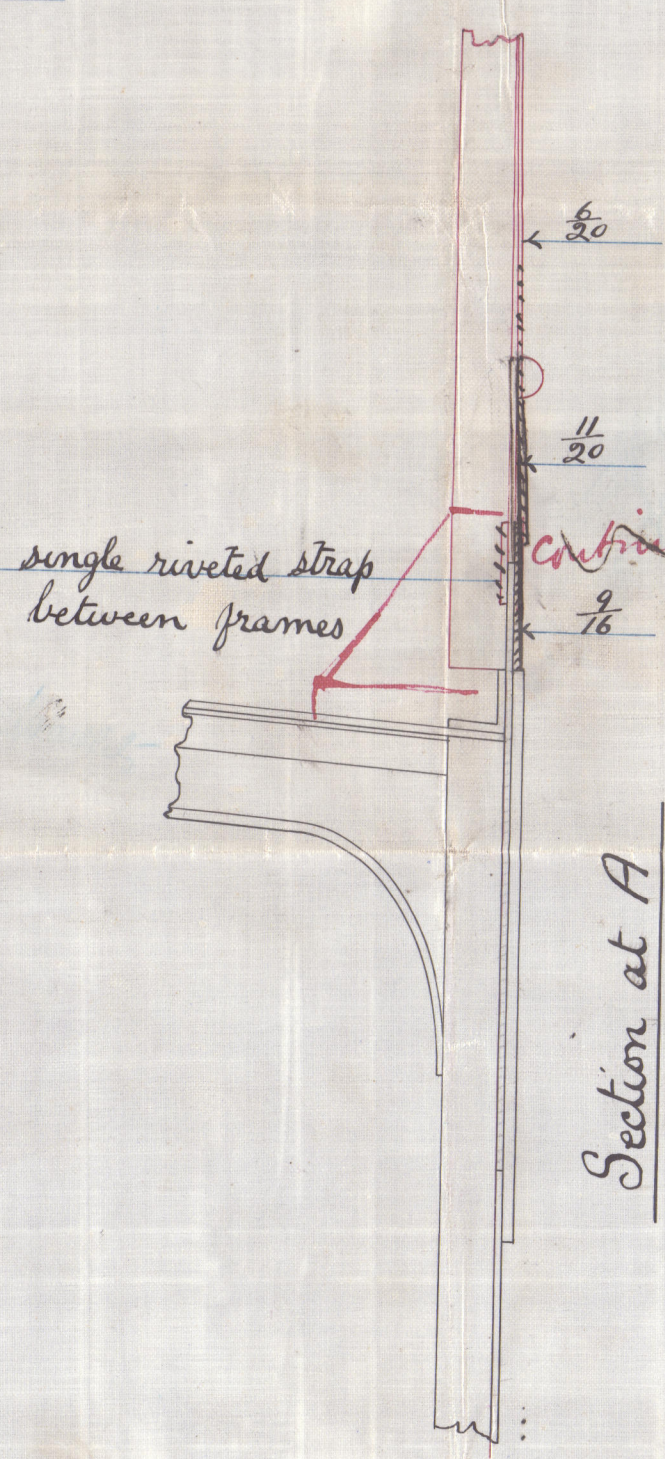
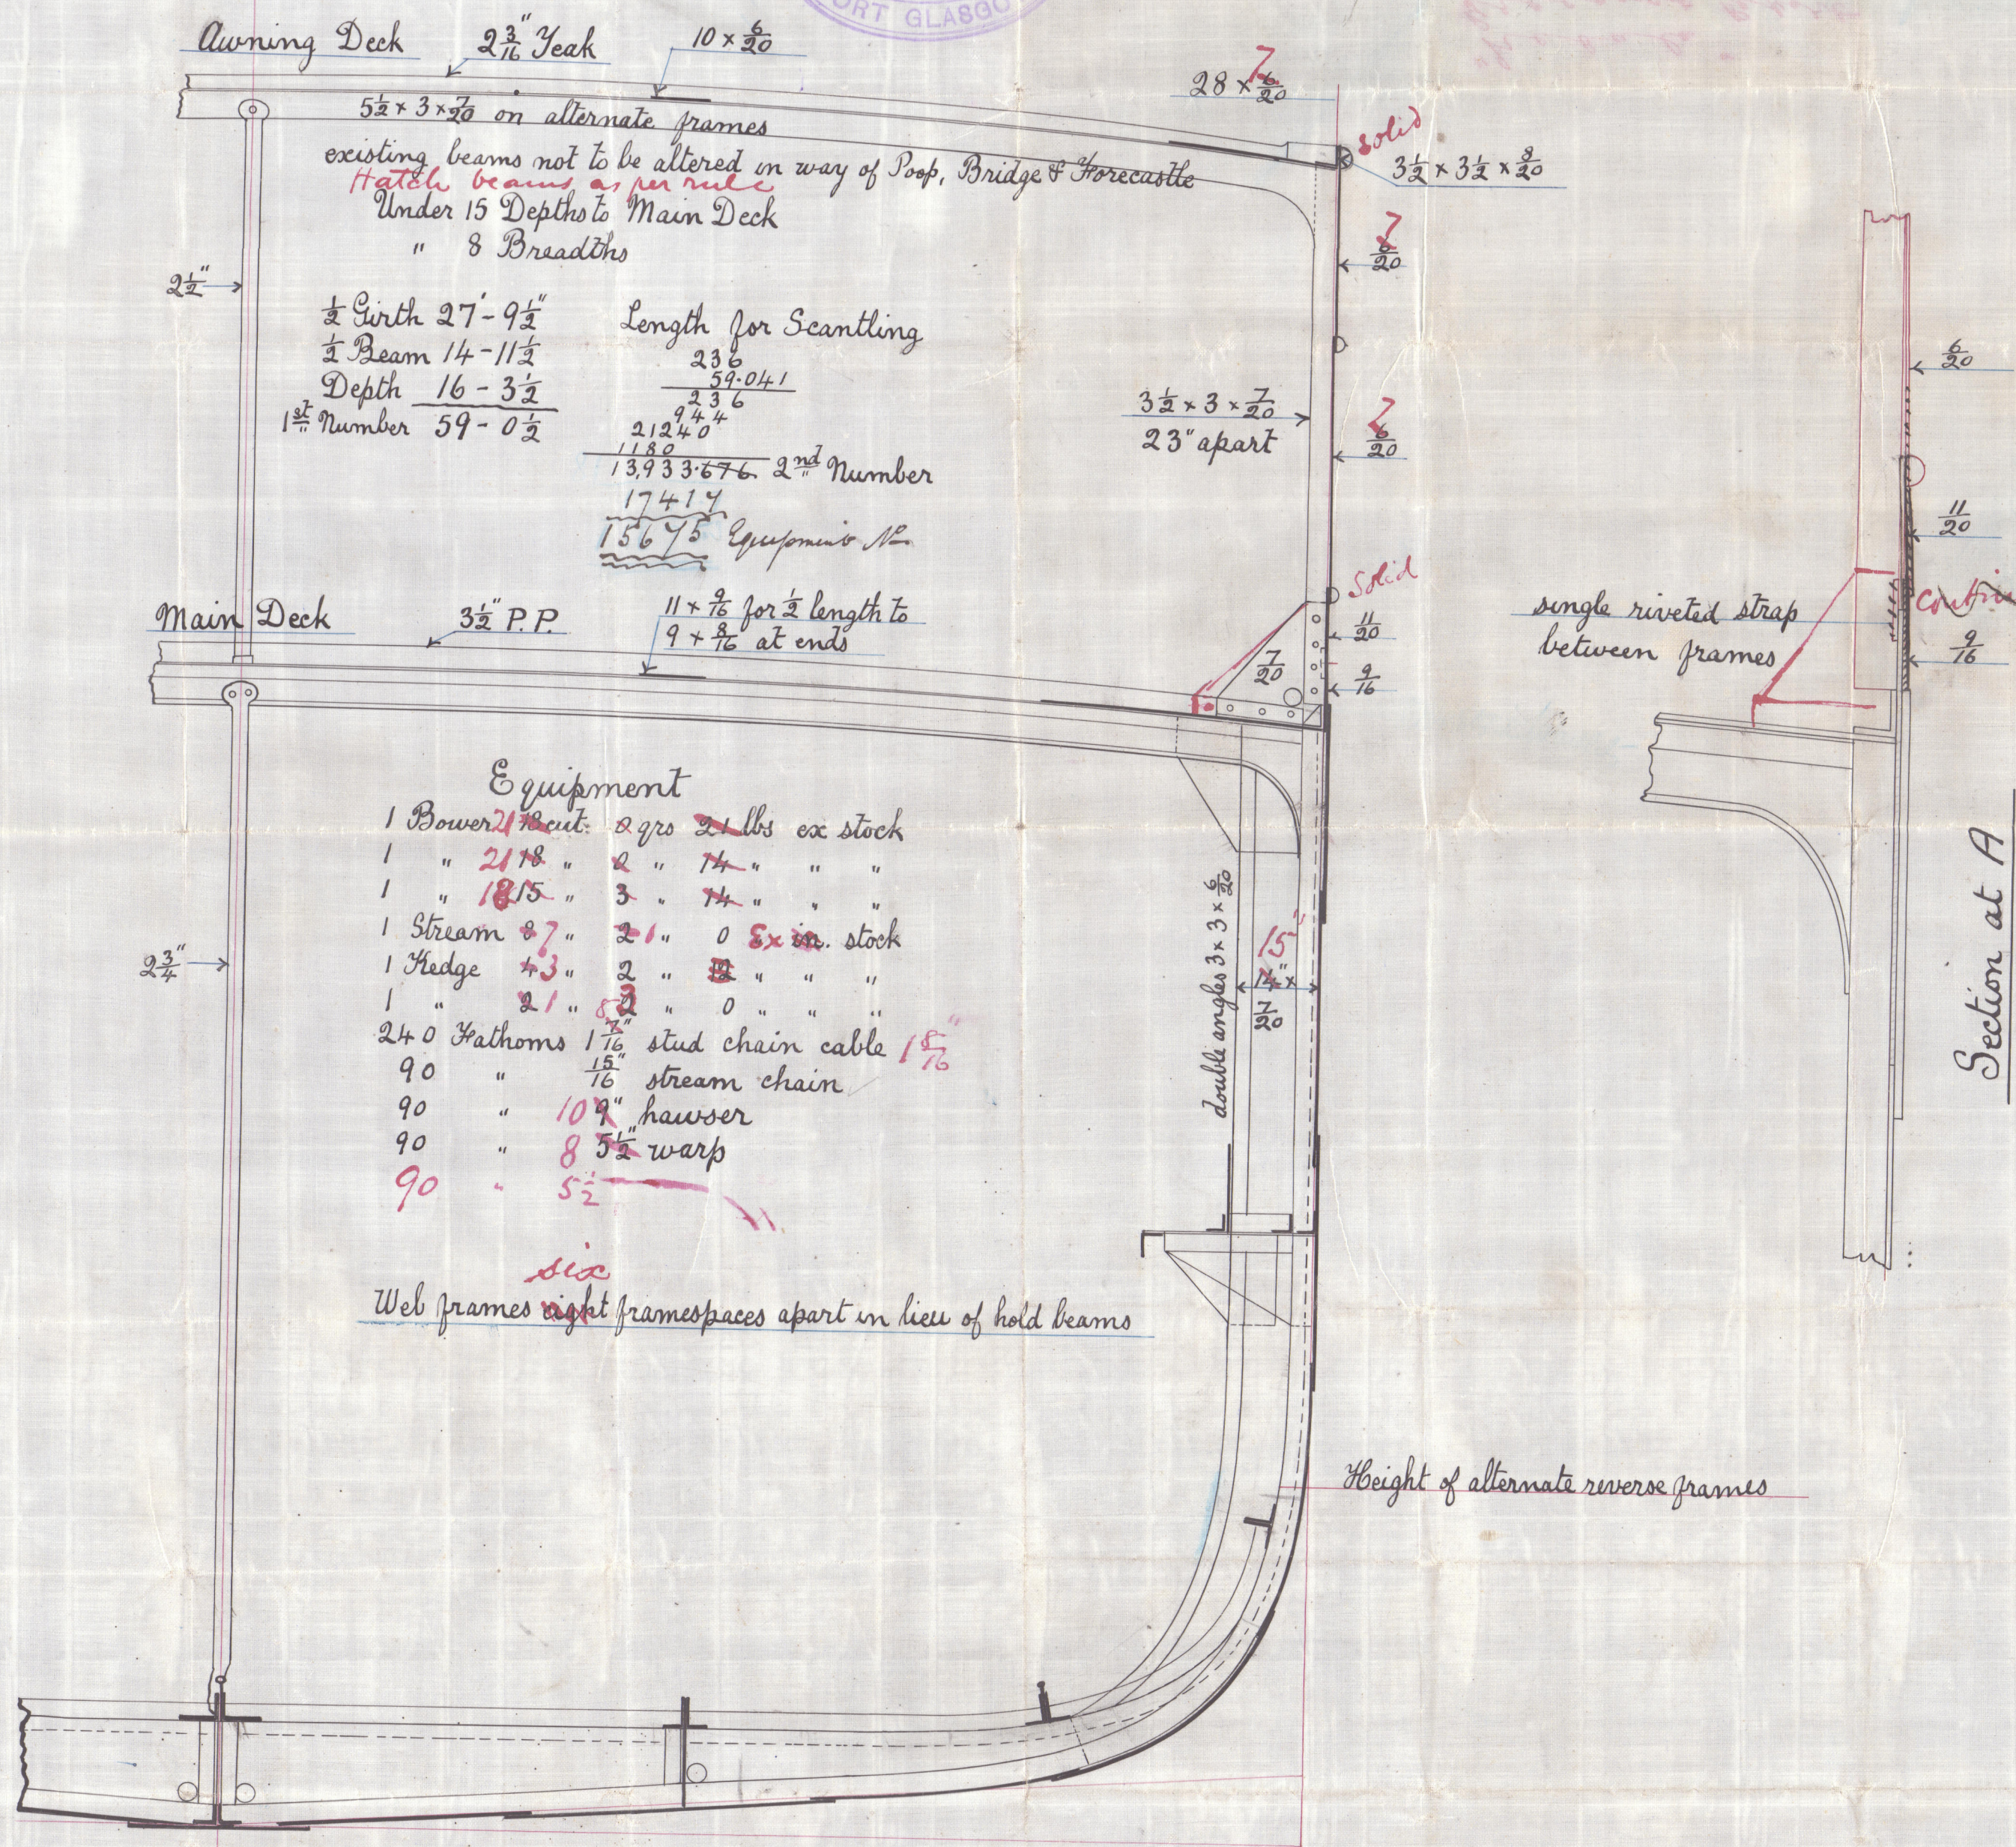


WED 17 SEP 90
MON 22 SEP 90

27/12/90.

Midship Section
Y. S. S. (late P. S.) "Baron Ory" now named "Nebula"
Proposed scantlings for Class 100 A1 Awning Deck

Scale $\frac{1}{2}$ Inch = to a Foot

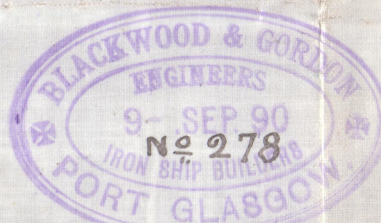

27/12/90

Spade bottom apron
completing recorded

11
5
1000


11
100

34x34 stone frames

"Hebala"
Greenock Report
No. 10.16.9

624316-0162



© 2020

Lloyd's Register
Foundation