


MON 22 SEP 90

U.S.S. "Baron Ozy" now named "Nebula"
Proposed Top Side Plating, outside view
Part shown in red to be new
Scale $\frac{1}{4}$ Inch to a Foot





"Nebula"
Greenock Report No. 10169

 

"Helula"
 Greenock Report No. 10169
 — "Helula!" —

GRH316-0167

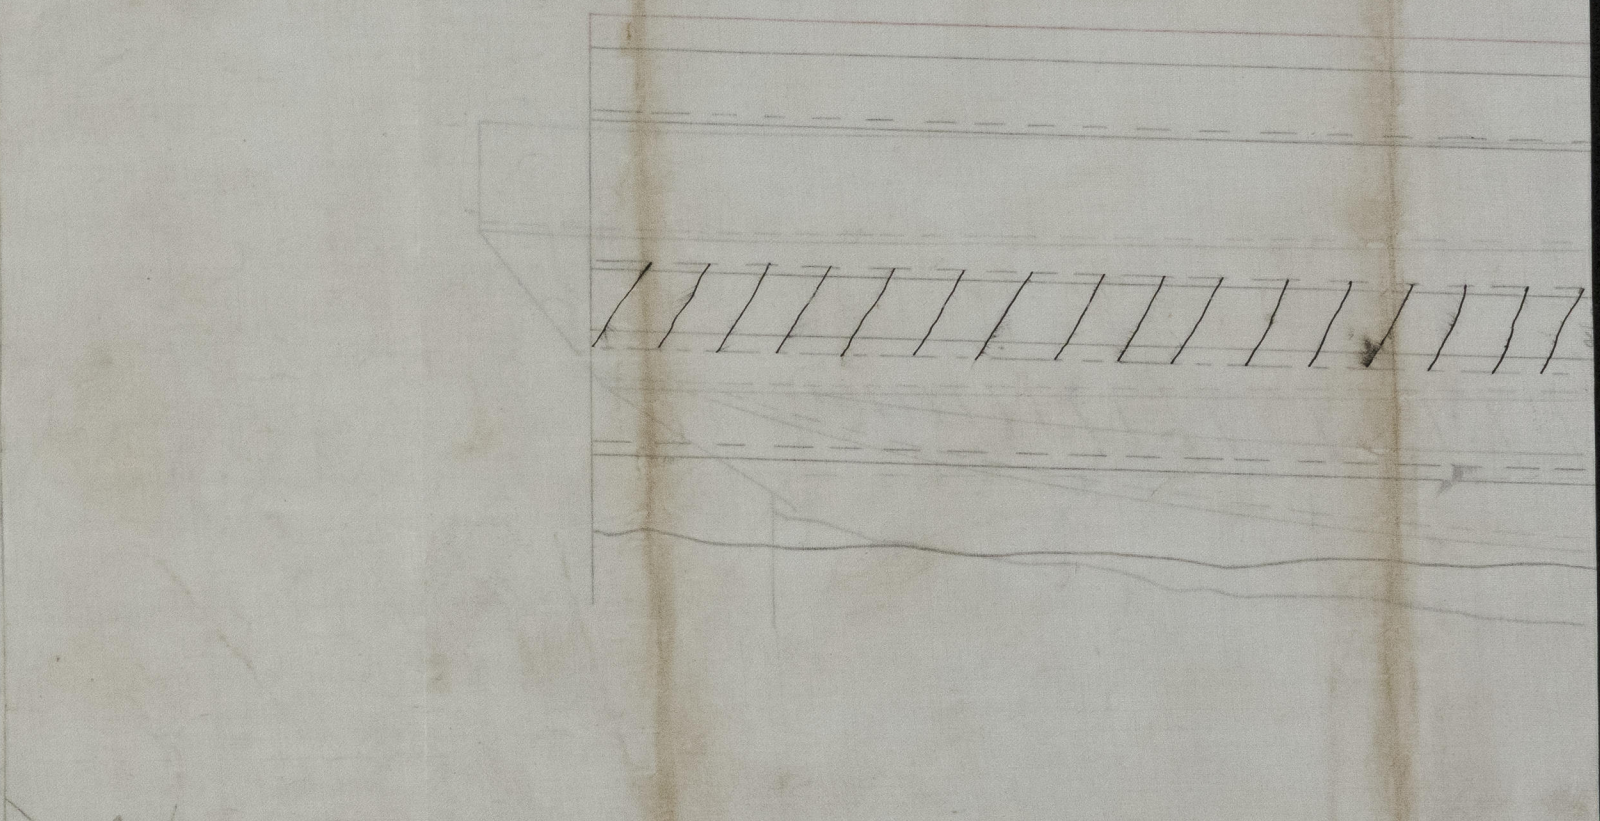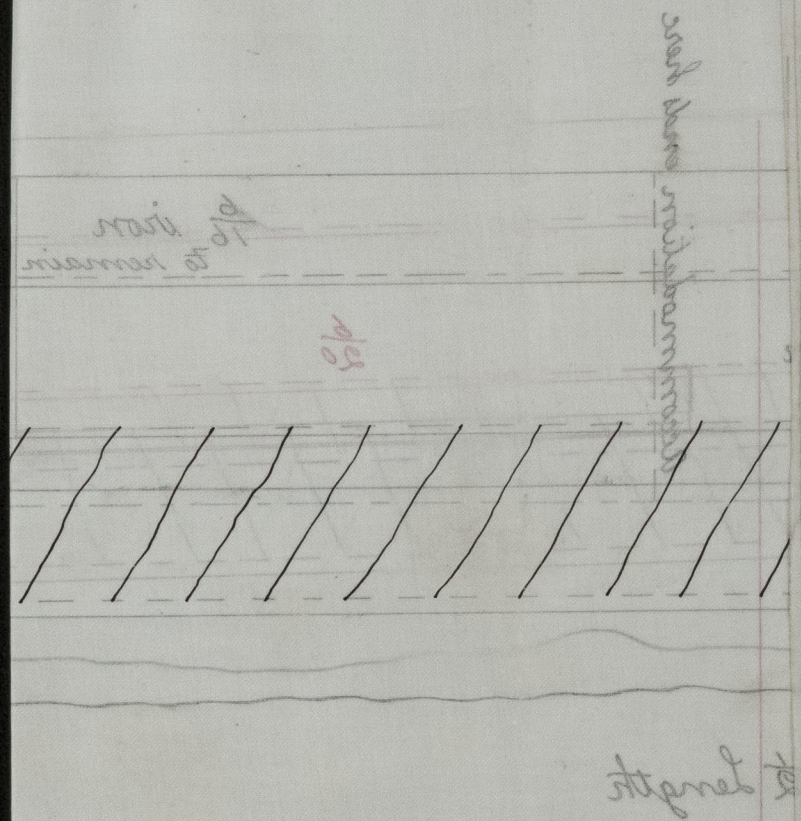

90/10
 10/10
 10/10