


Received at

Glasgow

Office,

29th Jan 1901

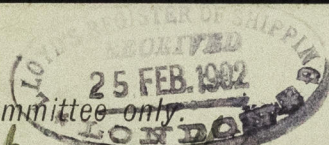

Lloyd's Register of British and Foreign Shipping.

(Report on Vessel No. 13245 Port

Glasgow

S.S. Gibraltar

No. 7844 SHIP FORGINGS OR CASTINGS.

I have to report that the undermentioned Iron or Steel Forgings or Castings, manufactured by The Portland Forge Coy of Kilmarnock for the Vessel No. 1480, being built by Mess Russell & Coy of Port Glasgow have been inspected by me as set forth below, and found to be, so far as can be seen, Sound & efficient

Mark on Forgings.

Lloyd's


No. 7844

W. H.

William Hamilton
Glasgow

	STERN FRAME.	RUDDER FRAME.	STEM.
Material*	Scrap iron		
How made	Forged		
Dimensions	114/6 1/2		
Progress on Inspection	Forging & smithing		
Date when Inspected	9/10/00 to 25/1/1901		

SKETCHES OF FRAMES SHOWING POSITION AND DESCRIPTION OF WELDS OF FORGINGS, OR PARTICULARS OF TESTS APPLIED TO CASTINGS.

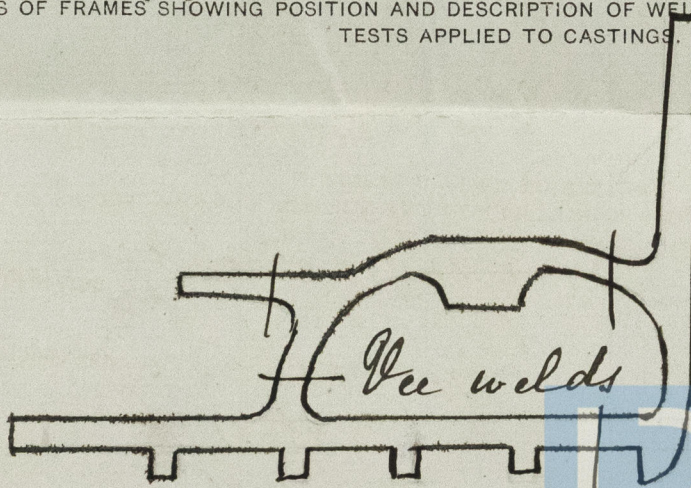

Fee (if any chargeable) £

To be paid at

© 2019

Lloyd's Register
Foundation