

S.P. 480-481

Midship Section


Drawn 345 x 49-9" ex. x 49-7" mld. x 28-5" mld. to Spar Deck

To class 100 A.1 at Lloyds Spar Deck Rule

Scale 1/2" = one foot

3.10.00
23.10.00

28/9/00

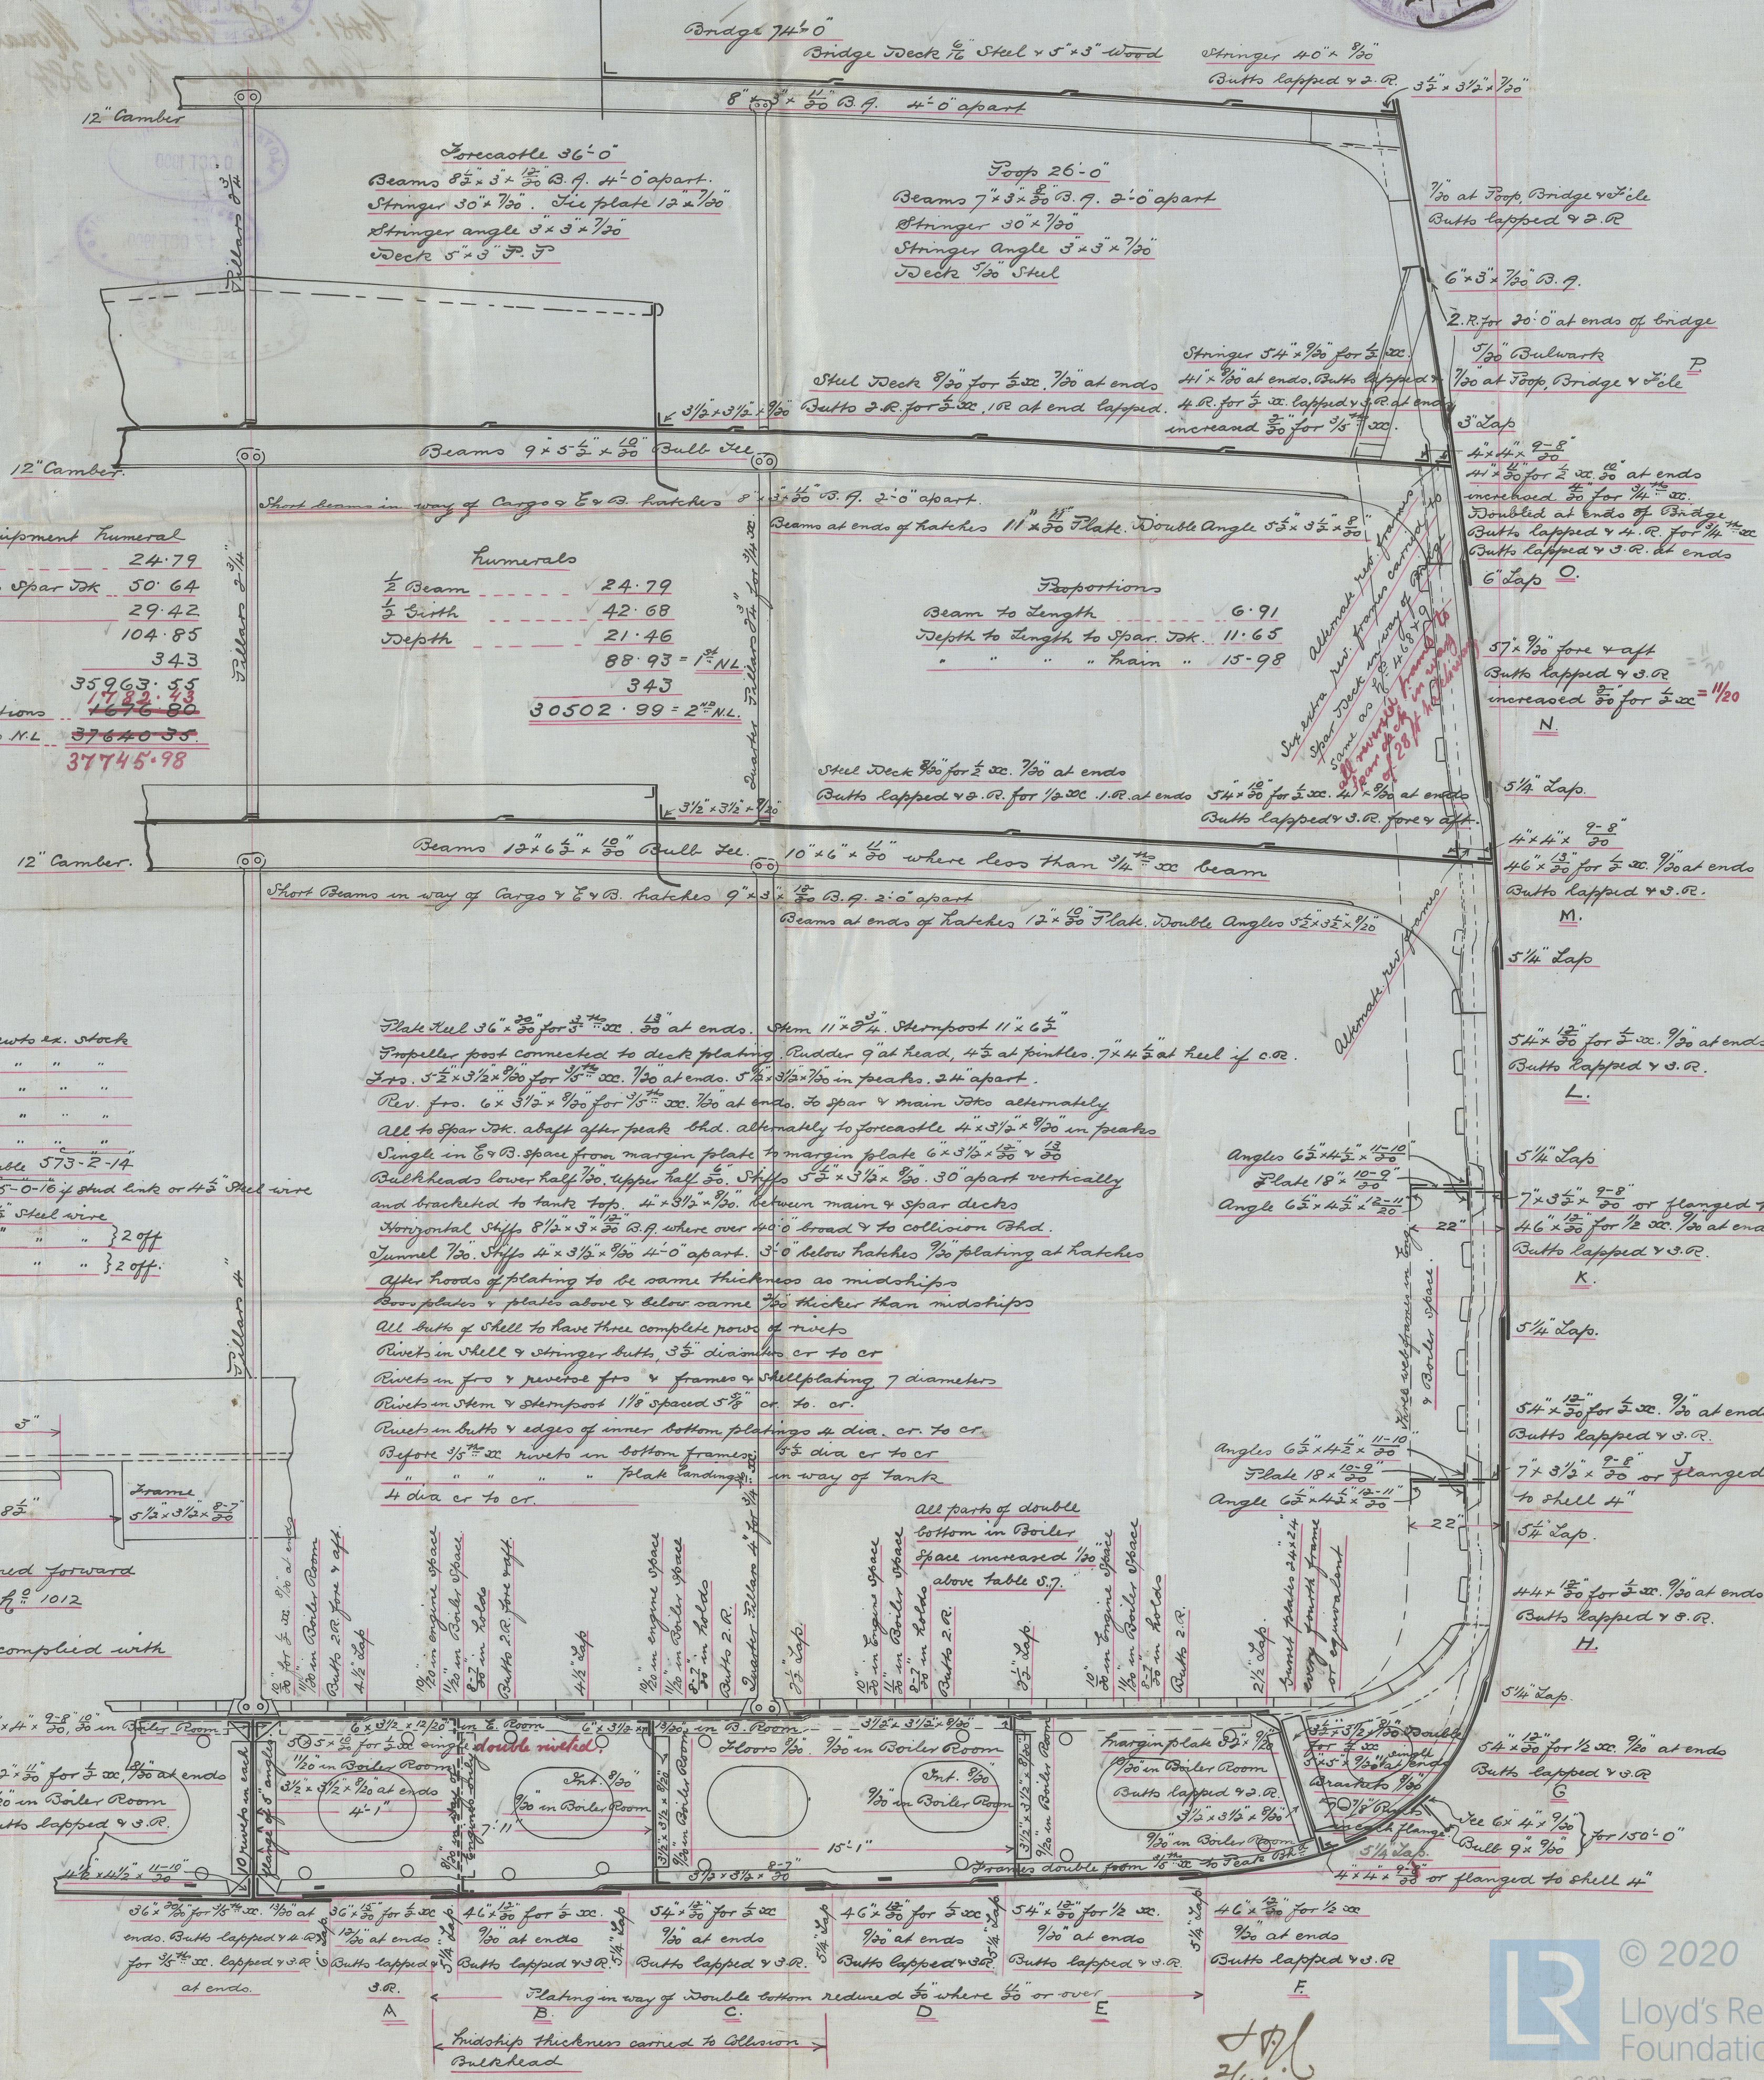

Equipment

1/2 Beam	24.79
1/2 Birth to Spar Deck	50.64
Depth	29.42
	104.85
	343
	35963.55
Erection	1676.82
Equip. N.L.	37640.35
	37745.98

Turnerals


1/2 Beam	24.79
1/2 Birth	42.68
Depth	21.46
	88.93 = 1" N.L.
	343
	30502.99 = 2" N.L.

Proportions

Beam to Length	6.91
Depth to Length to Spar. Deck	11.65
" " " " " " " "	15.98

Equipment

1 Bower Anchor	40 cwts ex. stock
1 " "	38 " " "
1 " "	36 " " "
1 Stream "	12 " " "
1 Hedge "	6 " " "
270 Fms. 2 1/2" Stud Chain Cable	573-2-14
90 " 1 1/2" Stream "	65-0-16 of Stud Link or 4 1/2" Steel wire
120 " 13" Towline or 4 1/2" Steel wire	
90 " 17" " " 2 1/2" " "	2 off
90 " 7" " " 2 1/2" " "	2 off

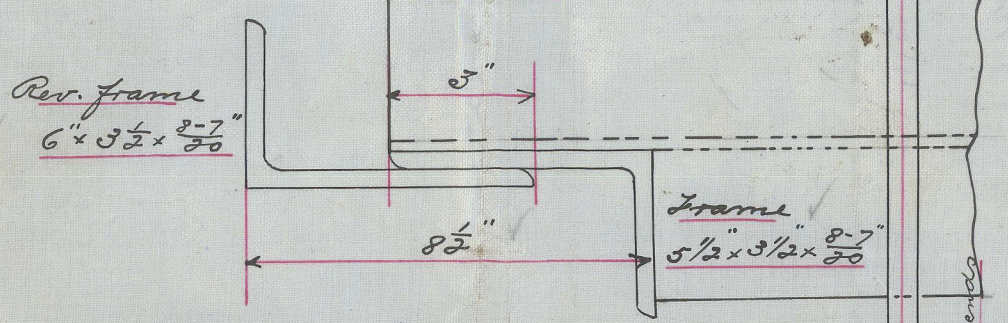

Bottom to be strengthened forward as per circular 1012
Circular 1026 to be complied with

Midship Section



Russell Ho^o No^o 480+481

~~7480~~ SS "Gibraltar"

GR report No 13245-

No 481: S.S. British Monarch

GR report No 13384

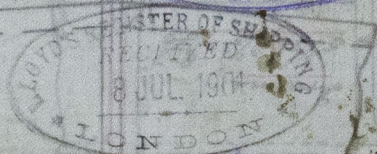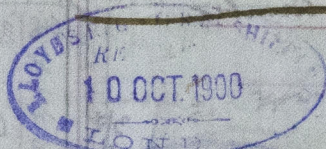

© 2020

Lloyd's Register
Foundation

GR4317-0157