

3. 10. 00
23. 10. 00


Longitudinal and Neck Plans

= S. S. 7th 480-1

Scale $\frac{1}{8}$ inch = one foot.



Fore & main masts 2 plates in the round. Butts lapped & 3 R. above Deck, 2 R. Below Deck. Seams lapped & single riveted

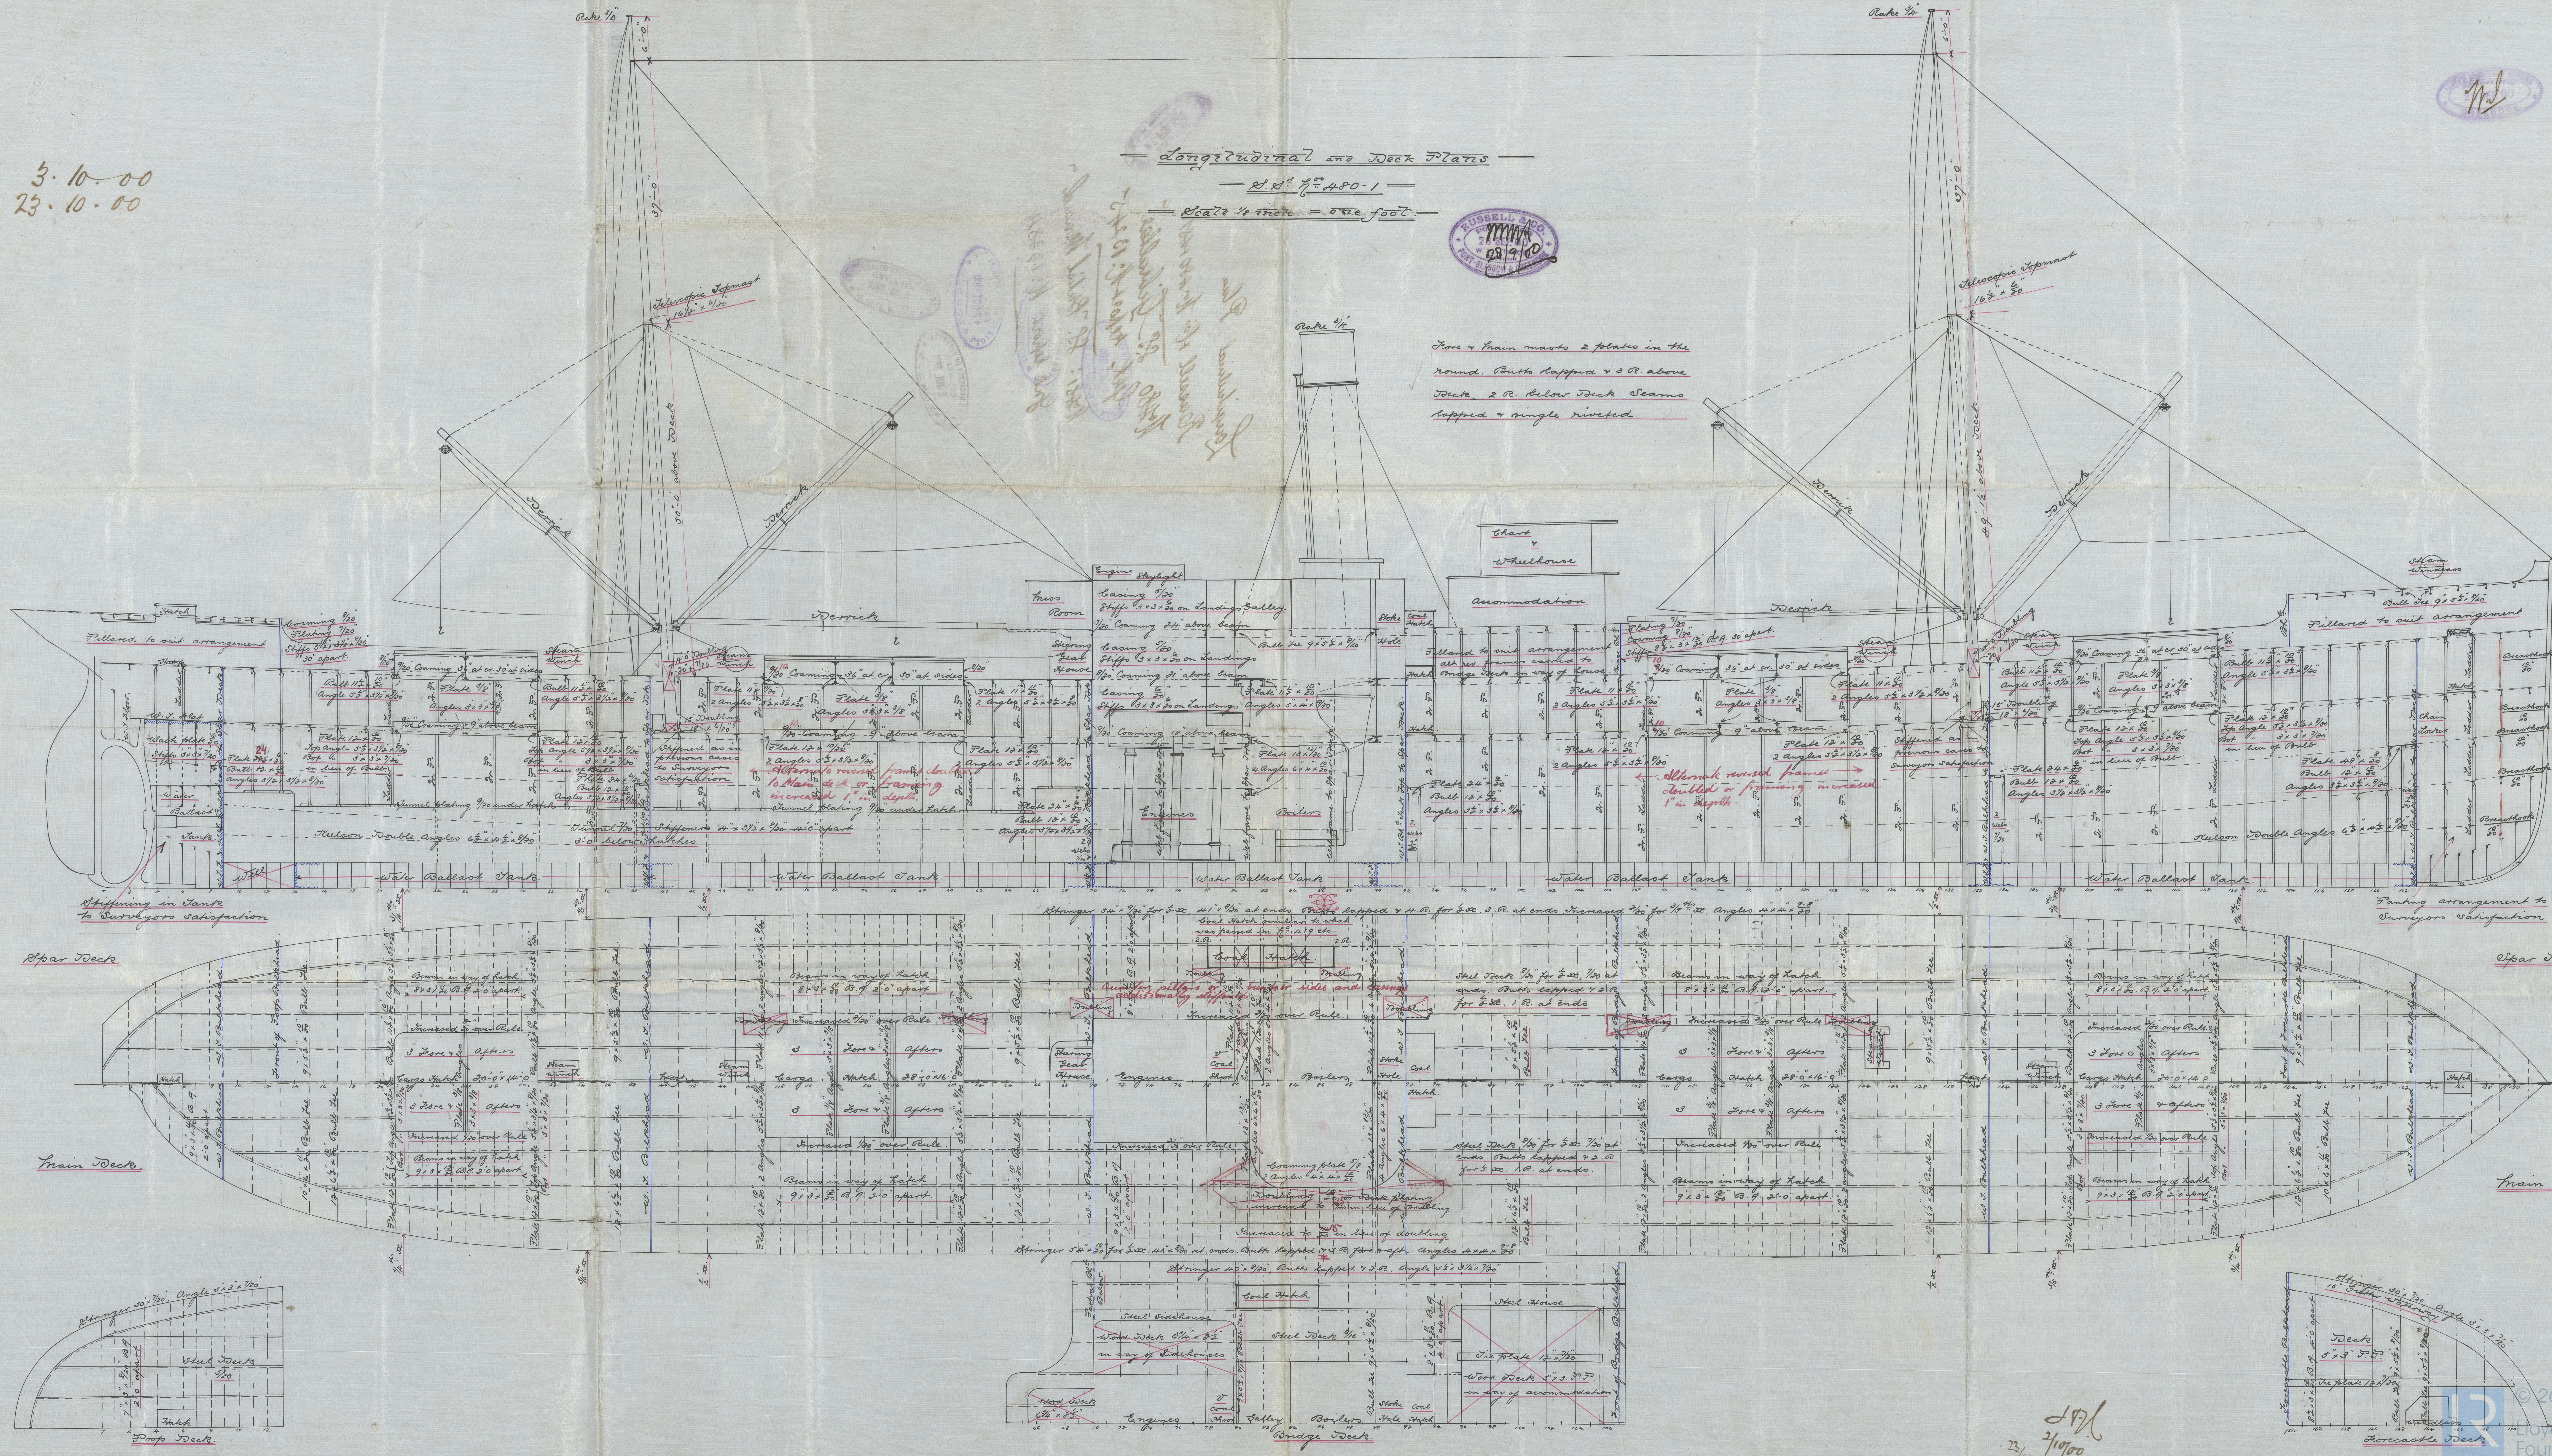

Longitudinal Plan




Russell Ho: No. 480 & 481

No. 480. S.S. "Gibraltar"

G.R. report No. 13245

No. 481: S.S. "British Monarch"

G.R. report No. 13384

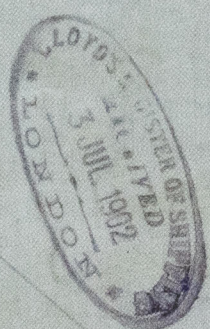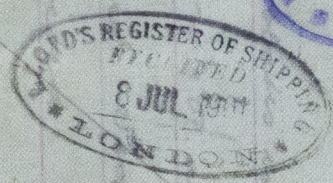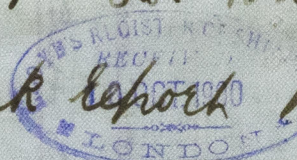

© 2020

Lloyd's Register Foundation

GRx317-0158